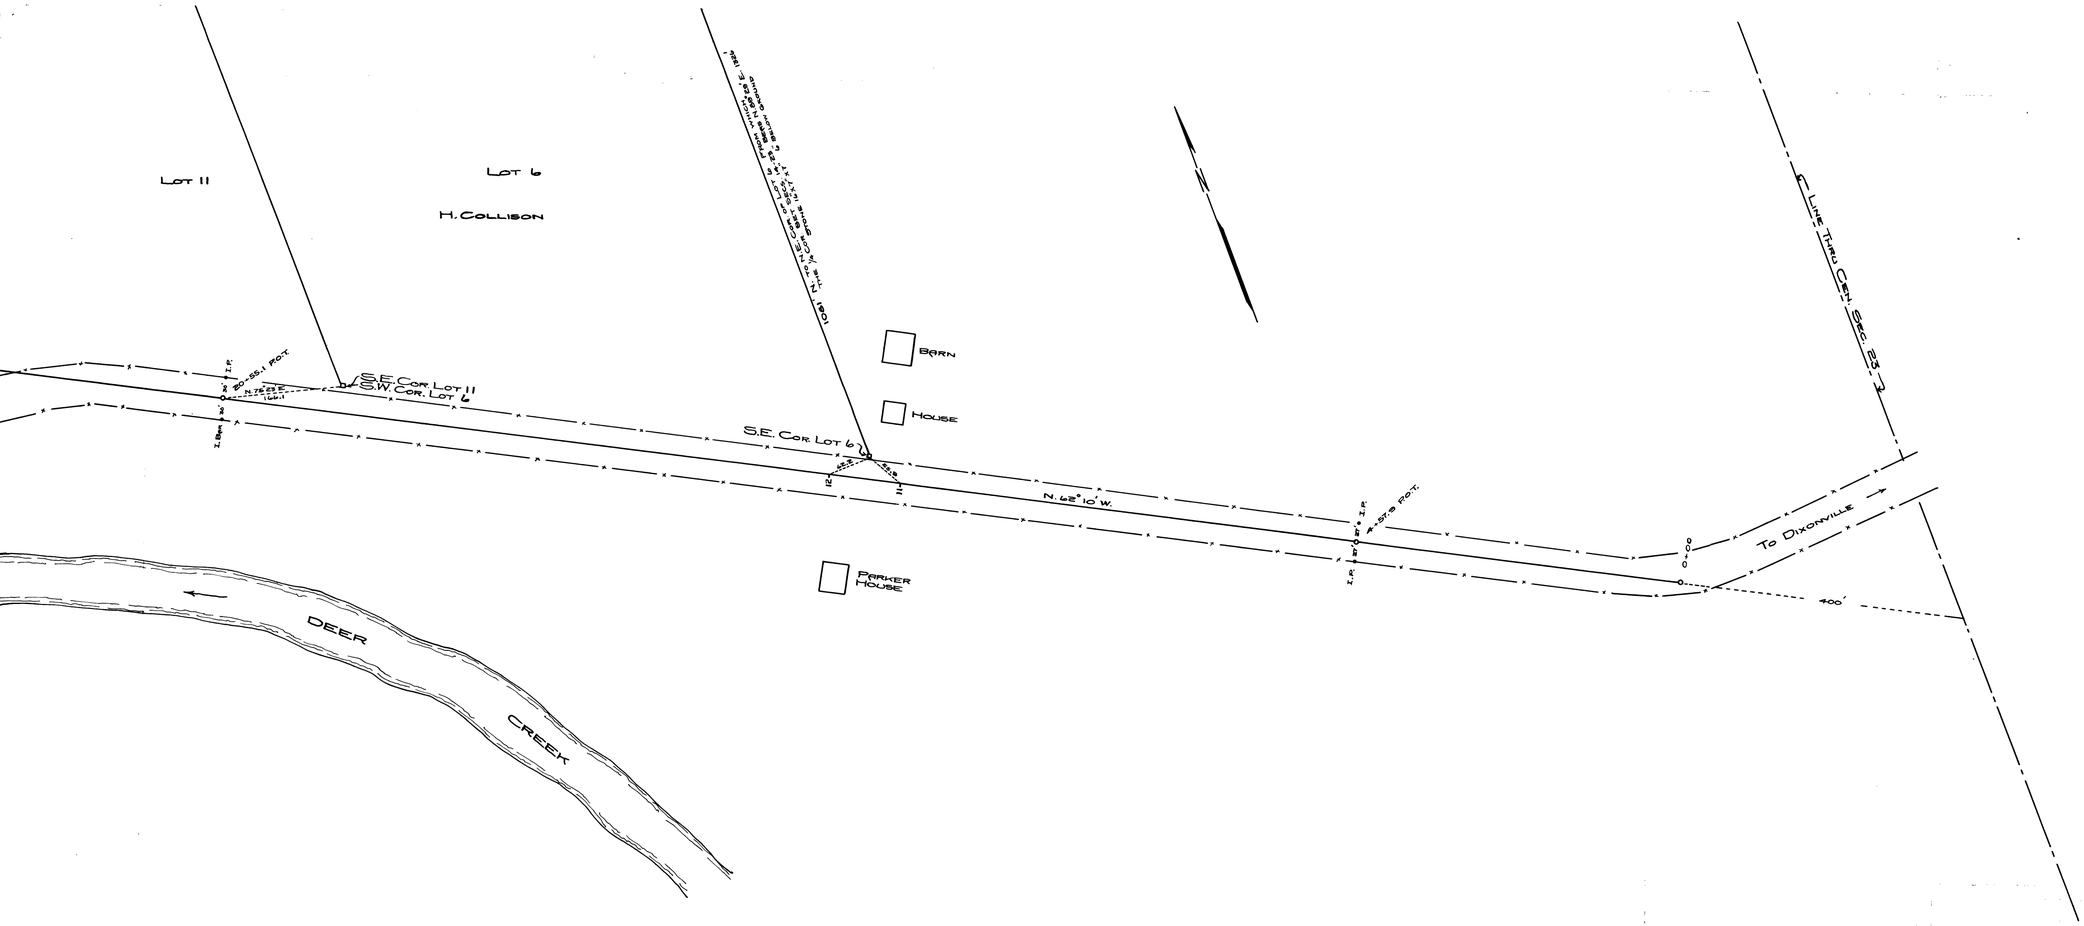

DOUGLAS COUNTY OREGON

NORTH UMPQUA RD. No 44

KINKAID SECTION

SEC. 15-22-23 T. 27 S., R. 5 W.

F. C. FREER, ROADMASTER.

1934 SHEET 1

ST138-18

Road No 44

~ M.P. 0.79

1934

Sht. 1 of 2

(18)

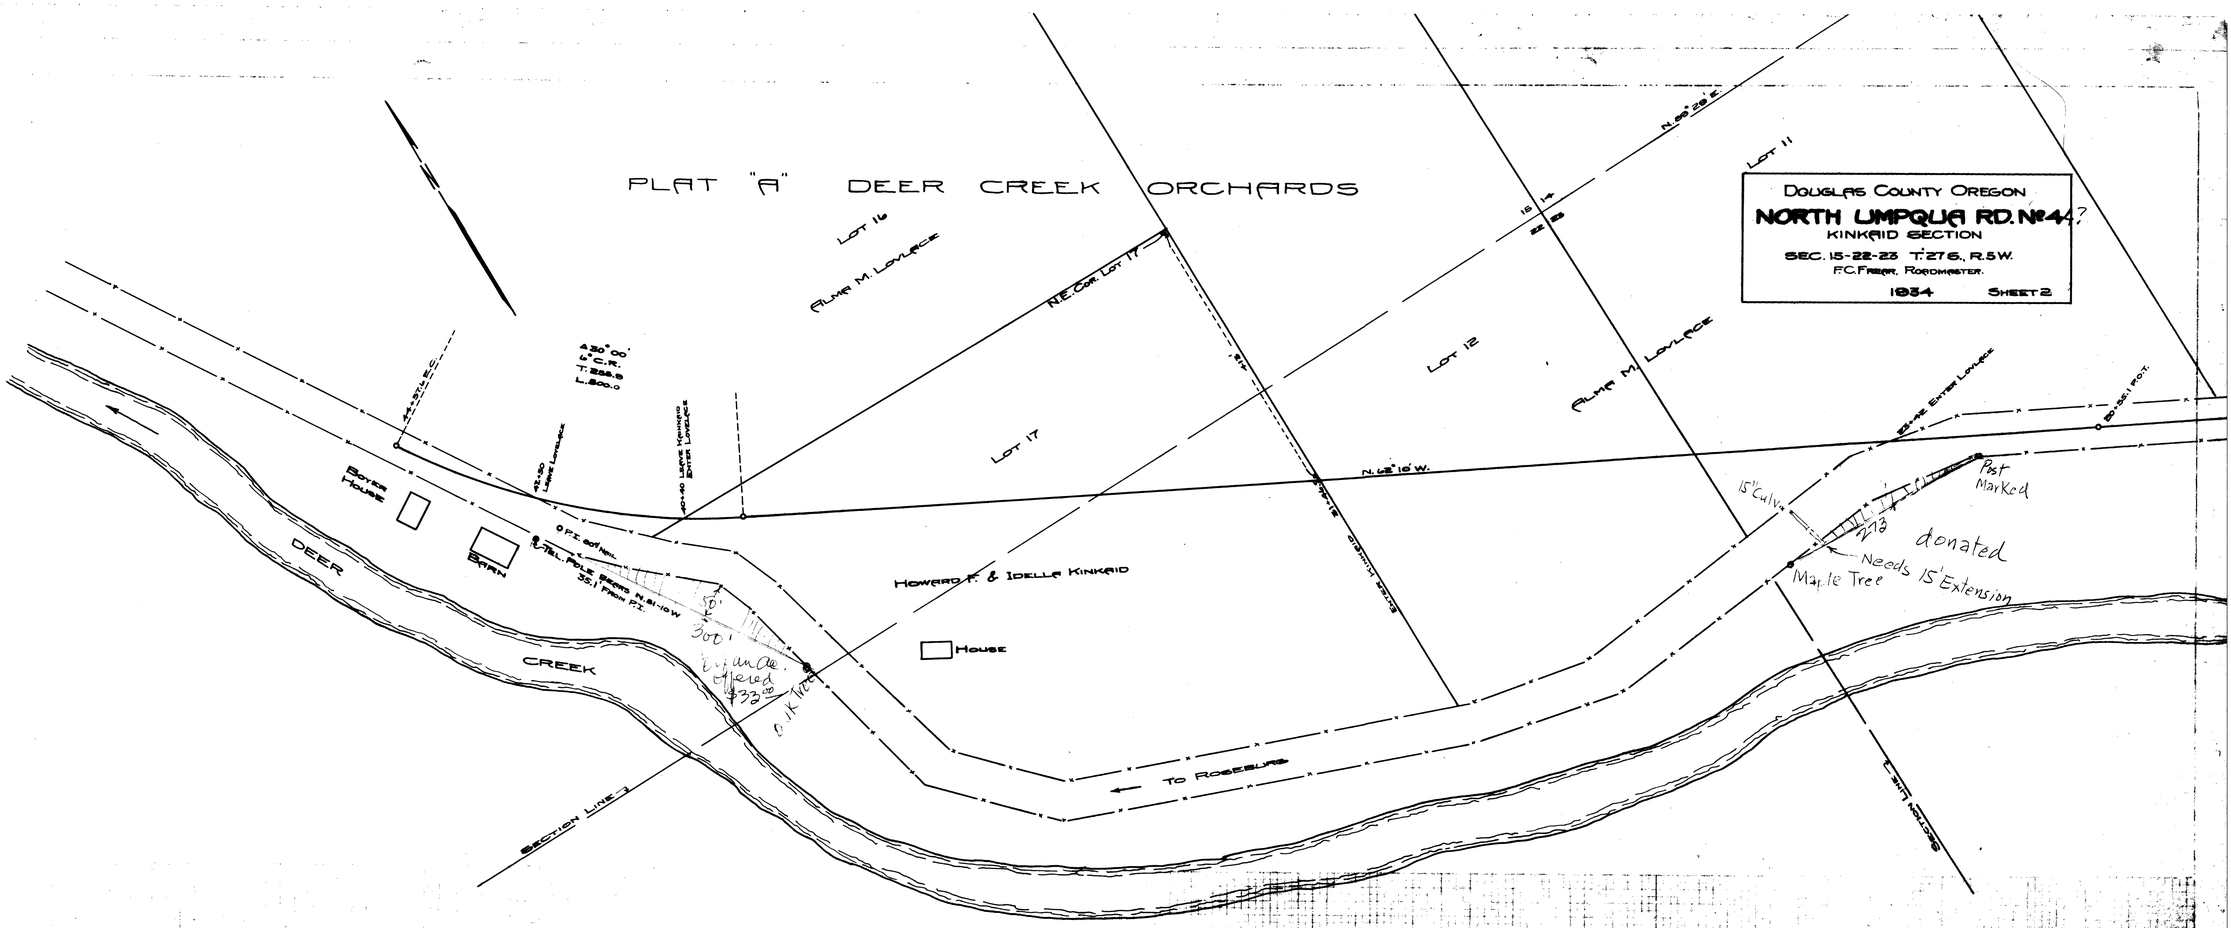

Road No 4.A.

~ M.P. 0.79

1934

Sht. 2 of 2