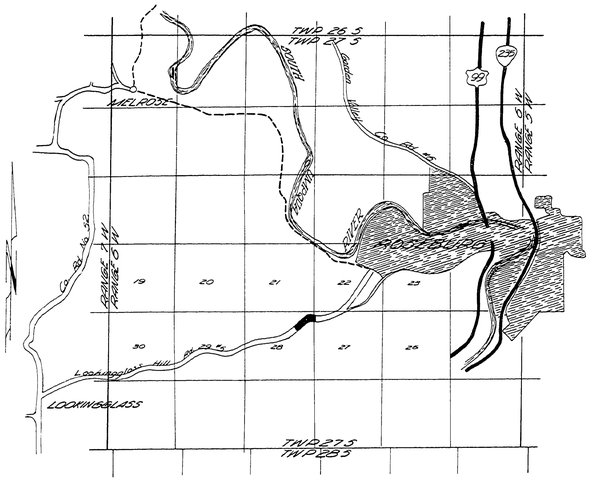

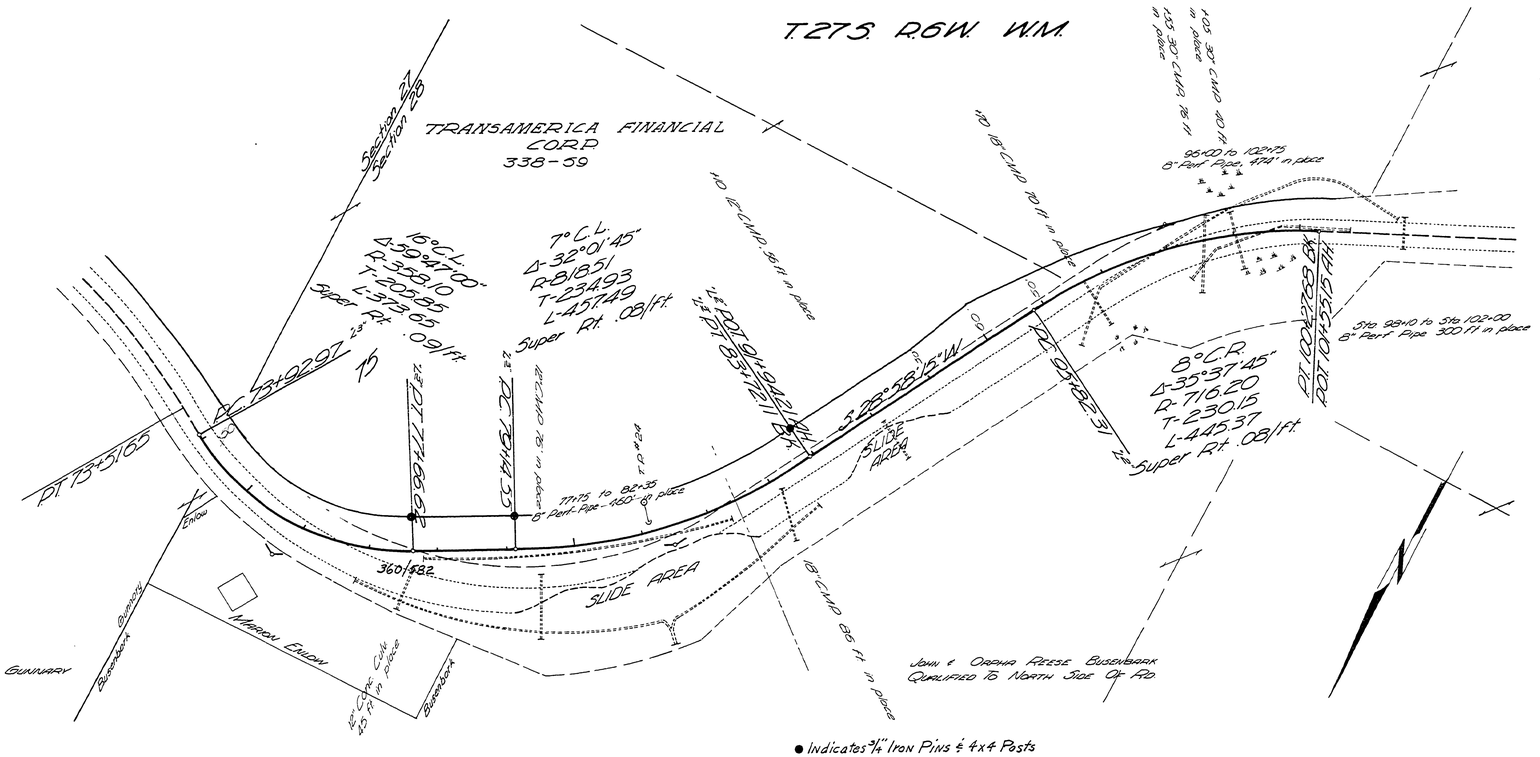
T.27S. R.6W. W.M.
TRANSAMERICA FINANCIAL
CORP.
338-59
Section 27
Section 28
16° C.L.
Δ-59°47'00"
R-358.10
T-205.85
L-372.65
Super Rt. .09/ft.
7° C.L.
Δ-32°01'45"
R-818.51
T-234.93
L-457.49
Super Rt. .08/ft.
8° C.R.
Δ-35°37'45"
R-716.20
T-230.15
L-445.37
Super Rt. .08/ft.
PC 73+92.97
PT 75+51.65
PC 77+86.62
PC 79+44.35
PC 97+82.31
PT 100+27.68
PT 104+73.68
PC 77+75 to 82+35
8" Perf. Pipe - 160' in place
96+00 to 102+75
8" Perf. Pipe, 475' in place
Sta 98+10 to Sta 102+00
8" Perf. Pipe 300 ft in place
SLIDE AREA
SLIDE AREA
360/582
Marion Enlow
Hubert & Gladys Gunnary
John & Orpha Reese Busenbark
Qualified To North Side Of Rd.
18" CMP 70 ft in place
