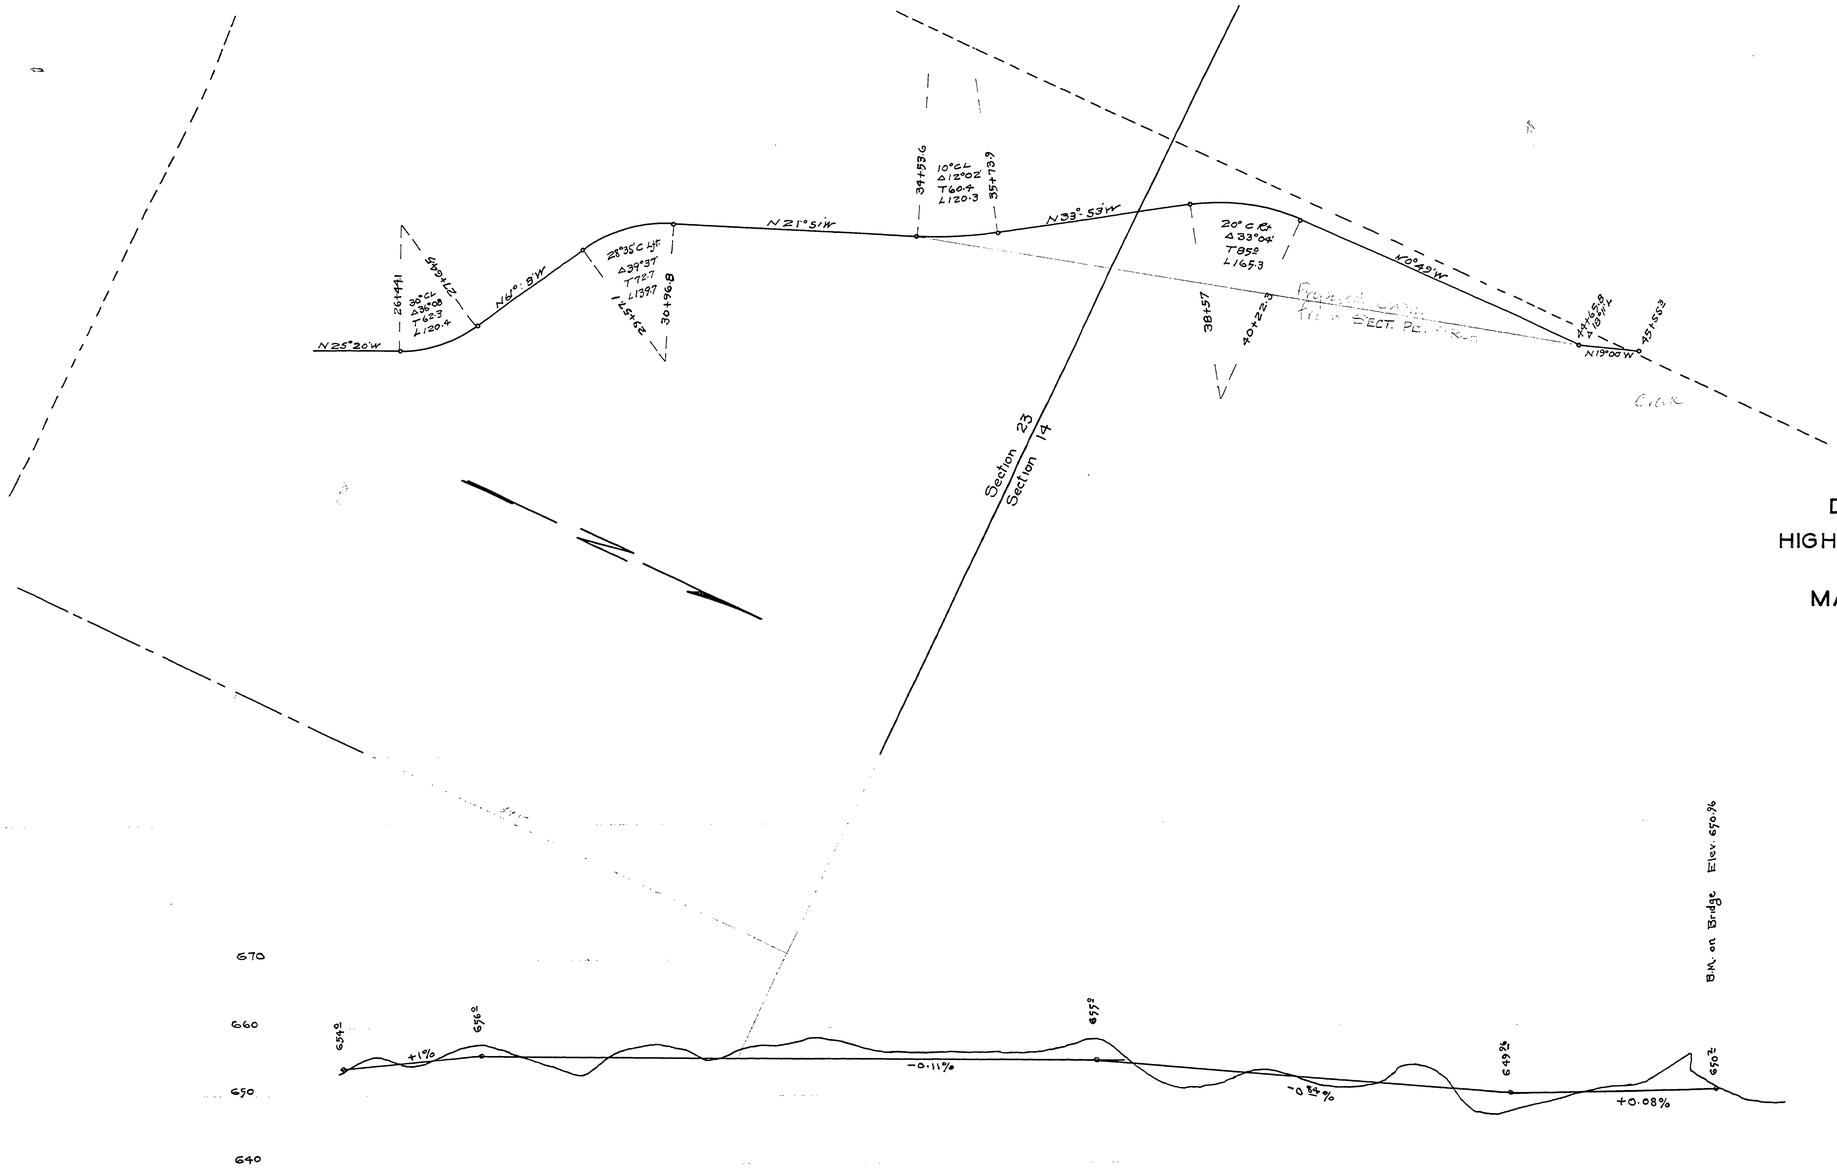

DOUGLAS COUNTY

HIGHWAY IMPROVEMENT

SEC. T. 28 S. R. 8 W. W.M.

MARKET ROAD NO. 5

GURNEY SECTION

F. C. FREAR CO. ENGR.

JAN. 1924

Sheet No 2 from Roston.

Road No 5

15901554

2 OF 1