


Deed Mrs. E. L. Bushnell
 40' Right of way St. 892+33 to St. 912+32.3
 Consideration \$300.00
 Road Record 8 Page 463
 Deed Record 92 Page 188

DOUGLAS COUNTY OREGON
 BUSHNELL SECTION
MARKET ROAD NO 5
 SECTION 24-25 T. 28 S. R. 8 W.
 F.C. FREAR, CO. ROADMASTER.
 1930
 SHEET 6

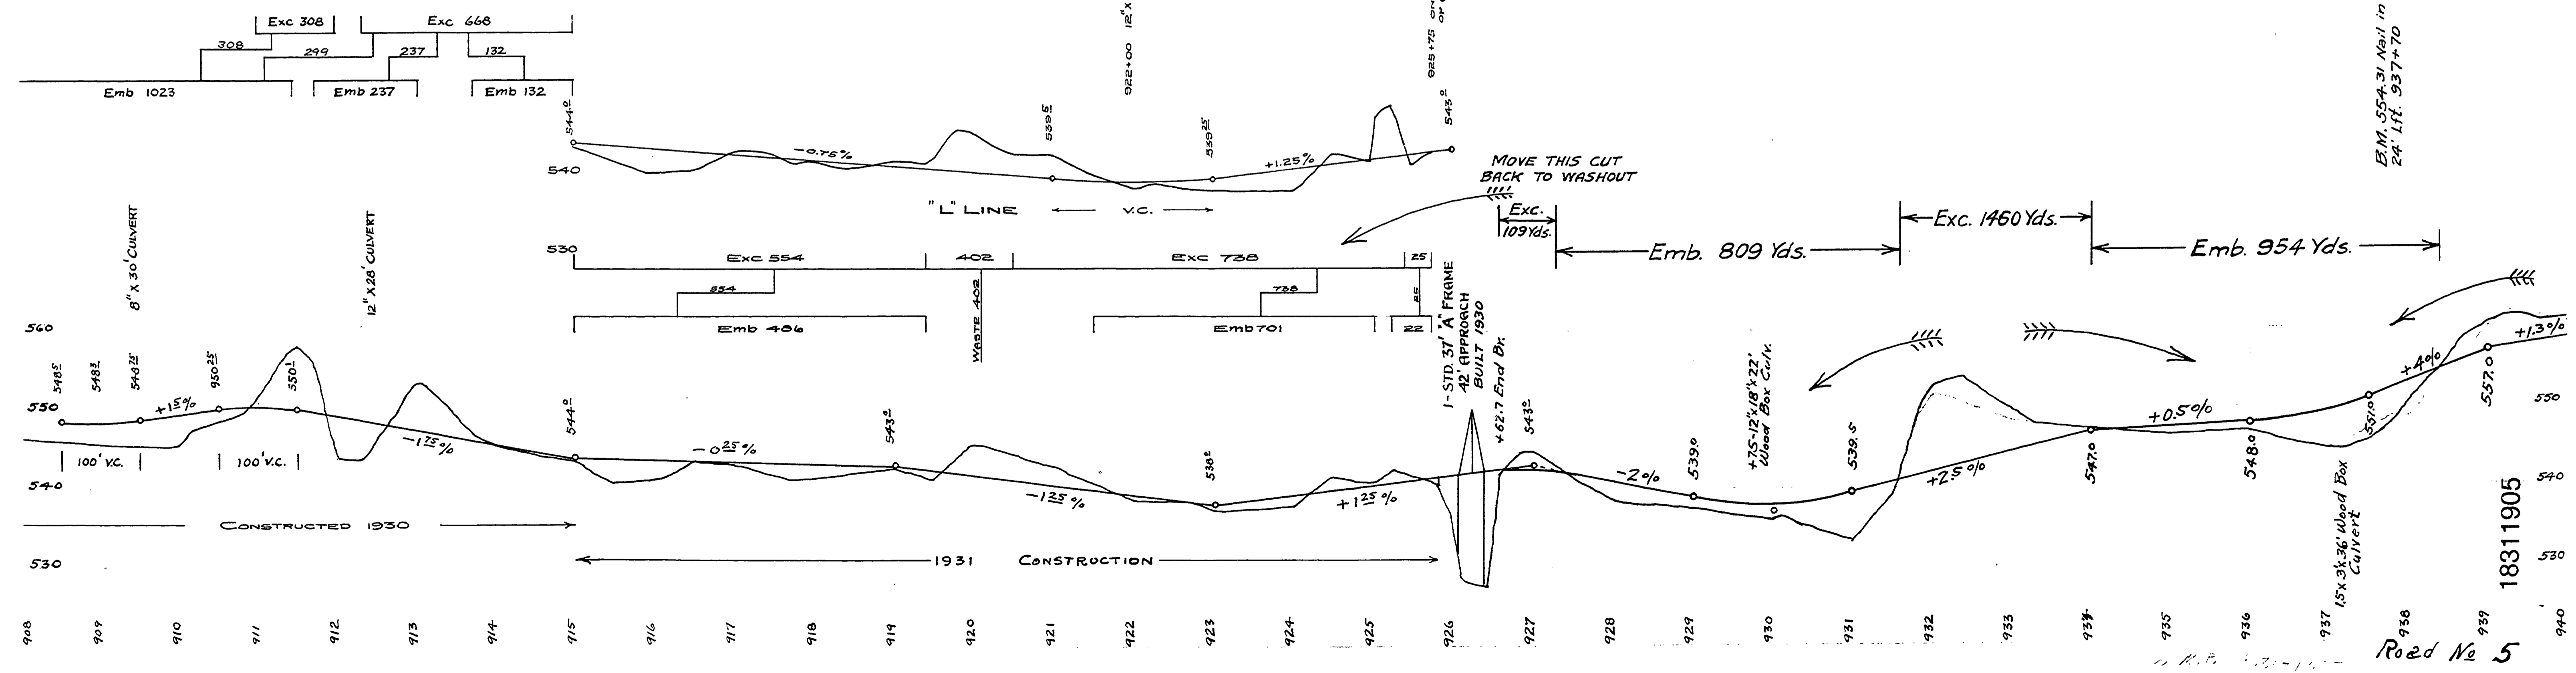

24' aft. 937+70

Road No 5