


# CITY OF ROSEBURG

## GARDEN VALLEY BLVD. IMPROVEMENTS PHASE 1 PROJECT NO. 02UR03 DOUGLAS COUNTY, OREGON

AUGUST 2002

SHEET INDEX

SHEET NO.	DESCRIPTION	FILE NO.
1	VICINITY MAP AND TITLE SHEET	2784C1.0D
2	ROADWAY PLAN STA 11+48 TO STA 15+25	2784C1.1D
3	ROADWAY PLAN STA 15+25 TO STA 17+57	2784C1.2D
4	PAVEMENT MARKING PLAN AND MISC. DETAILS	2784C1.3D
5	PROFILES STA 11+48 TO STA 17+57	2784C1.4D

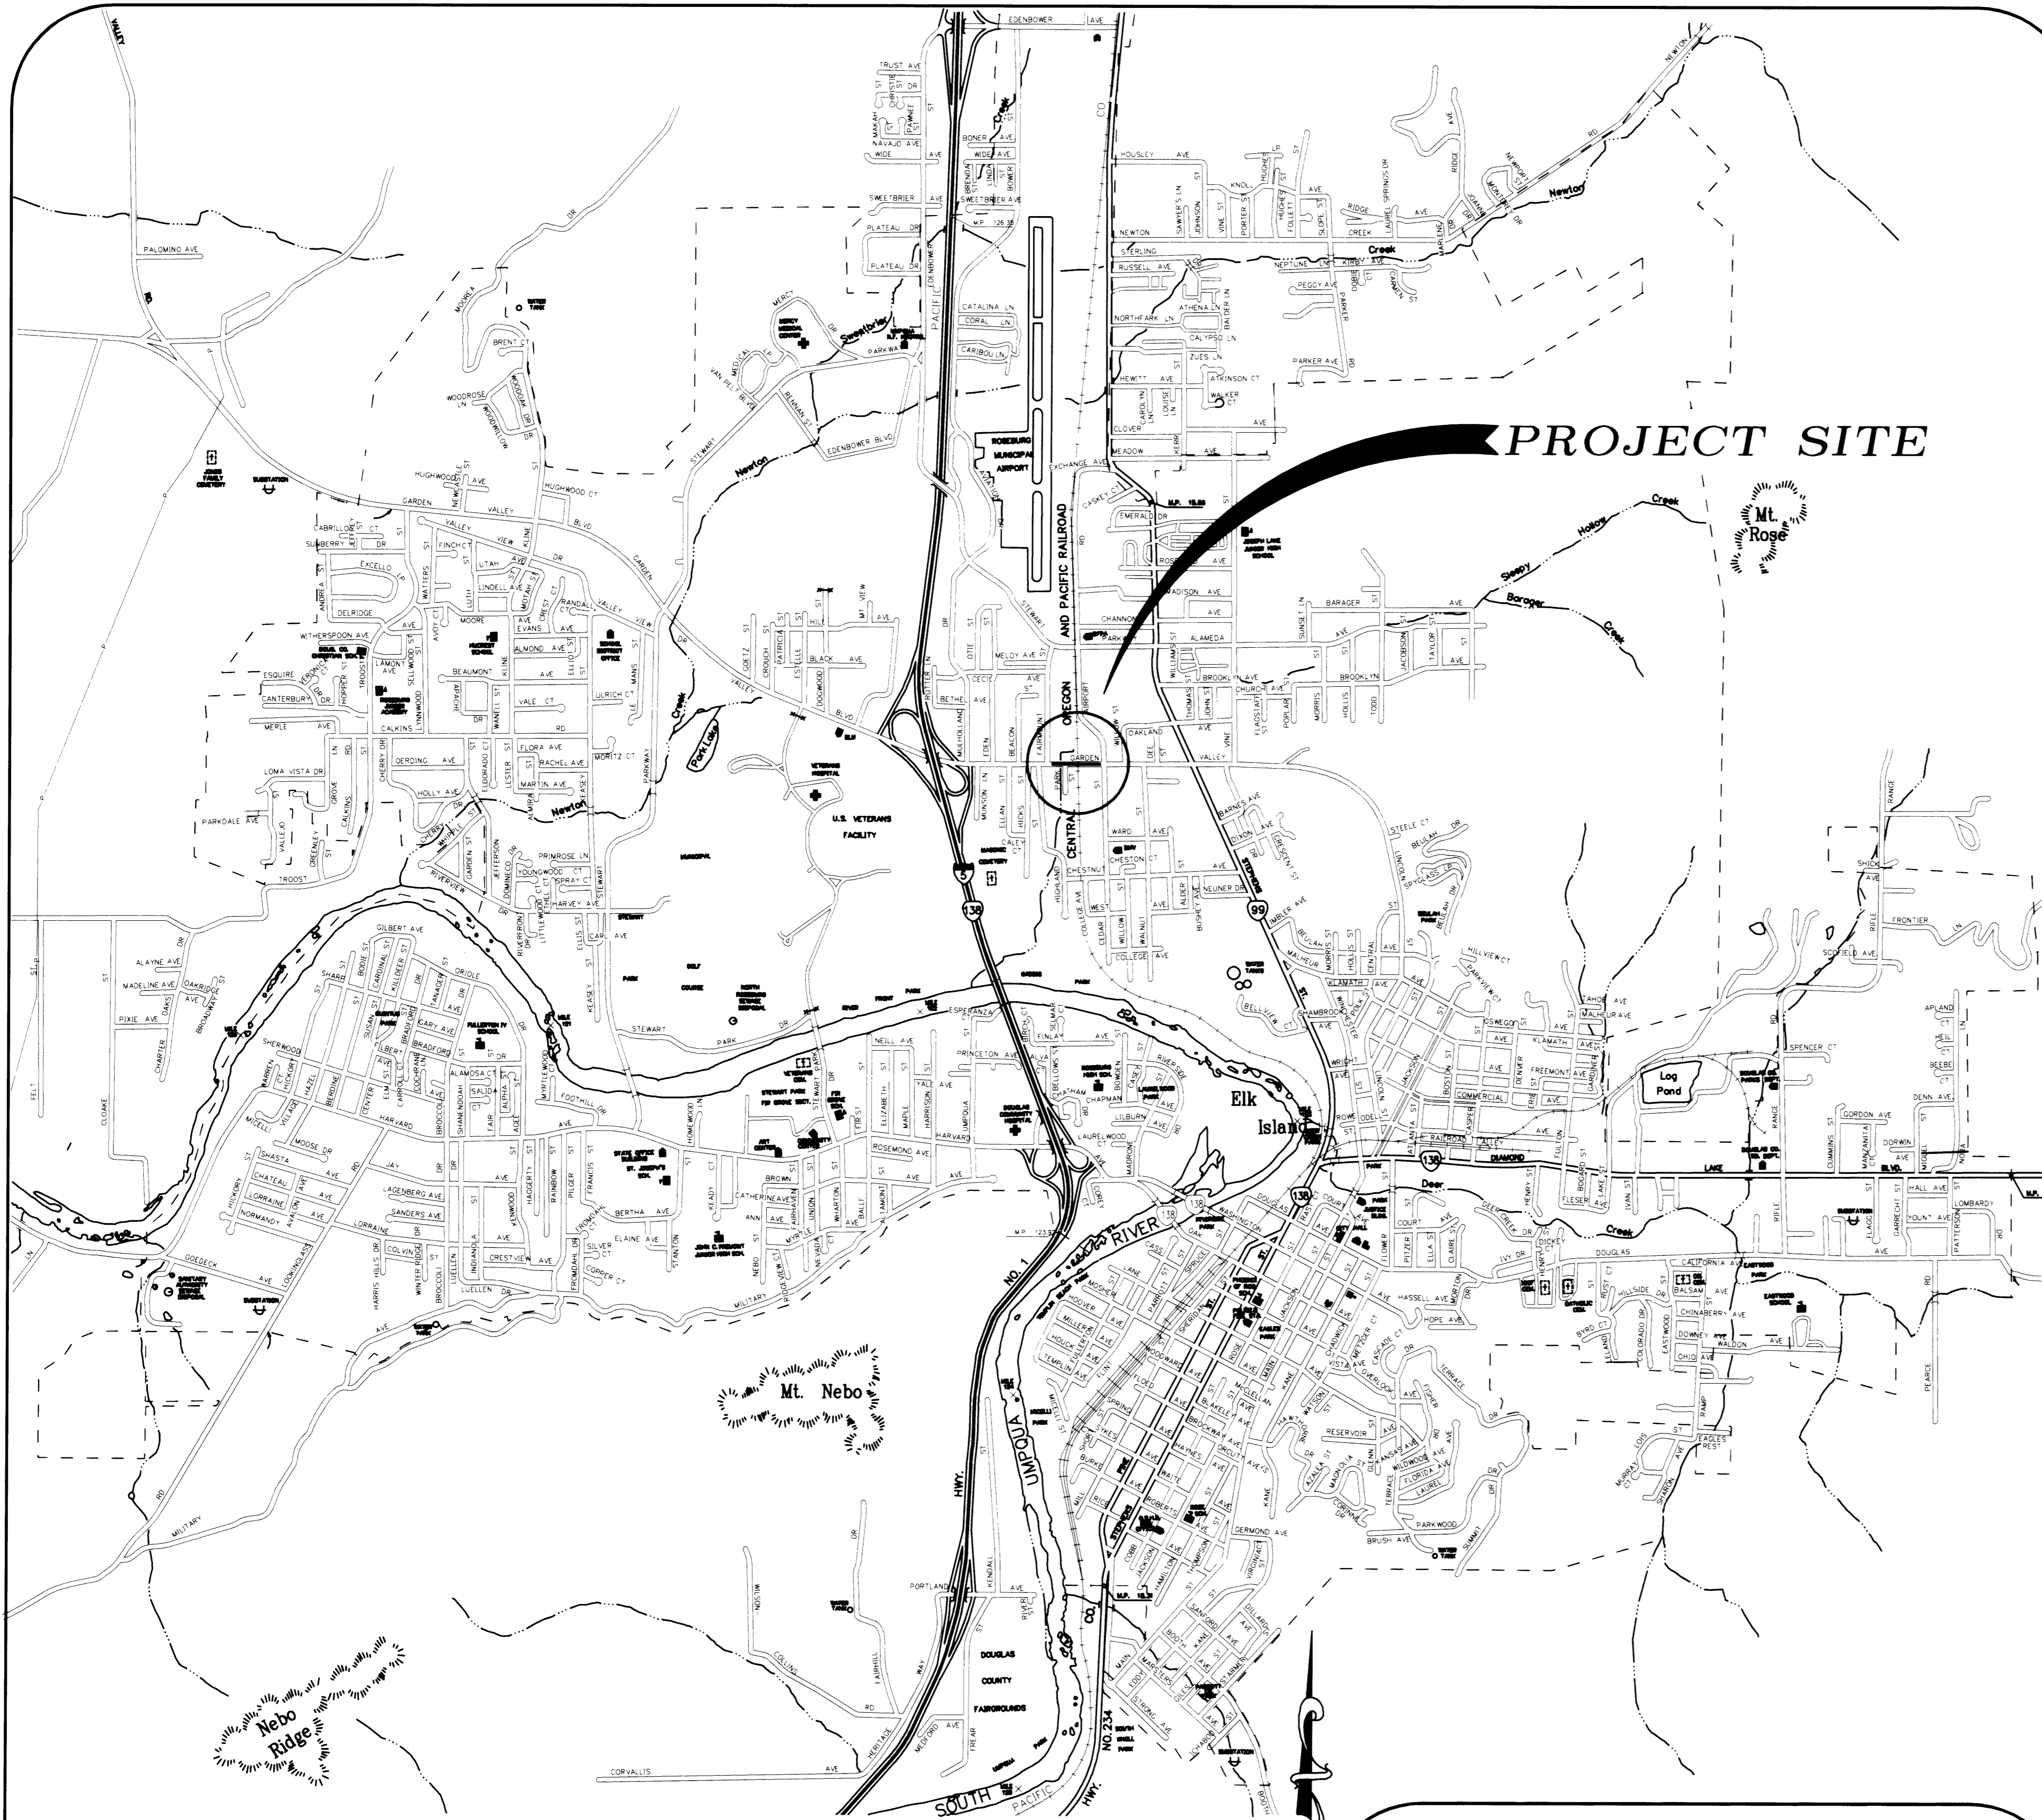

**ROSEBURG AND VICINITY**  
DOUGLAS COUNTY, OREGON



**CALL BEFORE YOU DIG!**  
ONE CALL: 1-800-332-2344

ATTENTION: Oregon law requires you to follow rules adopted by the Oregon Utility Notification Center. Those rules are set forth in OAR 952-001-0010 through OAR 952-001-0090. You may obtain copies of the rules by calling the center. (Note: the telephone number for the Oregon Utility Notification Center is (503) 232-1987).

PREPARED BY:  
**LEE ENGINEERING, INC.**  
CONSULTING ENGINEERS  
1300 JOHN ADAMS STREET  
OREGON CITY, OREGON 97045  
(503) 655-1342



DRAWINGS OF RECORD