


\* EXCEPT AS SHOWN ON PLANS

**THICKENED SIDEWALK EDGE**

**CURBSIDE SIDEWALK**

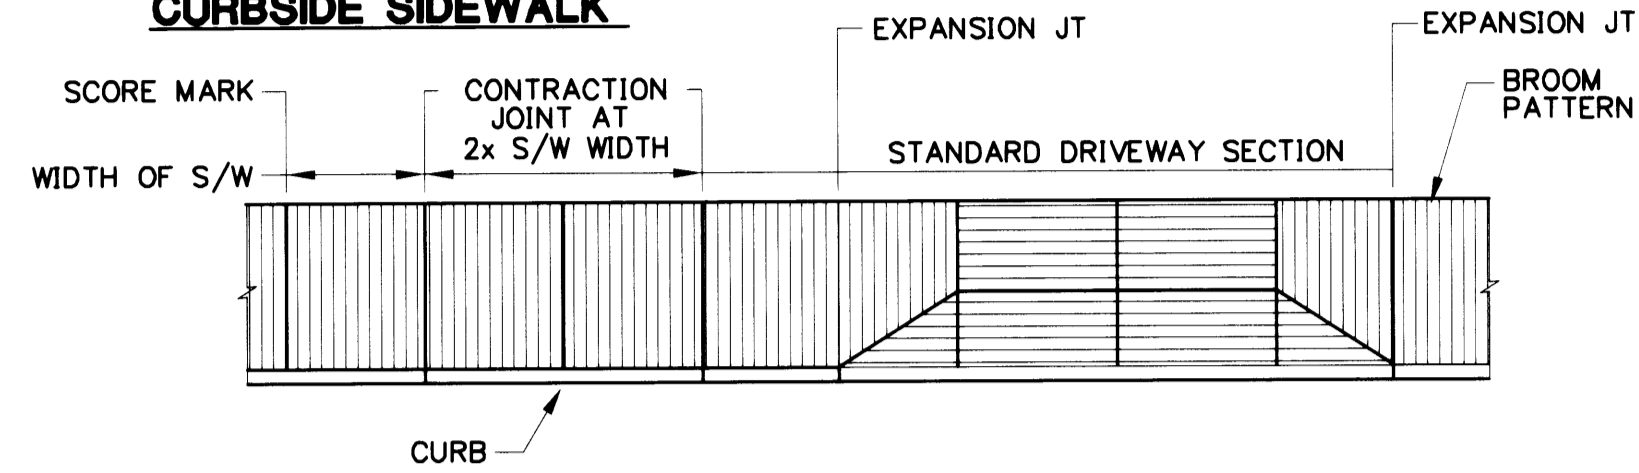



**NOTES**

- 1) CONCRETE USED IN SIDEWALKS SHALL HAVE A 28 DAY ULTIMATE COMPRESSIVE STRENGTH OF 3,300 PSI.
- 2) ALL RADII SHALL BE 3/4" (20mm) UNLESS OTHERWISE SHOWN.
- 3) ISOLATION JOINTS (FELT EXPANSION JOINTS) SHALL BE PLACED AT 45' INTERVALS.
- 4) CONTRACTION JOINTS SHALL BE PLACED AT 15' MAX. INTERVALS AND SHALL EXTEND THROUGH THE CURB OR CURB & GUTTER EVERY OTHER ONE.
- 5) 3" (75mm) DIAMETER WEEPHOLES ARE REQUIRED FROM BACK OF SIDEWALK TO FACE OF CURB AT ALL DOWNSPOUTS, DRAINS OR TWO PER LOT. A CONTRACTION JOINT SHALL BE PLACED OVER AND ALONG EACH WEEP HOLE.
- 6) SIDEWALK ACCESS RAMPS ARE REQUIRED AT ALL STREET CORNERS AND AS OTHERWISE DIRECTED.

MINIMUM CURB RETURN RADIUS  
RESIDENTIAL = 25' (7.6m)  
COMMERCIAL = 40' (12.2m)

**1 SIDEWALK STANDARDS**

C1.2 N.T.S.

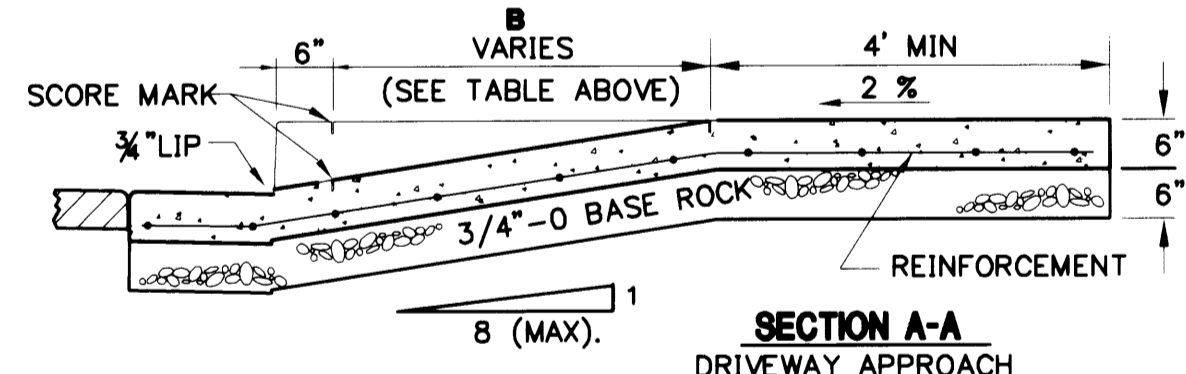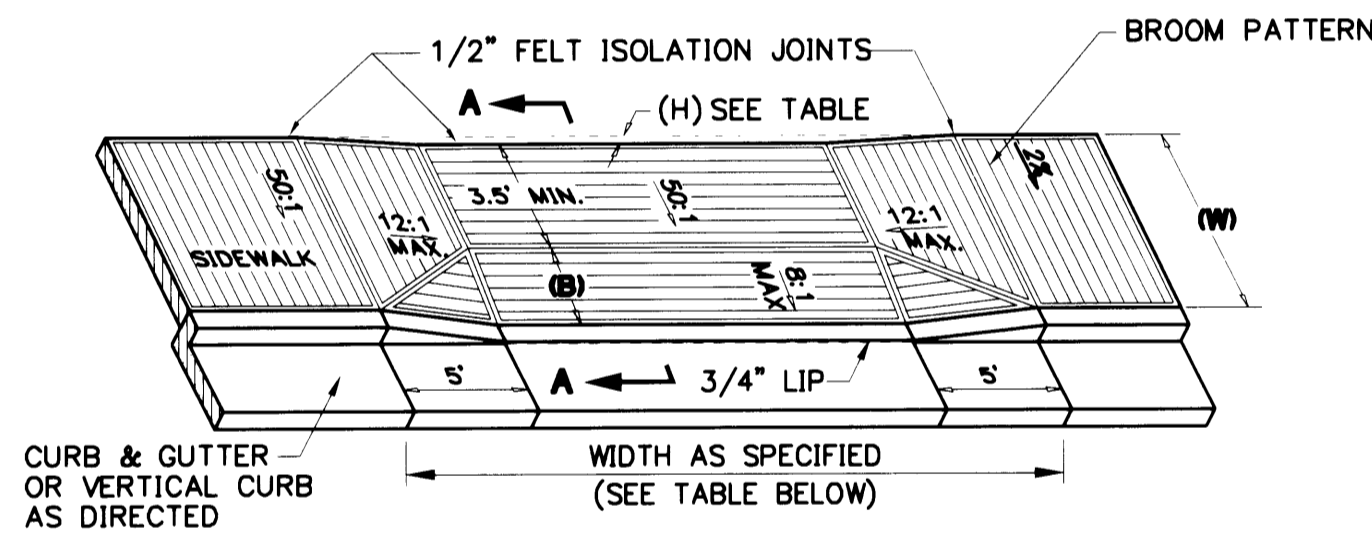

**SECTION A-A**

DRIVEWAY APPROACH

**NOTES**


1. DRIVEWAYS AND SIDEWALK SECTIONS THROUGH DRIVEWAYS SHALL HAVE A MINIMUM NOMINAL THICKNESS OF 6".
2. CONCRETE FOR COMMERCIAL USE AND ALLEY APPROACHES SHALL HAVE A MINIMUM ULTIMATE COMPRESSIVE STRENGTH OF 4,000 PSI. OTHER DRIVEWAYS SHALL MEET STANDARD SPECIFICATION FOR NON-STRUCTURAL CONCRETE OF 3300 PSI.
3. CURB TRANSITIONS FOR DRIVEWAY APPROACHES SHALL BE 5 FEET.
4. REINFORCEMENT SHALL BE #4 REBAR AT 12" O.C. EACH WAY
5. IN SOME AREAS, 2" (50 mm) OF SAND MAY BE USED AS BASE WITH WRITTEN APPROVAL OF CITY PUBLIC WORKS DEPARTMENT.
6. 2% SLOPE (50:1) EQUALS 1/4" PER FOOT OR 20mm/m. 12.5% SLOPE (8:1) EQUALS 1 1/2" PER FOOT OR 125mm/m.
7. THE 50:1 CROSS-SLOPE OF SIDEWALK IS MEASURED FROM HORIZONTAL. THE 12:1 SLOPE OF SIDEWALK TRANSITION TO DRIVEWAY/ALLEY IS RELATIVE TO THE RUNNING SLOPE OF THE SIDEWALK. THE SLOPE OF THE APRON IS MEASURED RELATIVE TO HORIZONTAL.

W	B	H
6'	2'	0.29' (3-1/2")
7'	3'	0.19' (2-1/4")
8'	4'	0.08' (1")

PROPERTY	MAX. WIDTH	MIN. WIDTH	MAX. % OF FRONTAGE
RESIDENTIAL	32'(10m)	22'(6.7m)	40%
PROFESSIONAL	32'(10m)	22'(6.7m)	50%
COMMERCIAL	49'(15m)	22'(6.7m)	60%
INDUSTRIAL	49'(15m)	22'(6.7m)	50%


**2 TYP. DRIVEWAY APPROACH**

C1.2 N.T.S.

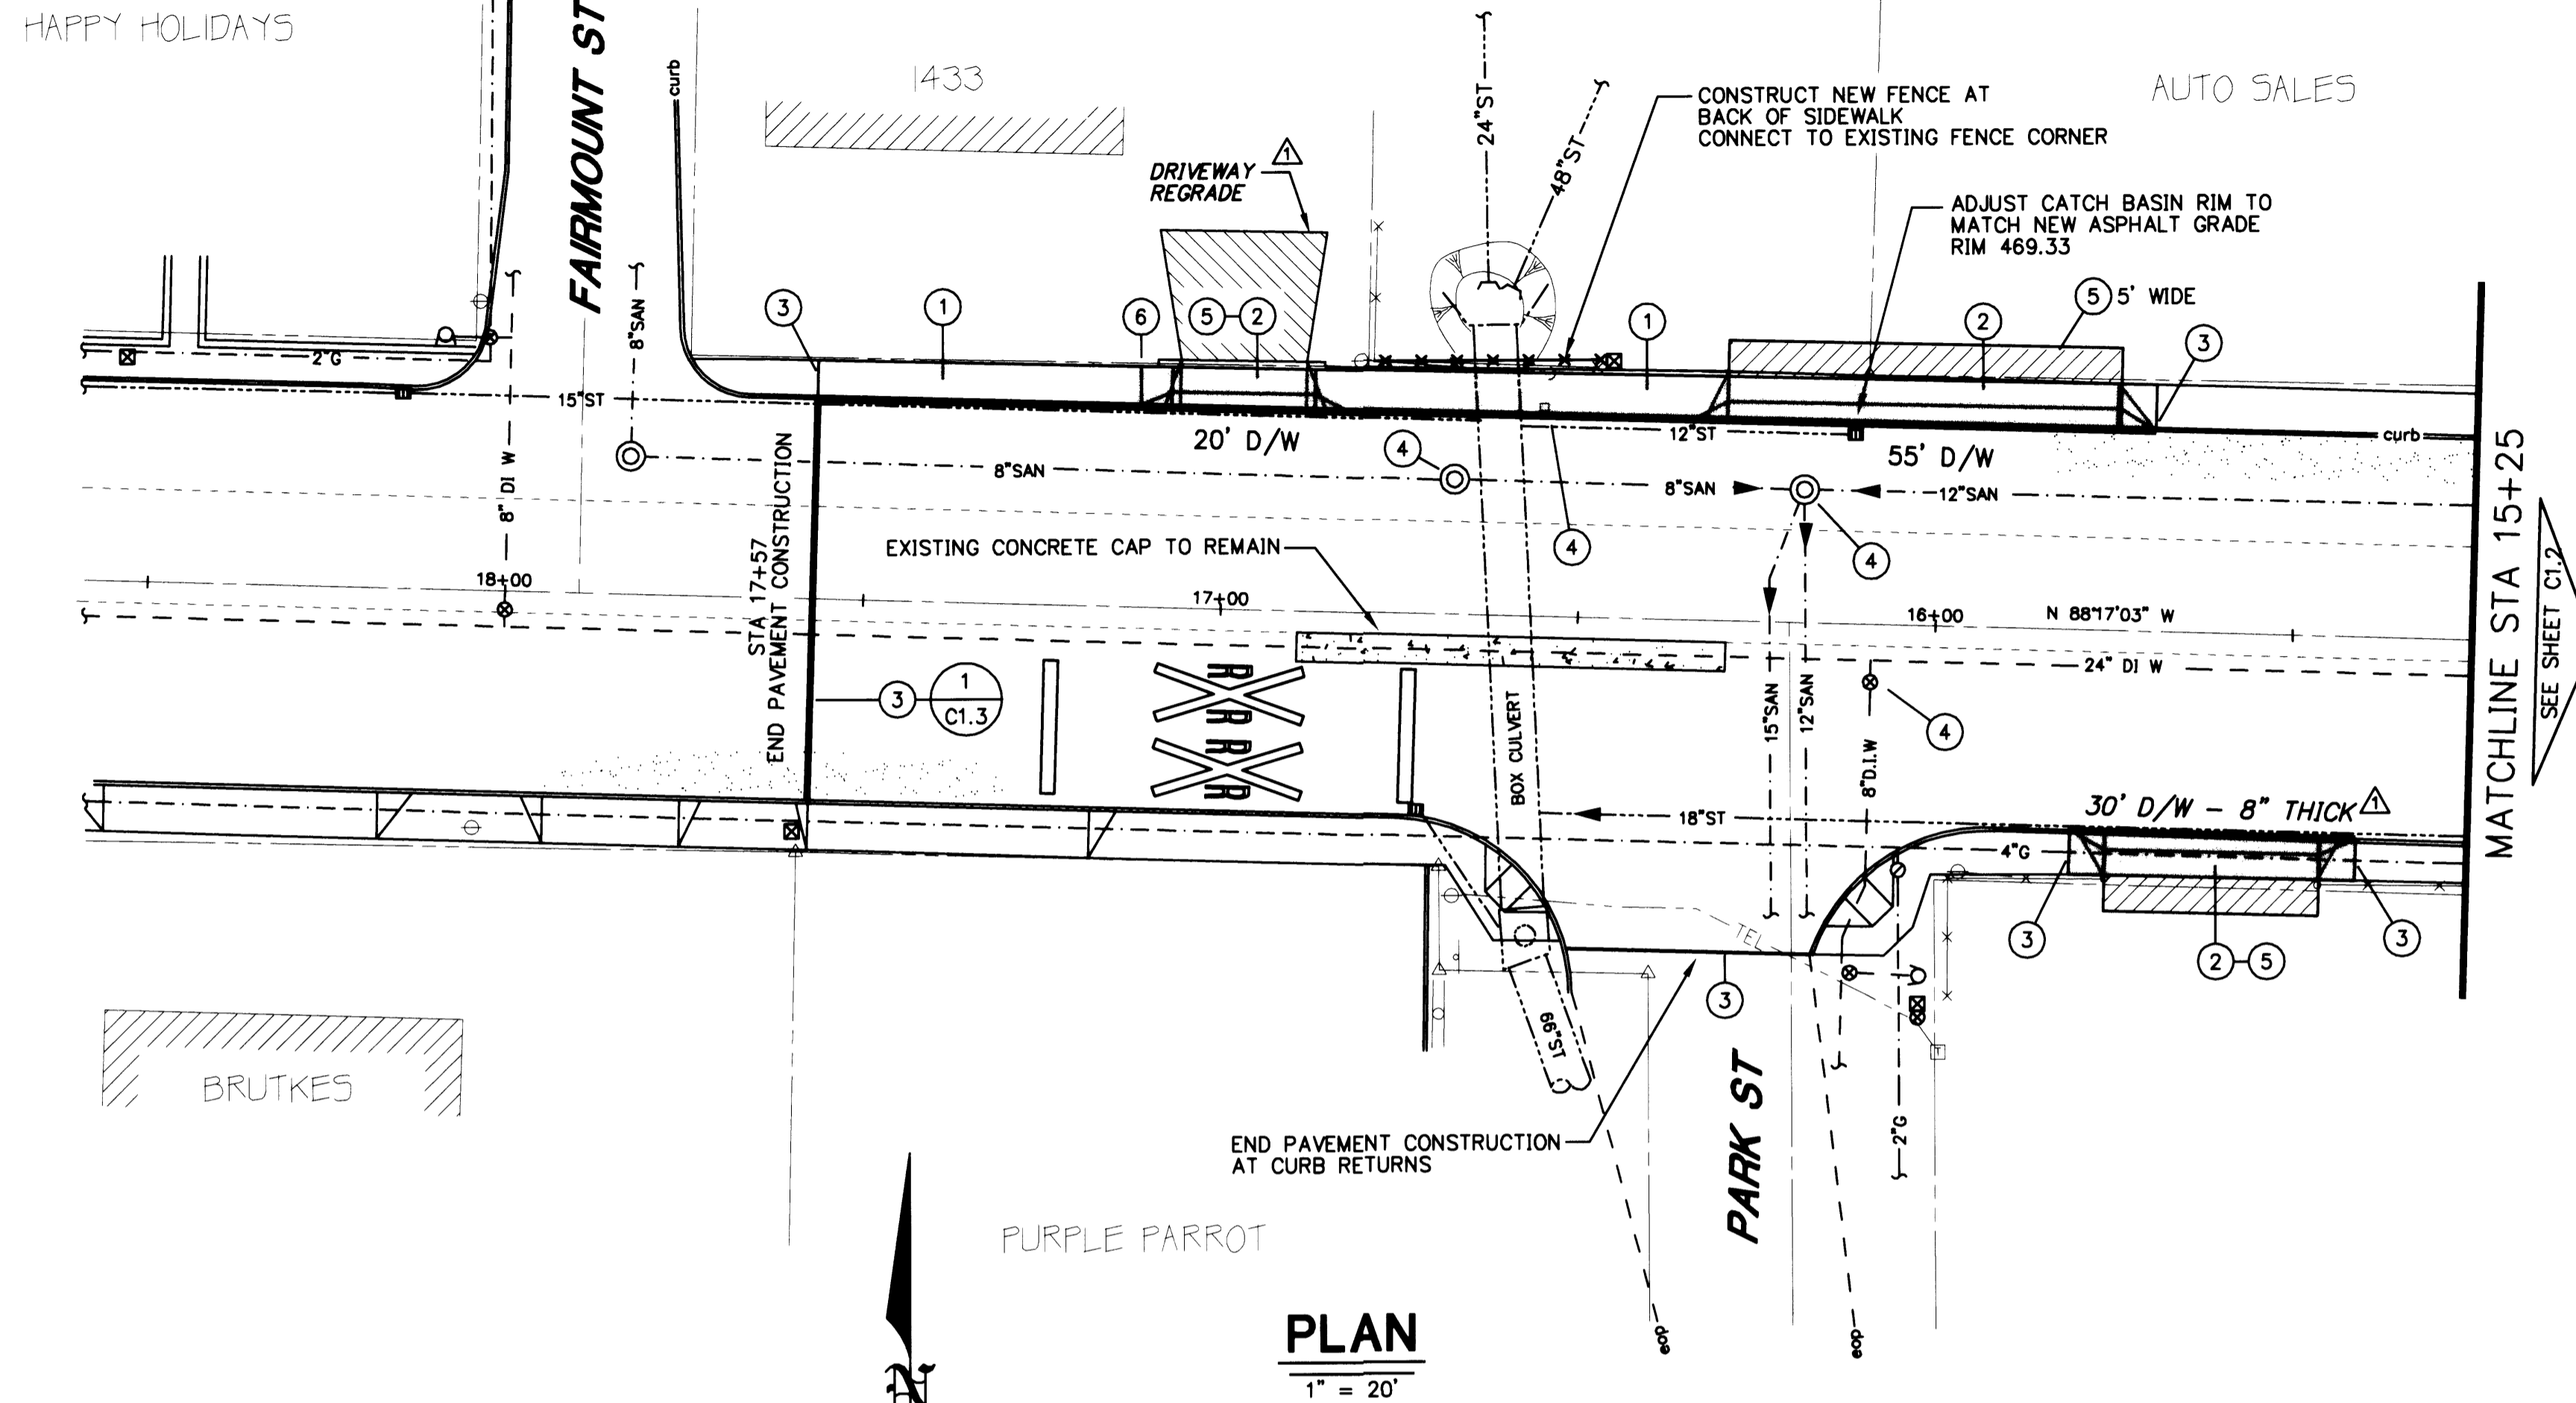

**PLAN**

1" = 20'

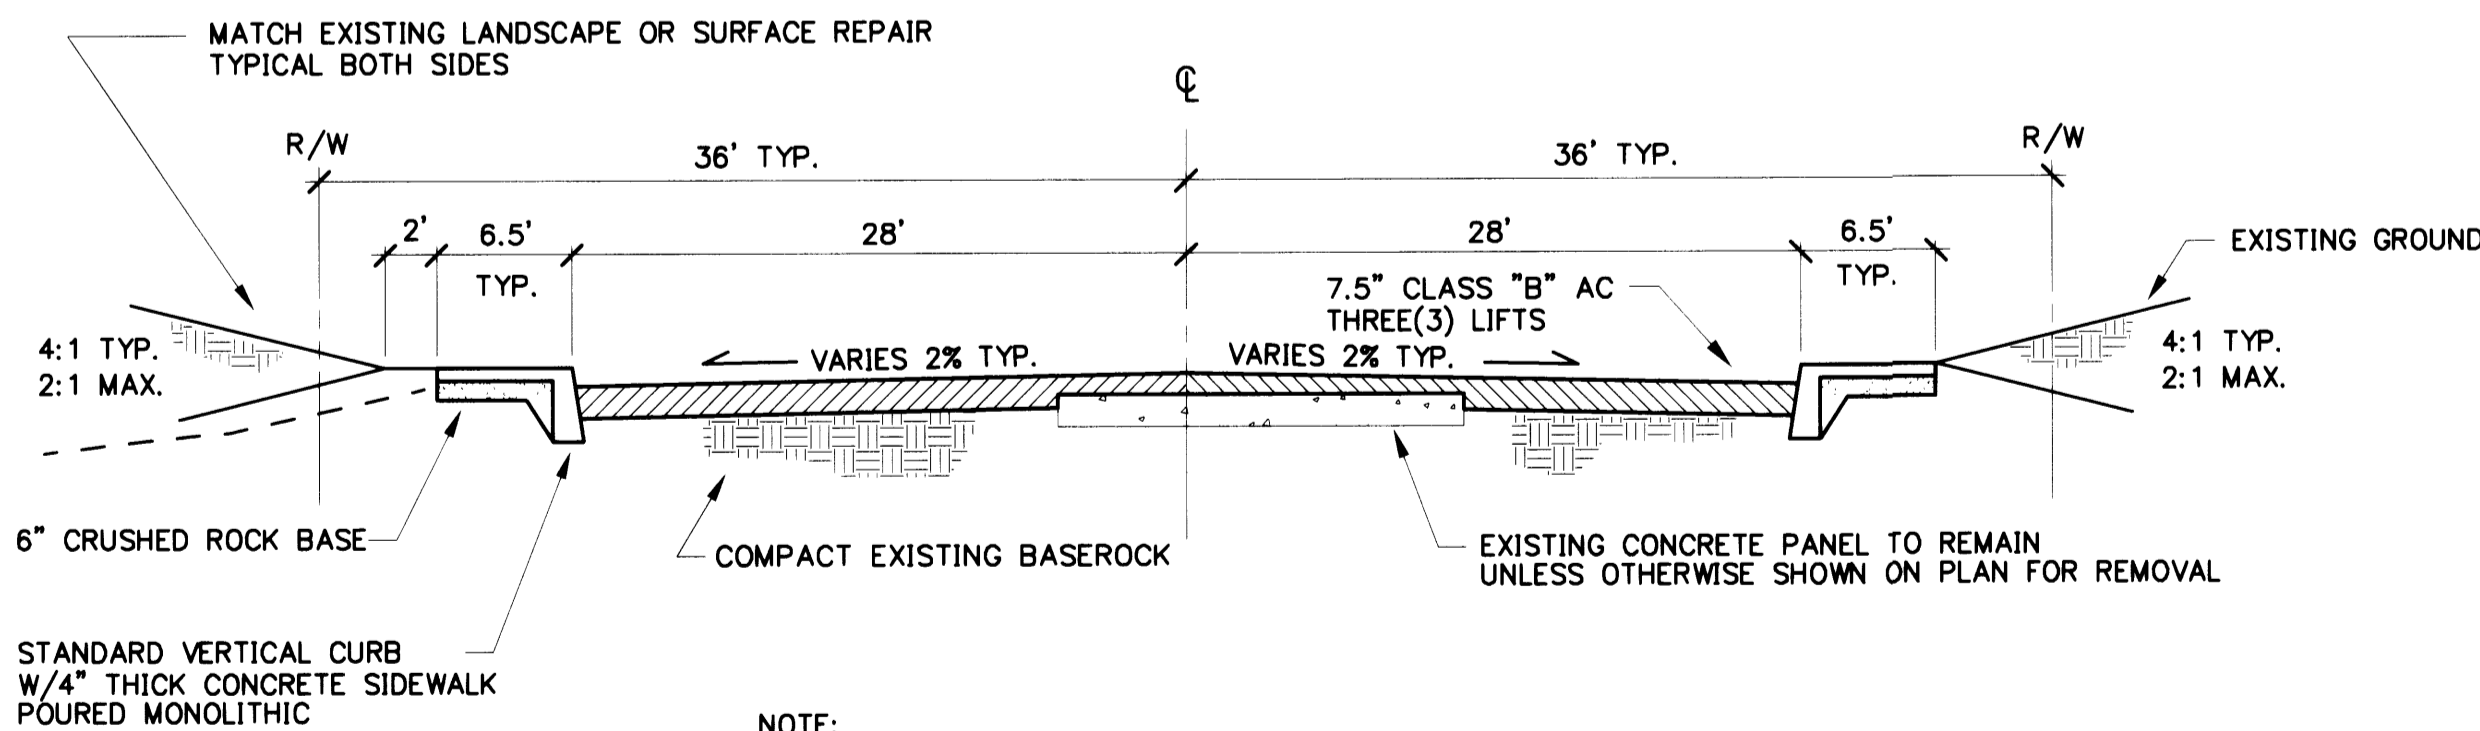

NOTE:  
REMOVE EXISTING ASPHALT AND BASE ROCK AS REQUIRED.  
INSTALL 2 LIFTS OF 3" AC DURING SAME DAY OPERATION.  
INSTALL REMAINING 1/2" LIFT OF AC FOR ENTIRE WIDTH.

**3 TYPICAL STREET SECTION**

C1.2 N.T.S.

**ROAD CONSTRUCTION NOTES**

- 1 REMOVE AND REPLACE MONOLITHIC VERTICAL CURB AND SIDEWALK. SEE TYPICAL SECTION AND DETAILS.
- 2 REMOVE AND REPLACE MONOLITHIC VERTICAL CURB AND DRIVEWAY. SEE TYPICAL SECTIONS AND DETAILS.
- 3 SAWCUT AS DIRECTED. MATCH EXISTING GRADE.
- 4 ADJUST EXISTING MANHOLE FRAME, VALVE BOX OR OTHER UTILITY APPURTENANCE.
- 5 CONSTRUCT ASPHALT DRIVEWAY PATCH BEHIND SIDEWALK.
- 6 CONSTRUCT WEEP HOLE.
- 7 UTILITY APPURTENANCE TO BE REMOVED OR RELOCATED BY RESPECTIVE UTILITY.

DATE	NO.	REVISION	BY	DES	FILENAME	PROJECT
FEB 2003	1	DRAWING OF RECORD	MJG	JDE	27B4C1.2D	CITY OF ROSEBURG GARDEN VALLEY BLVD IMPROVEMENTS PROJECT NO. 02UR03
				JDE	SCALE: AS SHOWN DATE: AUG 2002	
				DAL	APPROVED:	

**CITY OF ROSEBURG**  
**GARDEN VALLEY BLVD IMPROVEMENTS**  
**PROJECT NO. 02UR03**

**ROADWAY PLAN**  
**STA 15+25 TO STA 17+57**

**LEE ENGINEERING, INC.**  
**CONSULTING ENGINEERS**  
**OREGON CITY, OREGON**

JOB NO. 2784  
SHEET NO. C1.2  
5

REGISTERED PROFESSIONAL ENGINEER 14,444  
JOSEPH D. ESKEW  
OREGON JULY 28, 1989  
EXP. 12/31/03

000GVBL3