
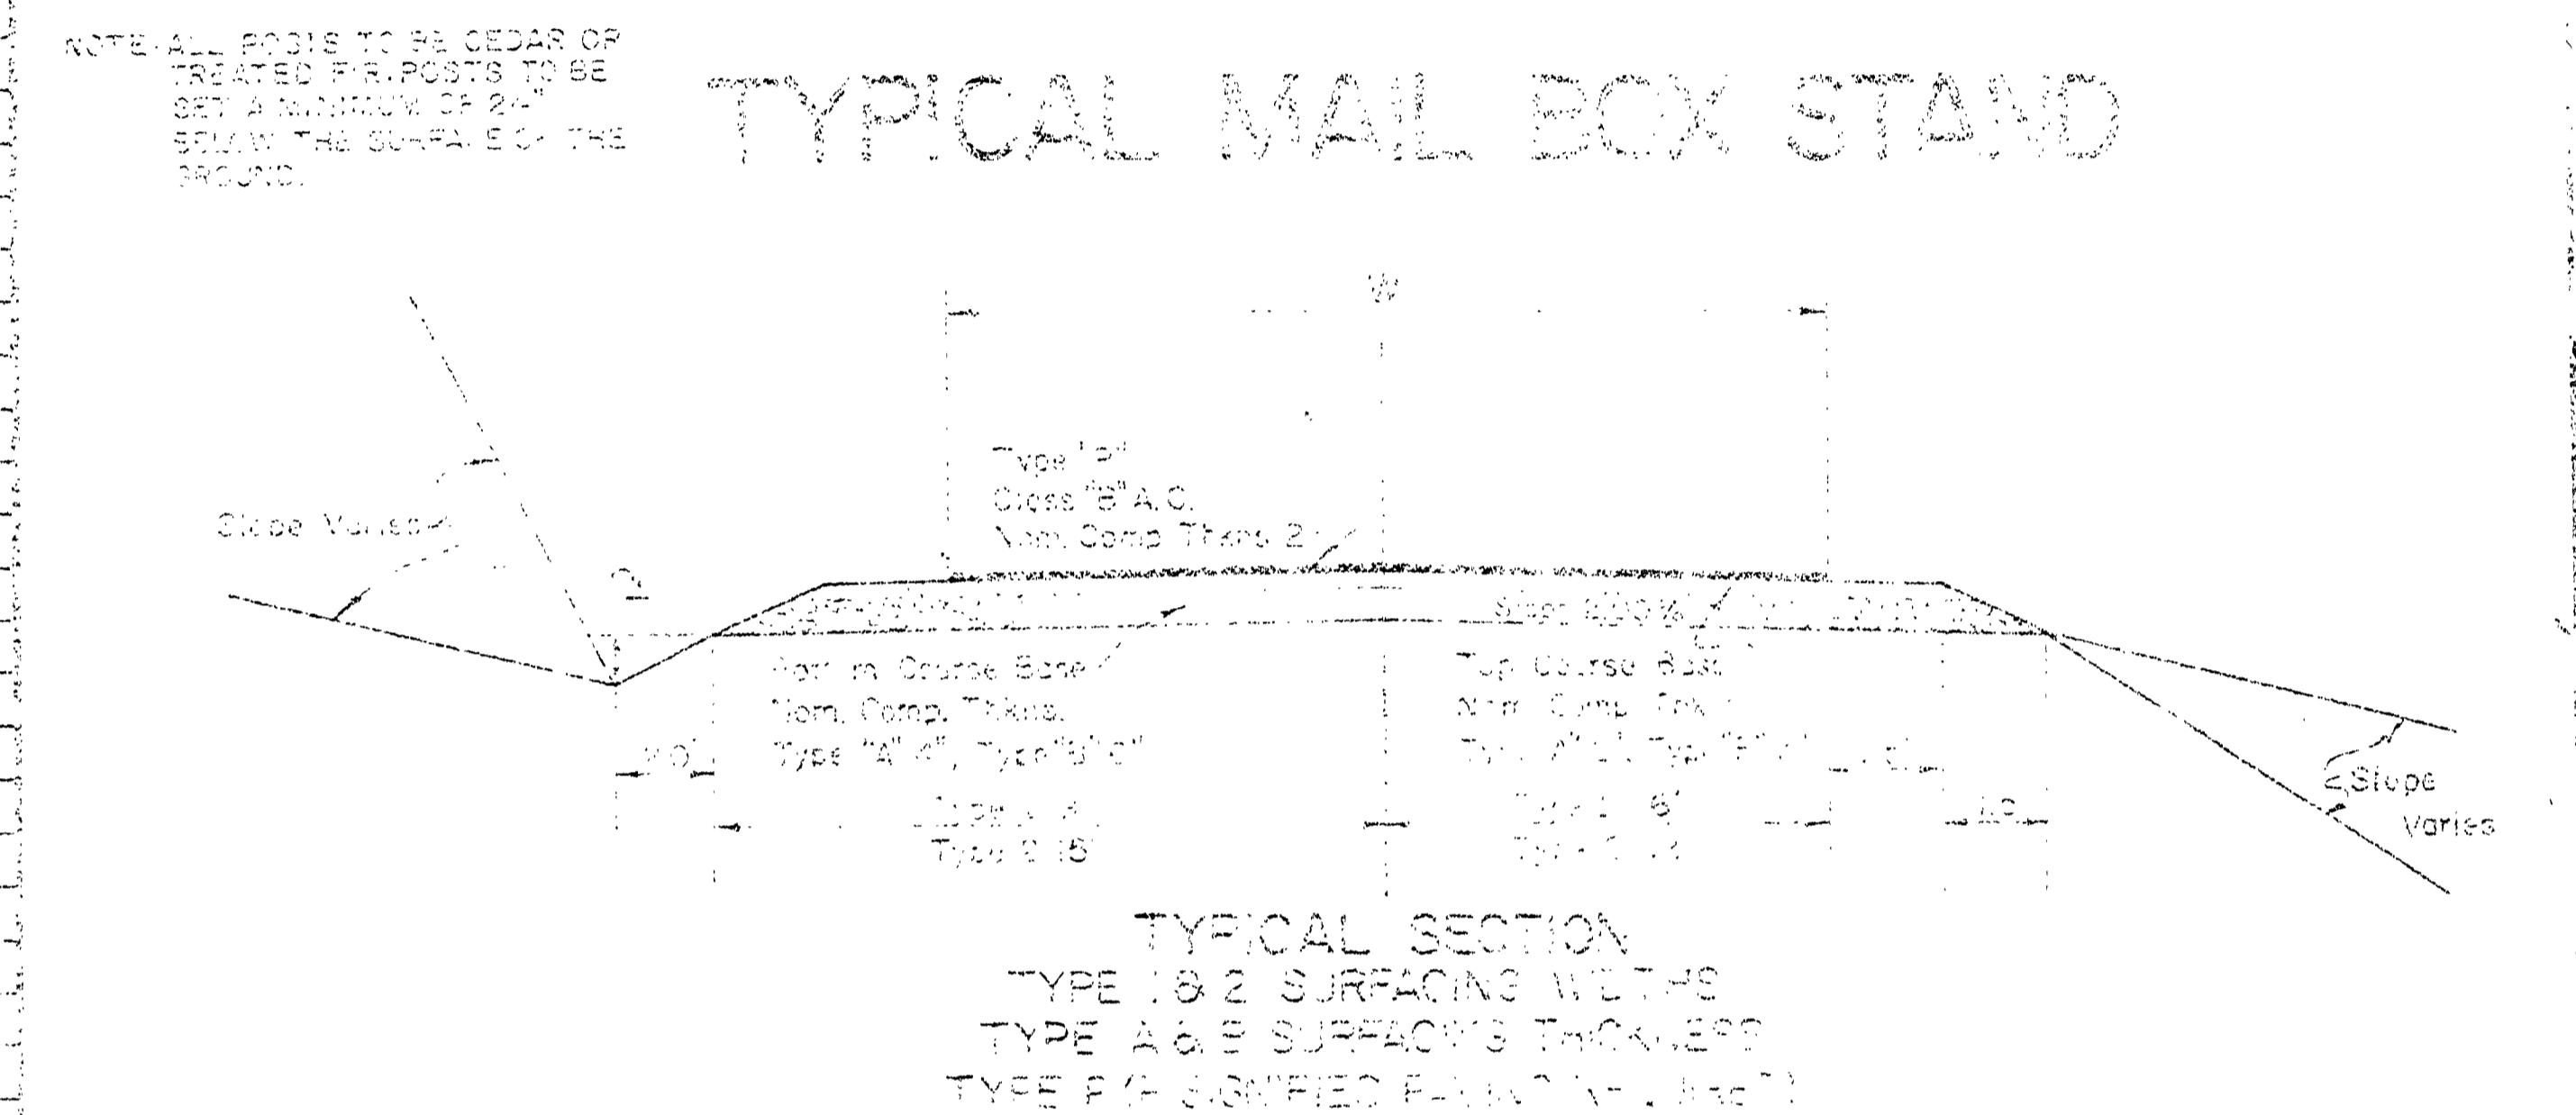



PIPE LIST, MAIL BOX STAND, DRIVEWAY TYPICALS & SLOPE STAKE EXAMPLE

STATION	DIAMETER	LENGTH	PIPE LIST MATERIALS					TRENCH EXC. CU. YDS.	REMARKS STRUTTED END TREATMENT, IMPERFECT TRENCH, ETC.
			ALUMINUM		GALV. STEEL		CONCRETE		
			ANNULAR CORR. SPIRAL CORR. ASPHALT COATED	ANNULAR CORR. SPIRAL CORR. ASPHALT COATED	ANNULAR CORR. SPIRAL CORR. ASPHALT COATED	CLASS. REINFORCED			
INCHES	FEET								
101+85	12	30	✓	✓	✓	✓	7	D/W	
102+70	12	27	✓	✓	✓	✓	6	D/W	
103+12	42	62	✓	✓	✓	✓	57		
103+40	12	27	✓	✓	✓	✓	6	D/W	
106+80	12	40	✓	✓	✓	✓	5	D/W	
108+45	12	24	✓	✓	✓	✓	5	D/W	
109+00	12	40	✓	✓	✓	✓	5	D/W	
110+10	18	64	✓	✓	✓	✓	34		
114+05	18	54	✓	✓	✓	✓	18		
120+20	12	40	✓	✓	✓	✓	5	D/W	
123+60	24	72	✓	✓	✓	✓	64		
127+65	12	40	✓	✓	✓	✓	5	D/W	
131+90	18	56	✓	✓	✓	✓	17		
134+50	12	40	✓	✓	✓	✓	5	D/W	
137+60	18	56	✓	✓	✓	✓	17		
138+40	12	40	✓	✓	✓	✓	5	D/W	
141+35	12	40	✓	✓	✓	✓	5	D/W	
145+75	72	86	✓	✓	✓	✓	178	SLOPED ENDS	
150+70	18	52	✓	✓	✓	✓	21		
154+50	12	24	✓	✓	✓	✓	5	D/W	
158+30	18	92	✓	✓	✓	✓	32		
162+50	18	72	✓	✓	✓	✓	21		
166+20	84	84	✓	✓	✓	✓	224	SLOPED ENDS (STRUTTED)	
167+00	18	74	✓	✓	✓	✓	21		
168+75	12	40	✓	✓	✓	✓	5	D/W	
170+50	18	84	✓	✓	✓	✓	24		
174+50	18	72	✓	✓	✓	✓	31		
179+00	18	64	✓	✓	✓	✓	22		
186+80	18	40	✓	✓	✓	✓	13		
187+00	60	120	✓	✓	✓	✓	187	SLOPED ENDS	
202+20	12	36	✓	✓	✓	✓	4	D/W	
203+40	12	40	✓	✓	✓	✓	5	D/W	
205+10	72	62	✓	✓	✓	✓	27	SLOPED ENDS	
208+25	12	36	✓	✓	✓	✓	4	D/W	
210+10	24	50	✓	✓	✓	✓	28		
212+60	24	46	✓	✓	✓	✓	22		
213+35	12	36	✓	✓	✓	✓	4	D/W	
216+30	12	70	✓	✓	✓	✓	16	CONDUIT	
216+45	12	36	✓	✓	✓	✓	4	D/W	
216+50	12	36	✓	✓	✓	✓	4	D/W	
233+50	18	56	✓	✓	✓	✓	20		
236+50	18	54	✓	✓	✓	✓	7		
244+00	12	36	✓	✓	✓	✓	4	D/W	
244+00	12	36	✓	✓	✓	✓	4	D/W	
251+20	18	48	✓	✓	✓	✓	19		
253+40	12	36	✓	✓	✓	✓	4	D/W	
253+45	12	36	✓	✓	✓	✓	4	D/W	
259+60	18	48	✓	✓	✓	✓	28		
260+65	12	36	✓	✓	✓	✓	4	D/W	
264+80	18	64	✓	✓	✓	✓	35		
267+80	12	36	✓	✓	✓	✓	4	D/W	
270+85	18	46	✓	✓	✓	✓	14		

NOTE: PIPE LENGTHS & LOCATIONS TO BE VERIFIED IN FIELD.

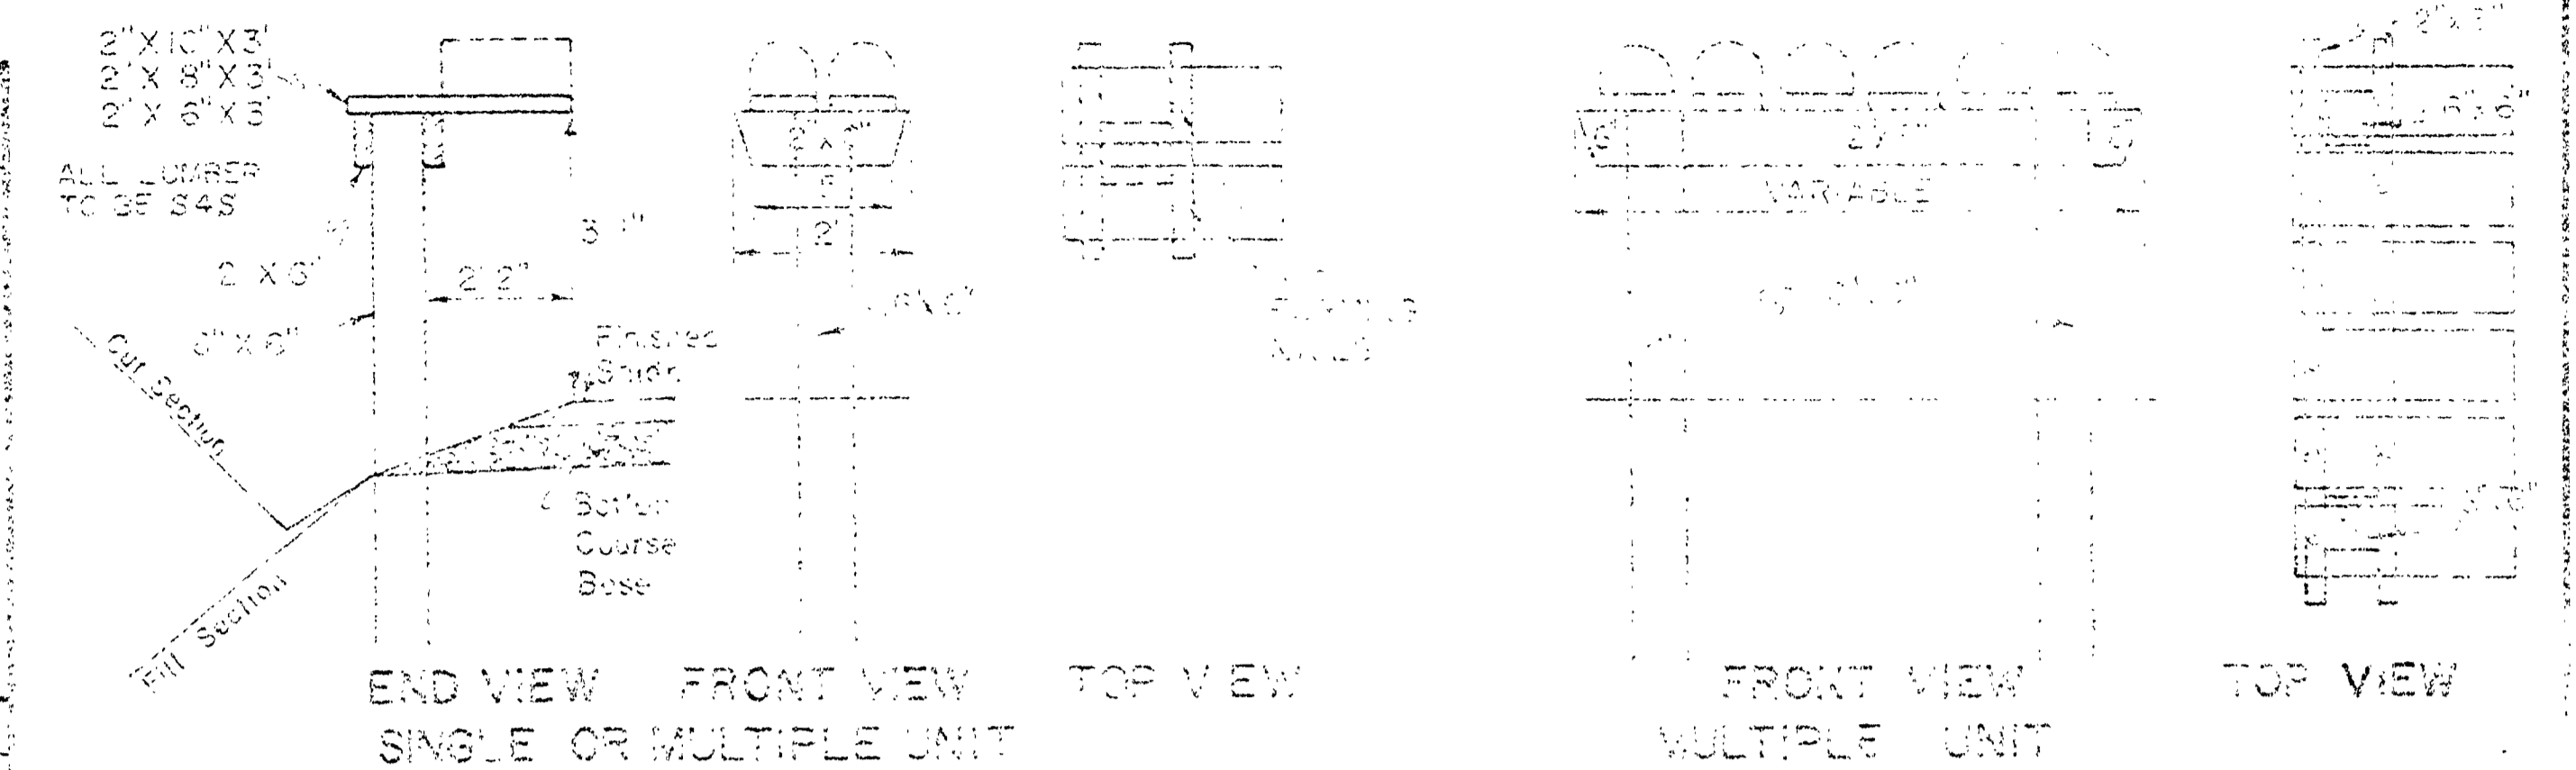

RURAL DRIVEWAY & ROAD APPROACH STANDARD

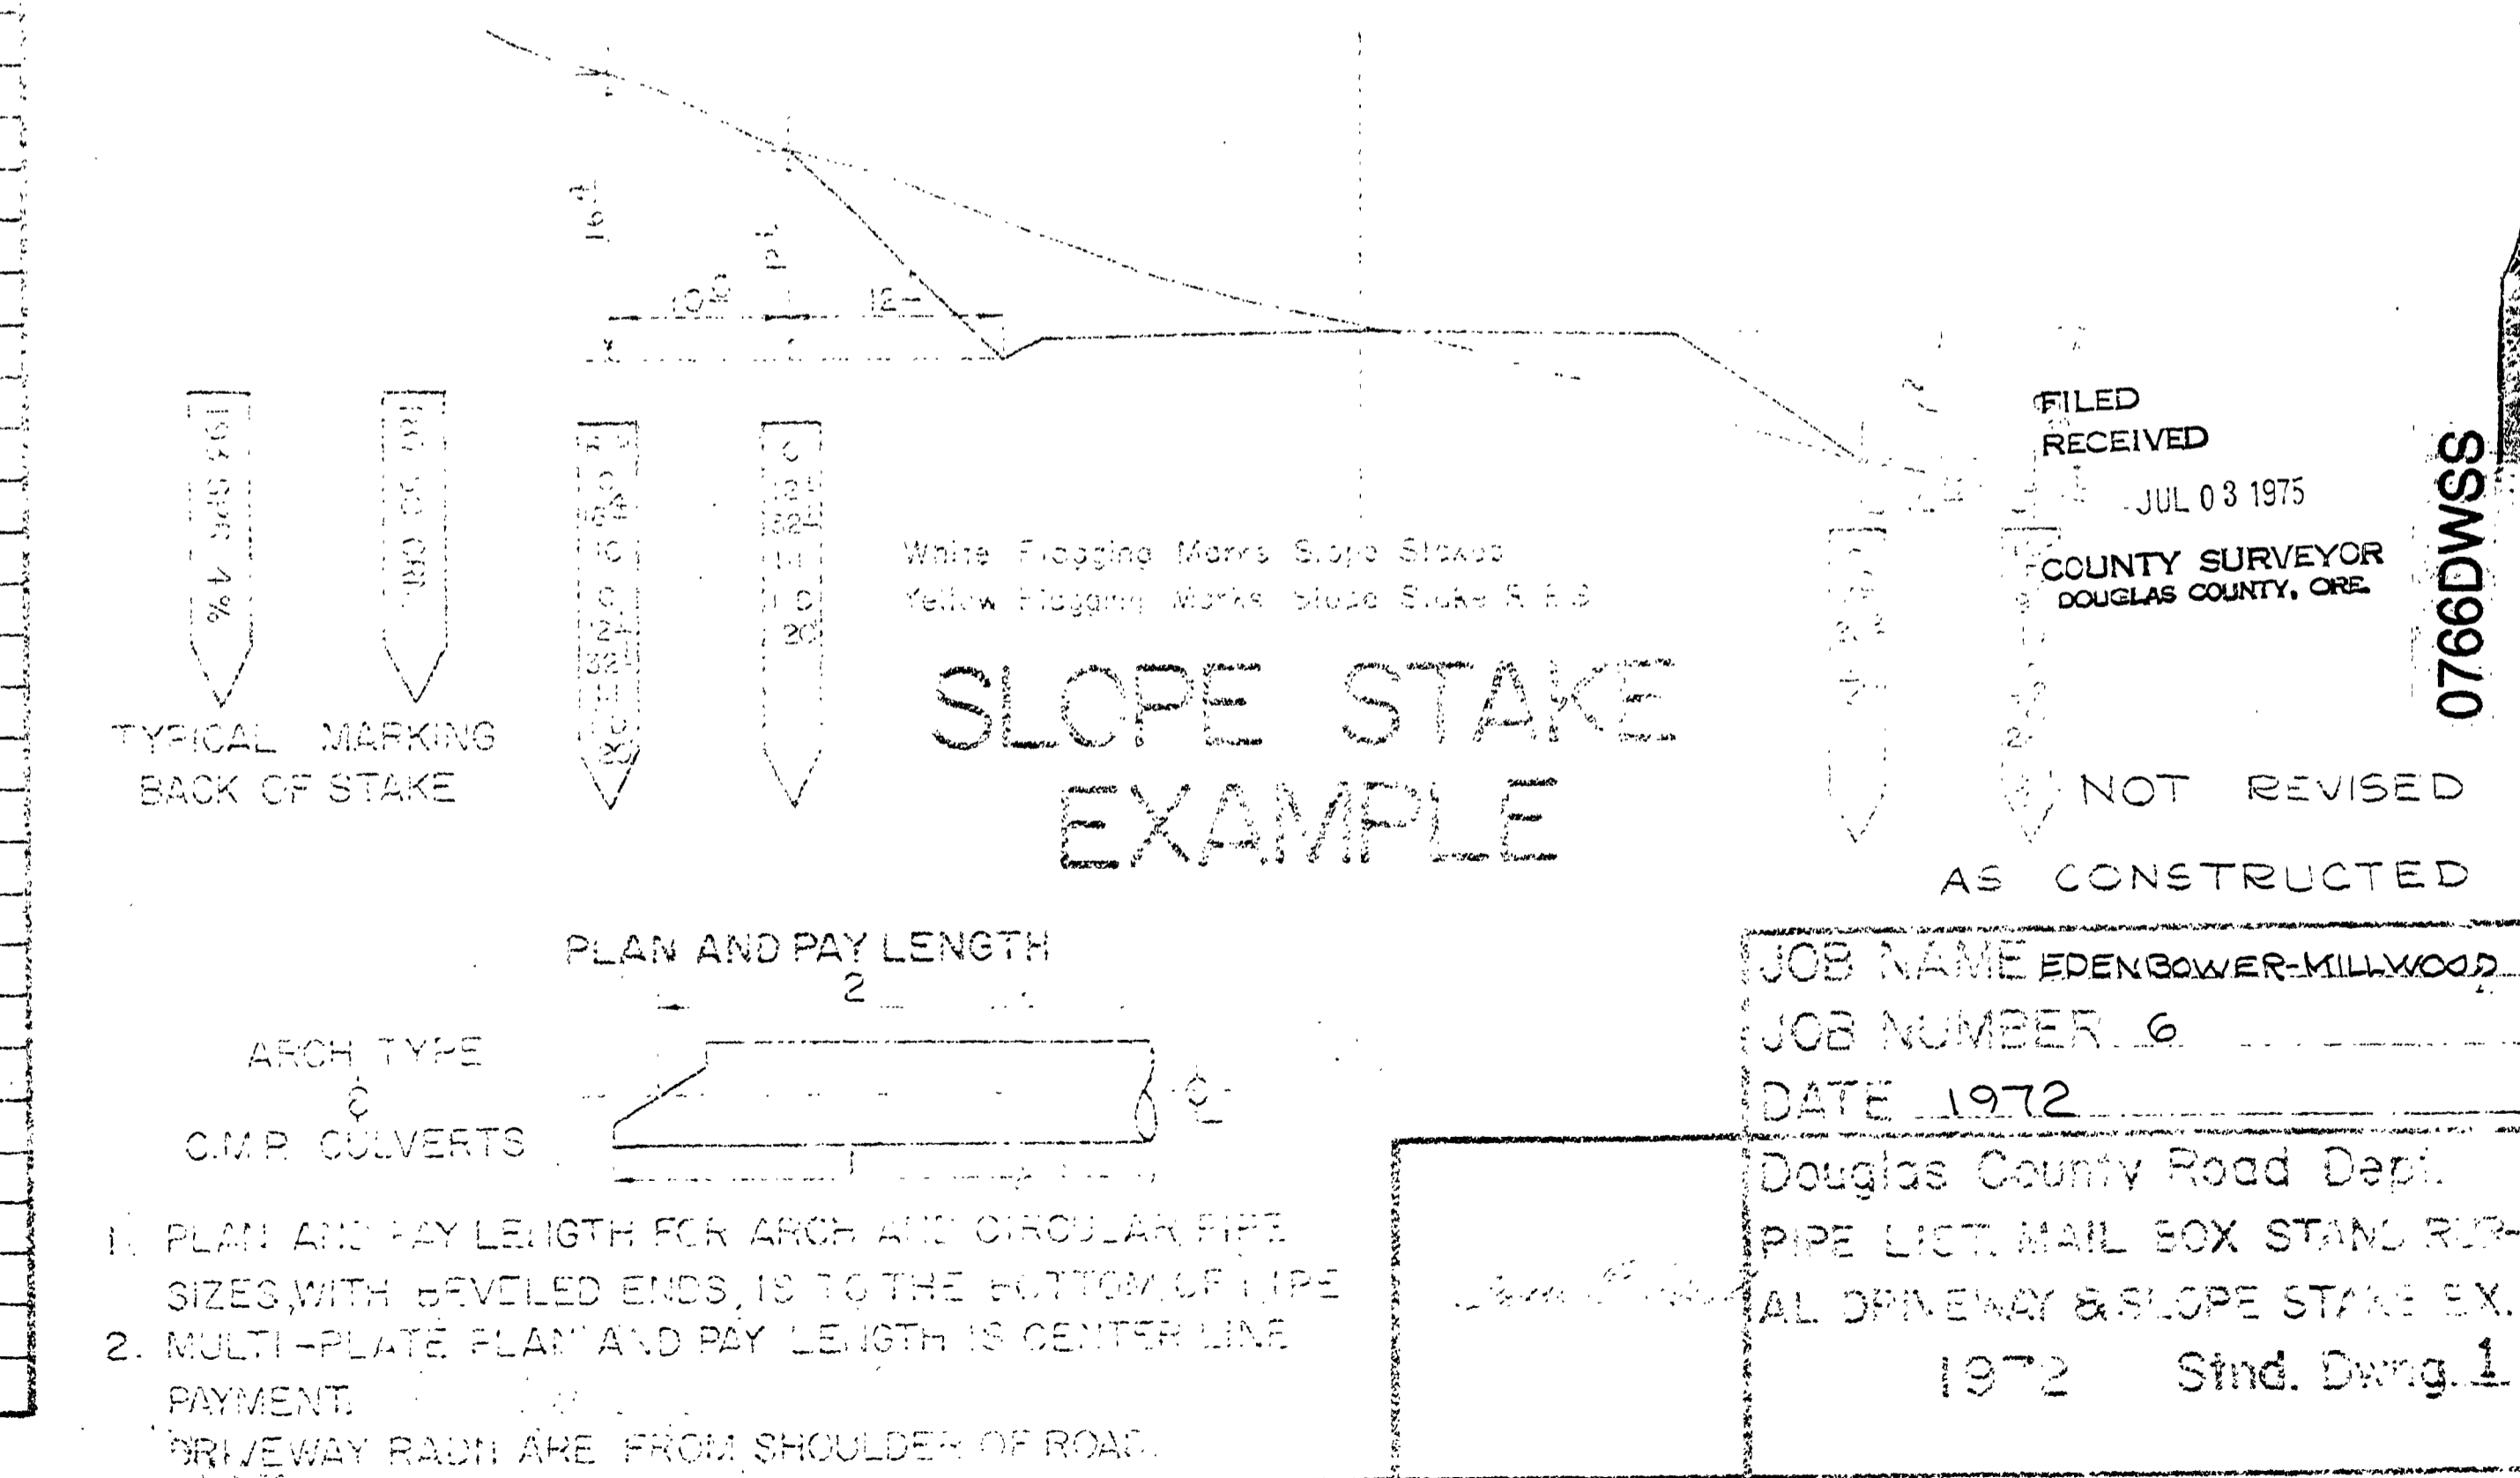

Rd. # 6 1973 Sit. 4 of 13