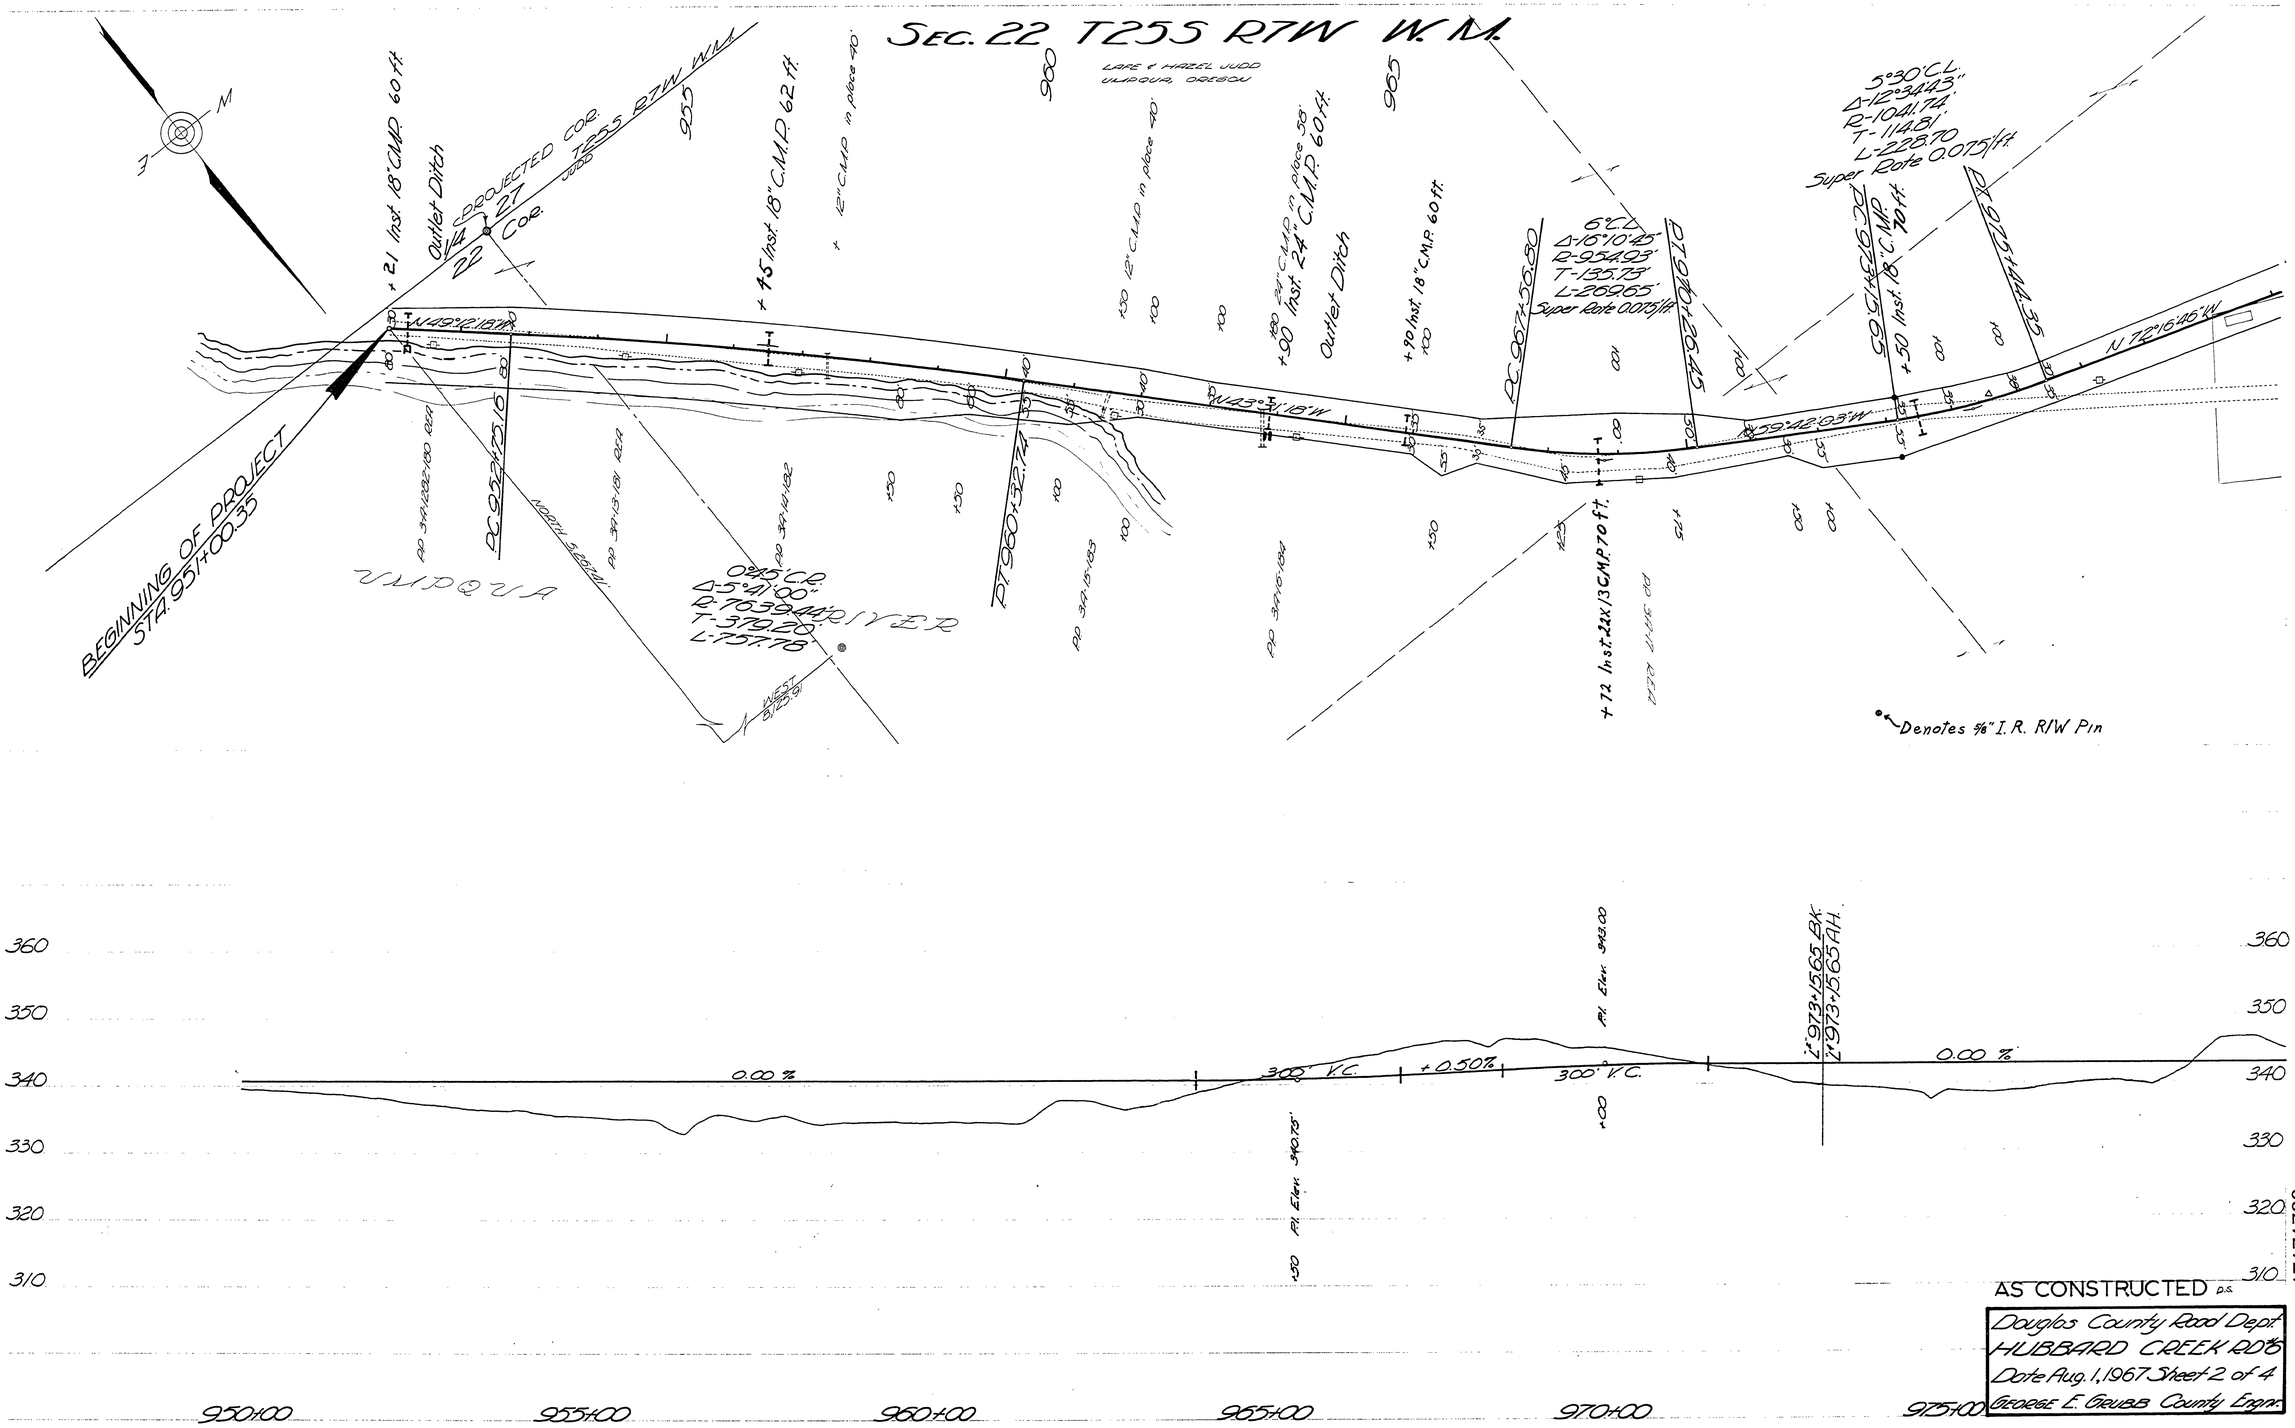

M.P. 17.17 - 17.63

Rd. # 6 Aug. 1, 1967 Sh. 2 of 4