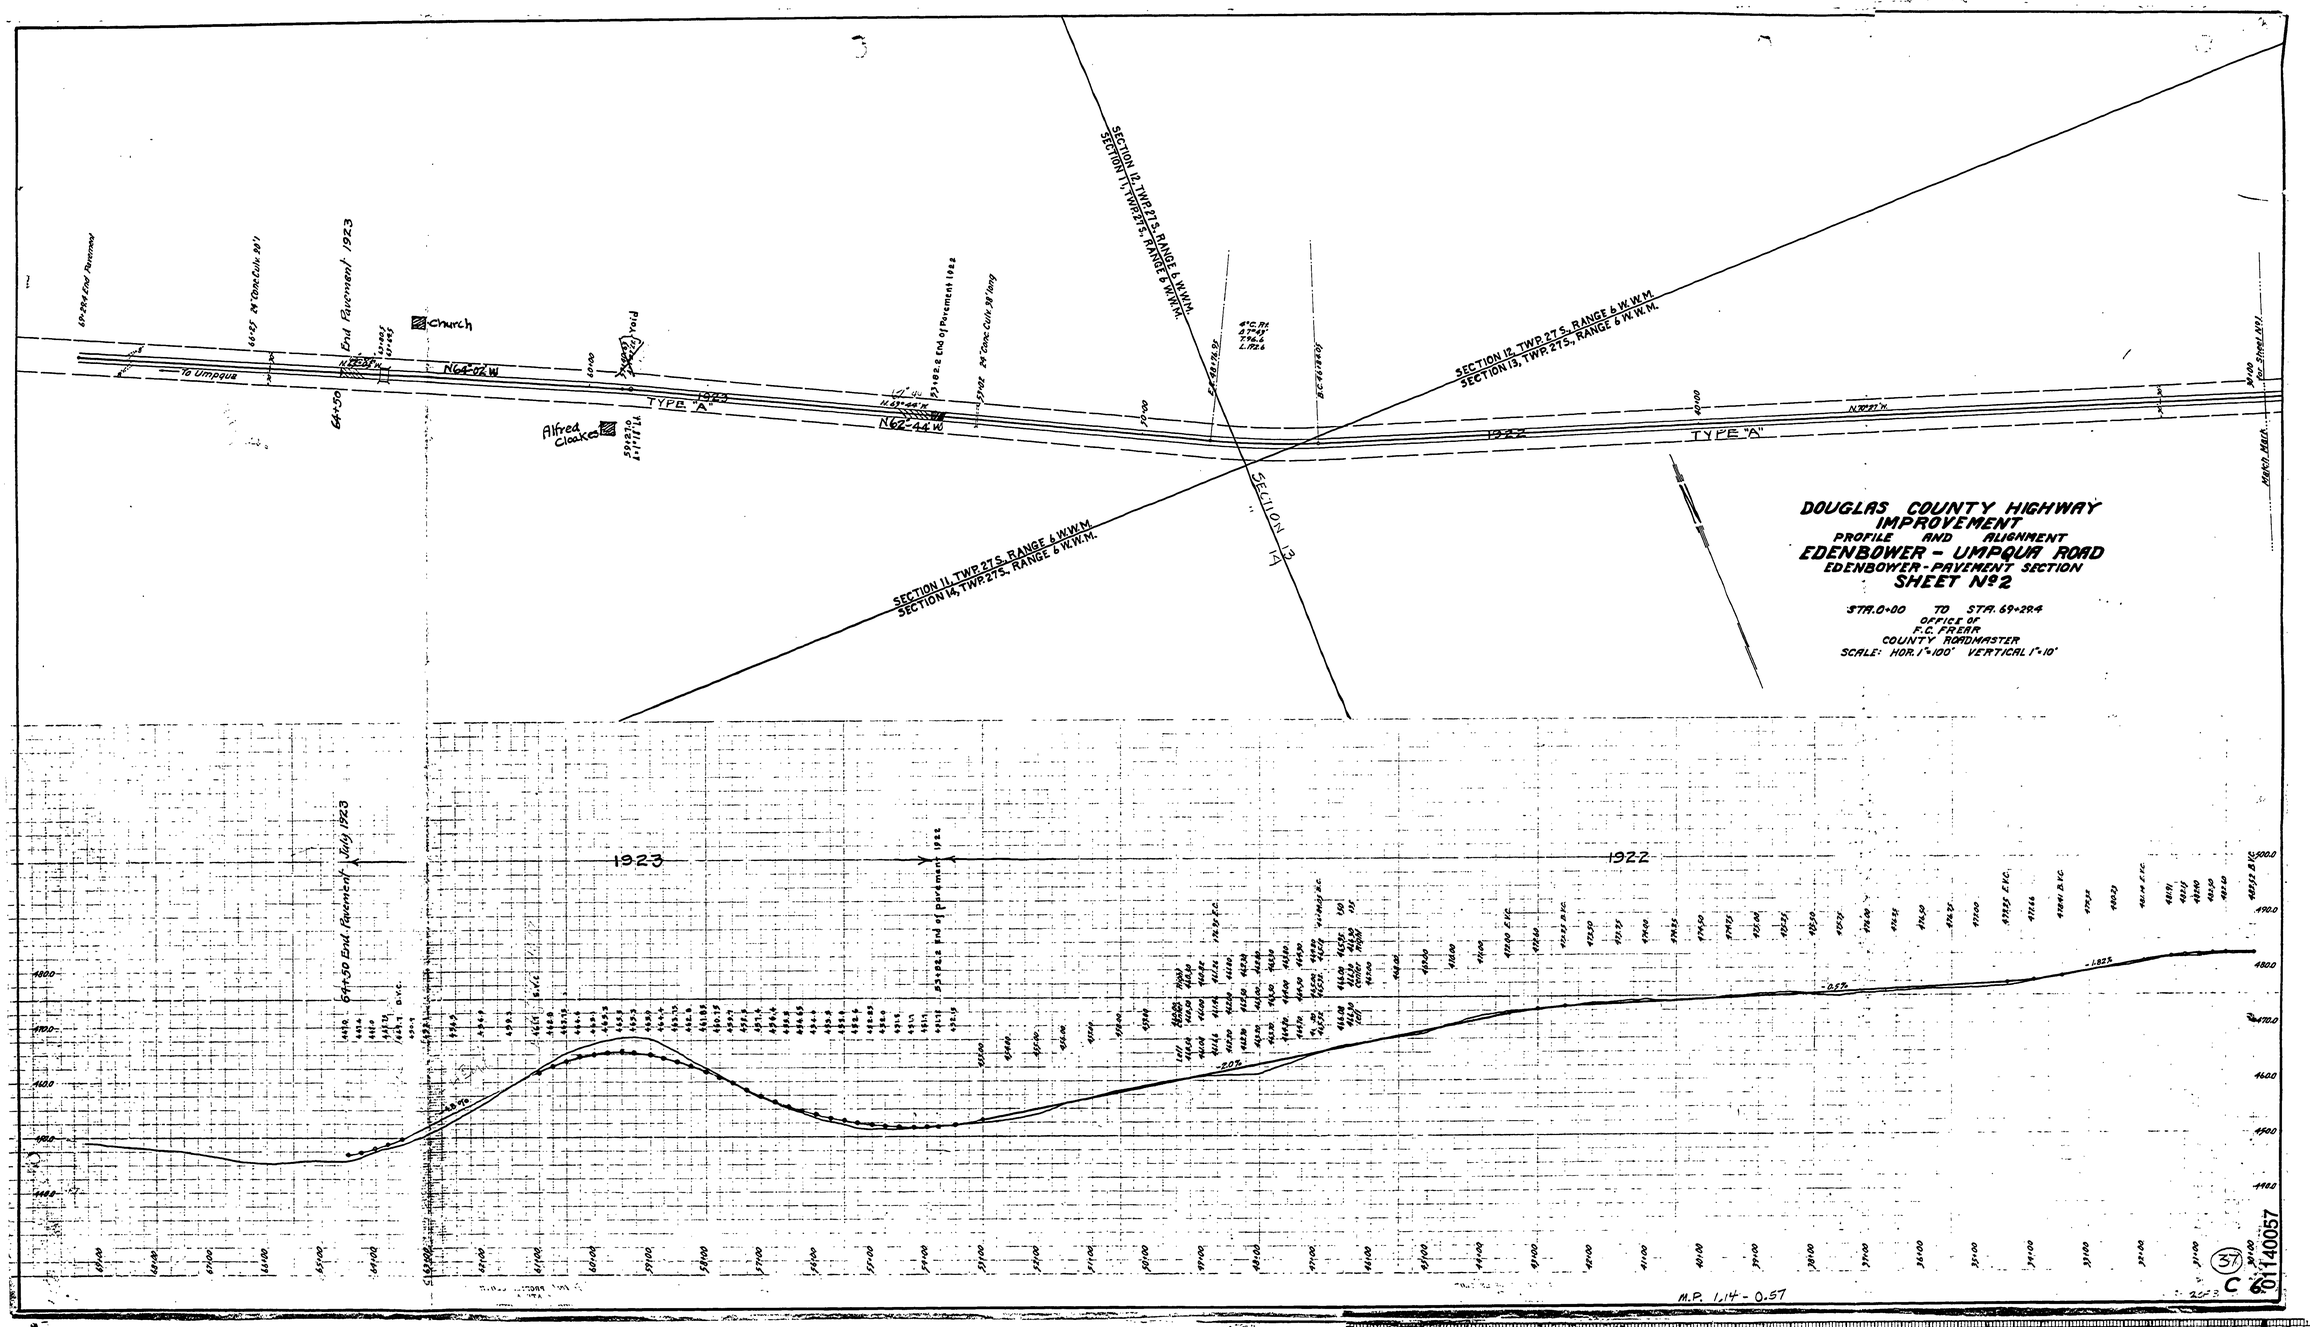
DOUGLAS COUNTY HIGHWAY IMPROVEMENT
PROFILE AND ALIGNMENT
EDENBOWER - UMPQUA ROAD
EDENBOWER - PAVEMENT SECTION
SHEET Nº 2
STA. 0+00 TO STA. 69+29.4
OFFICE OF
F.C. FREAR
COUNTY ROADMASTER
SCALE: HOR. 1"=100' VERTICAL 1"=10'
SECTION 12, TWP. 27 S., RANGE 6 W.W.M.
SECTION 13, TWP. 27 S., RANGE 6 W.W.M.
SECTION 11, TWP. 27 S., RANGE 6 W.W.M.
SECTION 14, TWP. 27 S., RANGE 6 W.W.M.
SECTION 13
SECTION 14
To Umpqua
Church
Alfred Cloake
End Pavement 1923
TYPE "A"
1923
1922
N62°-44' W
N62°-02' W
N30°27' W
64+50 End Pavement July 1923
69+29.4 End of pavement 1922
M.P. 1.14 - 0.57
01140057

30 X