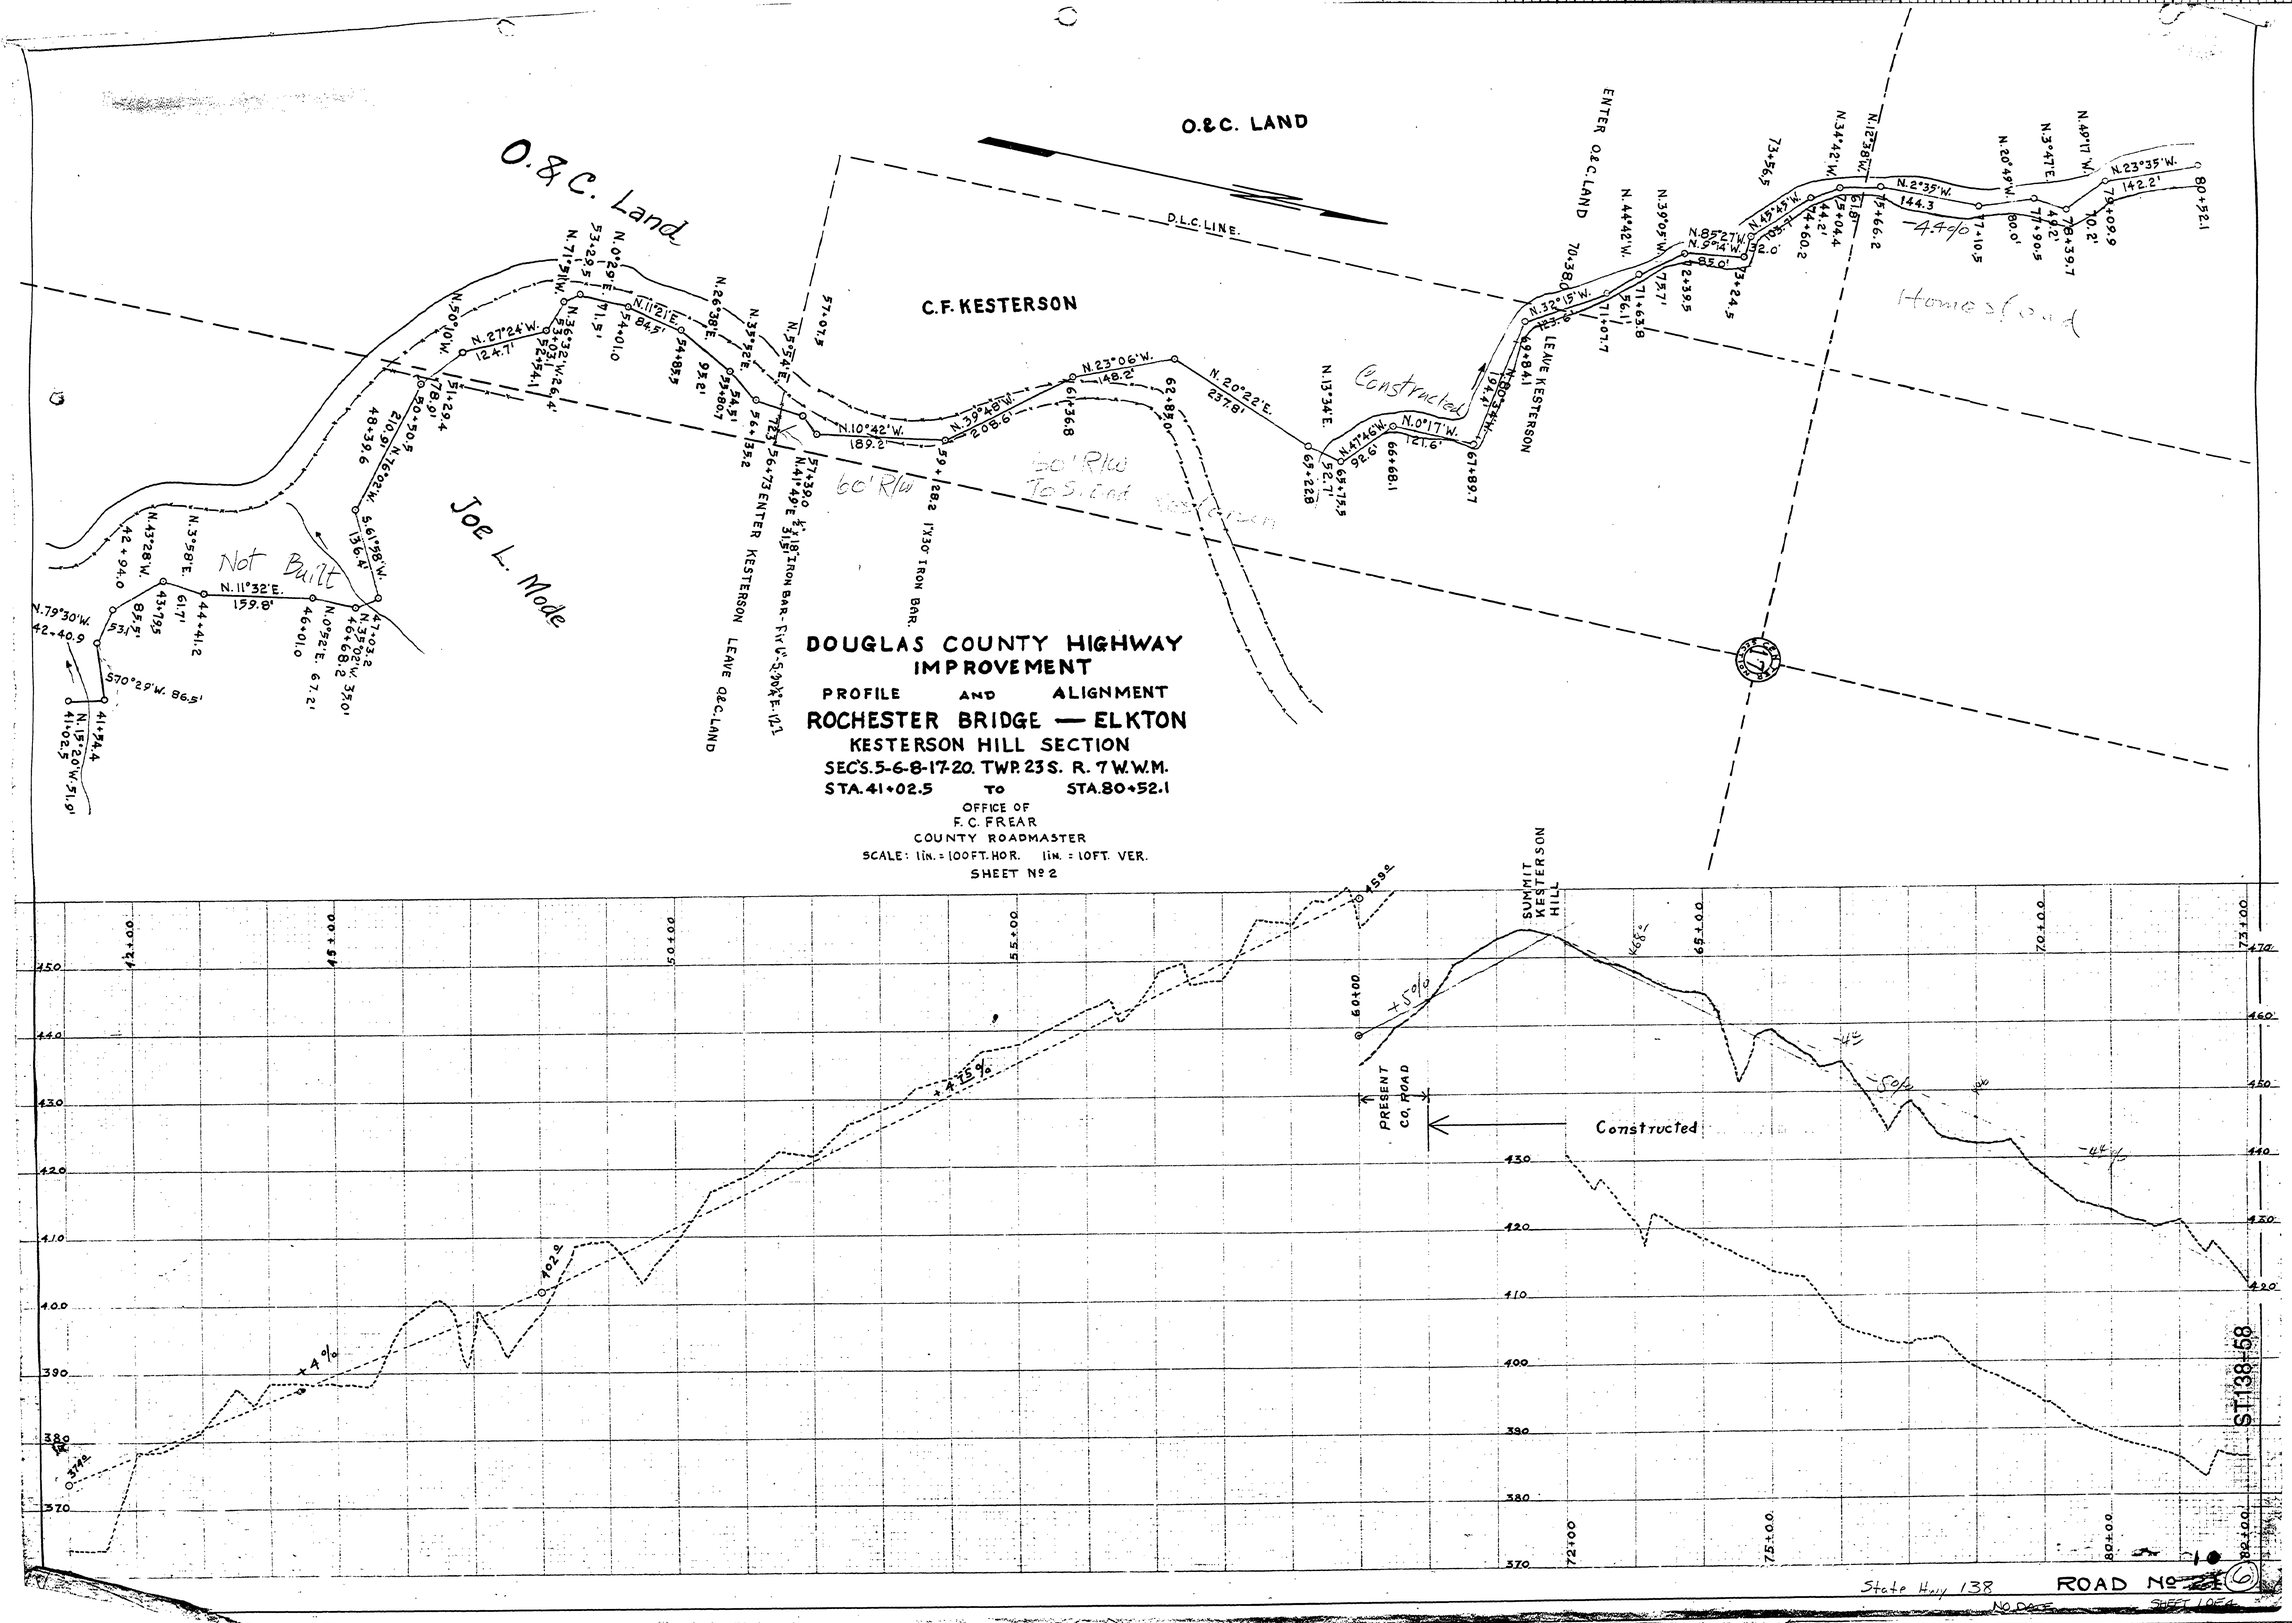
O.&C. LAND
O.&C. Land
C.F. KESTERSON
D.L.C. LINE.
Joe L. Mode
Not Built
Constructed
Homestead
60' R/W
60' R/W To Stand Vacation
ENTER O.&C. LAND
ENTER KESTERSON
LEAVE O&C LAND
LEAVE KESTERSON
1"x30" IRON BAR.
DOUGLAS COUNTY HIGHWAY
IMPROVEMENT
PROFILE AND ALIGNMENT
ROCHESTER BRIDGE — ELKTON
KESTERSON HILL SECTION
SEC'S. 5-6-8-17-20. TWP. 23 S. R. 7 W.W.M.
STA. 41+02.5 TO STA. 80+52.1
OFFICE OF
F. C. FREAR
COUNTY ROADMASTER
SCALE: 1in. = 100FT. HOR. 1in. = 10FT. VER.
SHEET No 2
SUMMIT KESTERSON HILL
PRESENT CO. ROAD
Constructed
+5%
-5%
-4%
+4%
+2.5%
State Hwy 138
ROAD No
NO. DOUG.
SHEET 1 OF 4
ST138-58