DOUGLAS COUNTY HIGHWAY IMPROVEMENT

PROFILE AND ALIGNMENT

ELKTON PLAT 'M' ROAD

BECKLEY SECTION

SEC'S. 35-36-31-30-19 & 29, TWP. 22S. R. 8-7 W.

STA. 0+00 TO STA. 33+00

OFFICE OF
F. C. FREAR
COUNTY ROADMASTER

SCALE: HOR. 1 in = 100 FT. VER. 1 in = 10 FT.
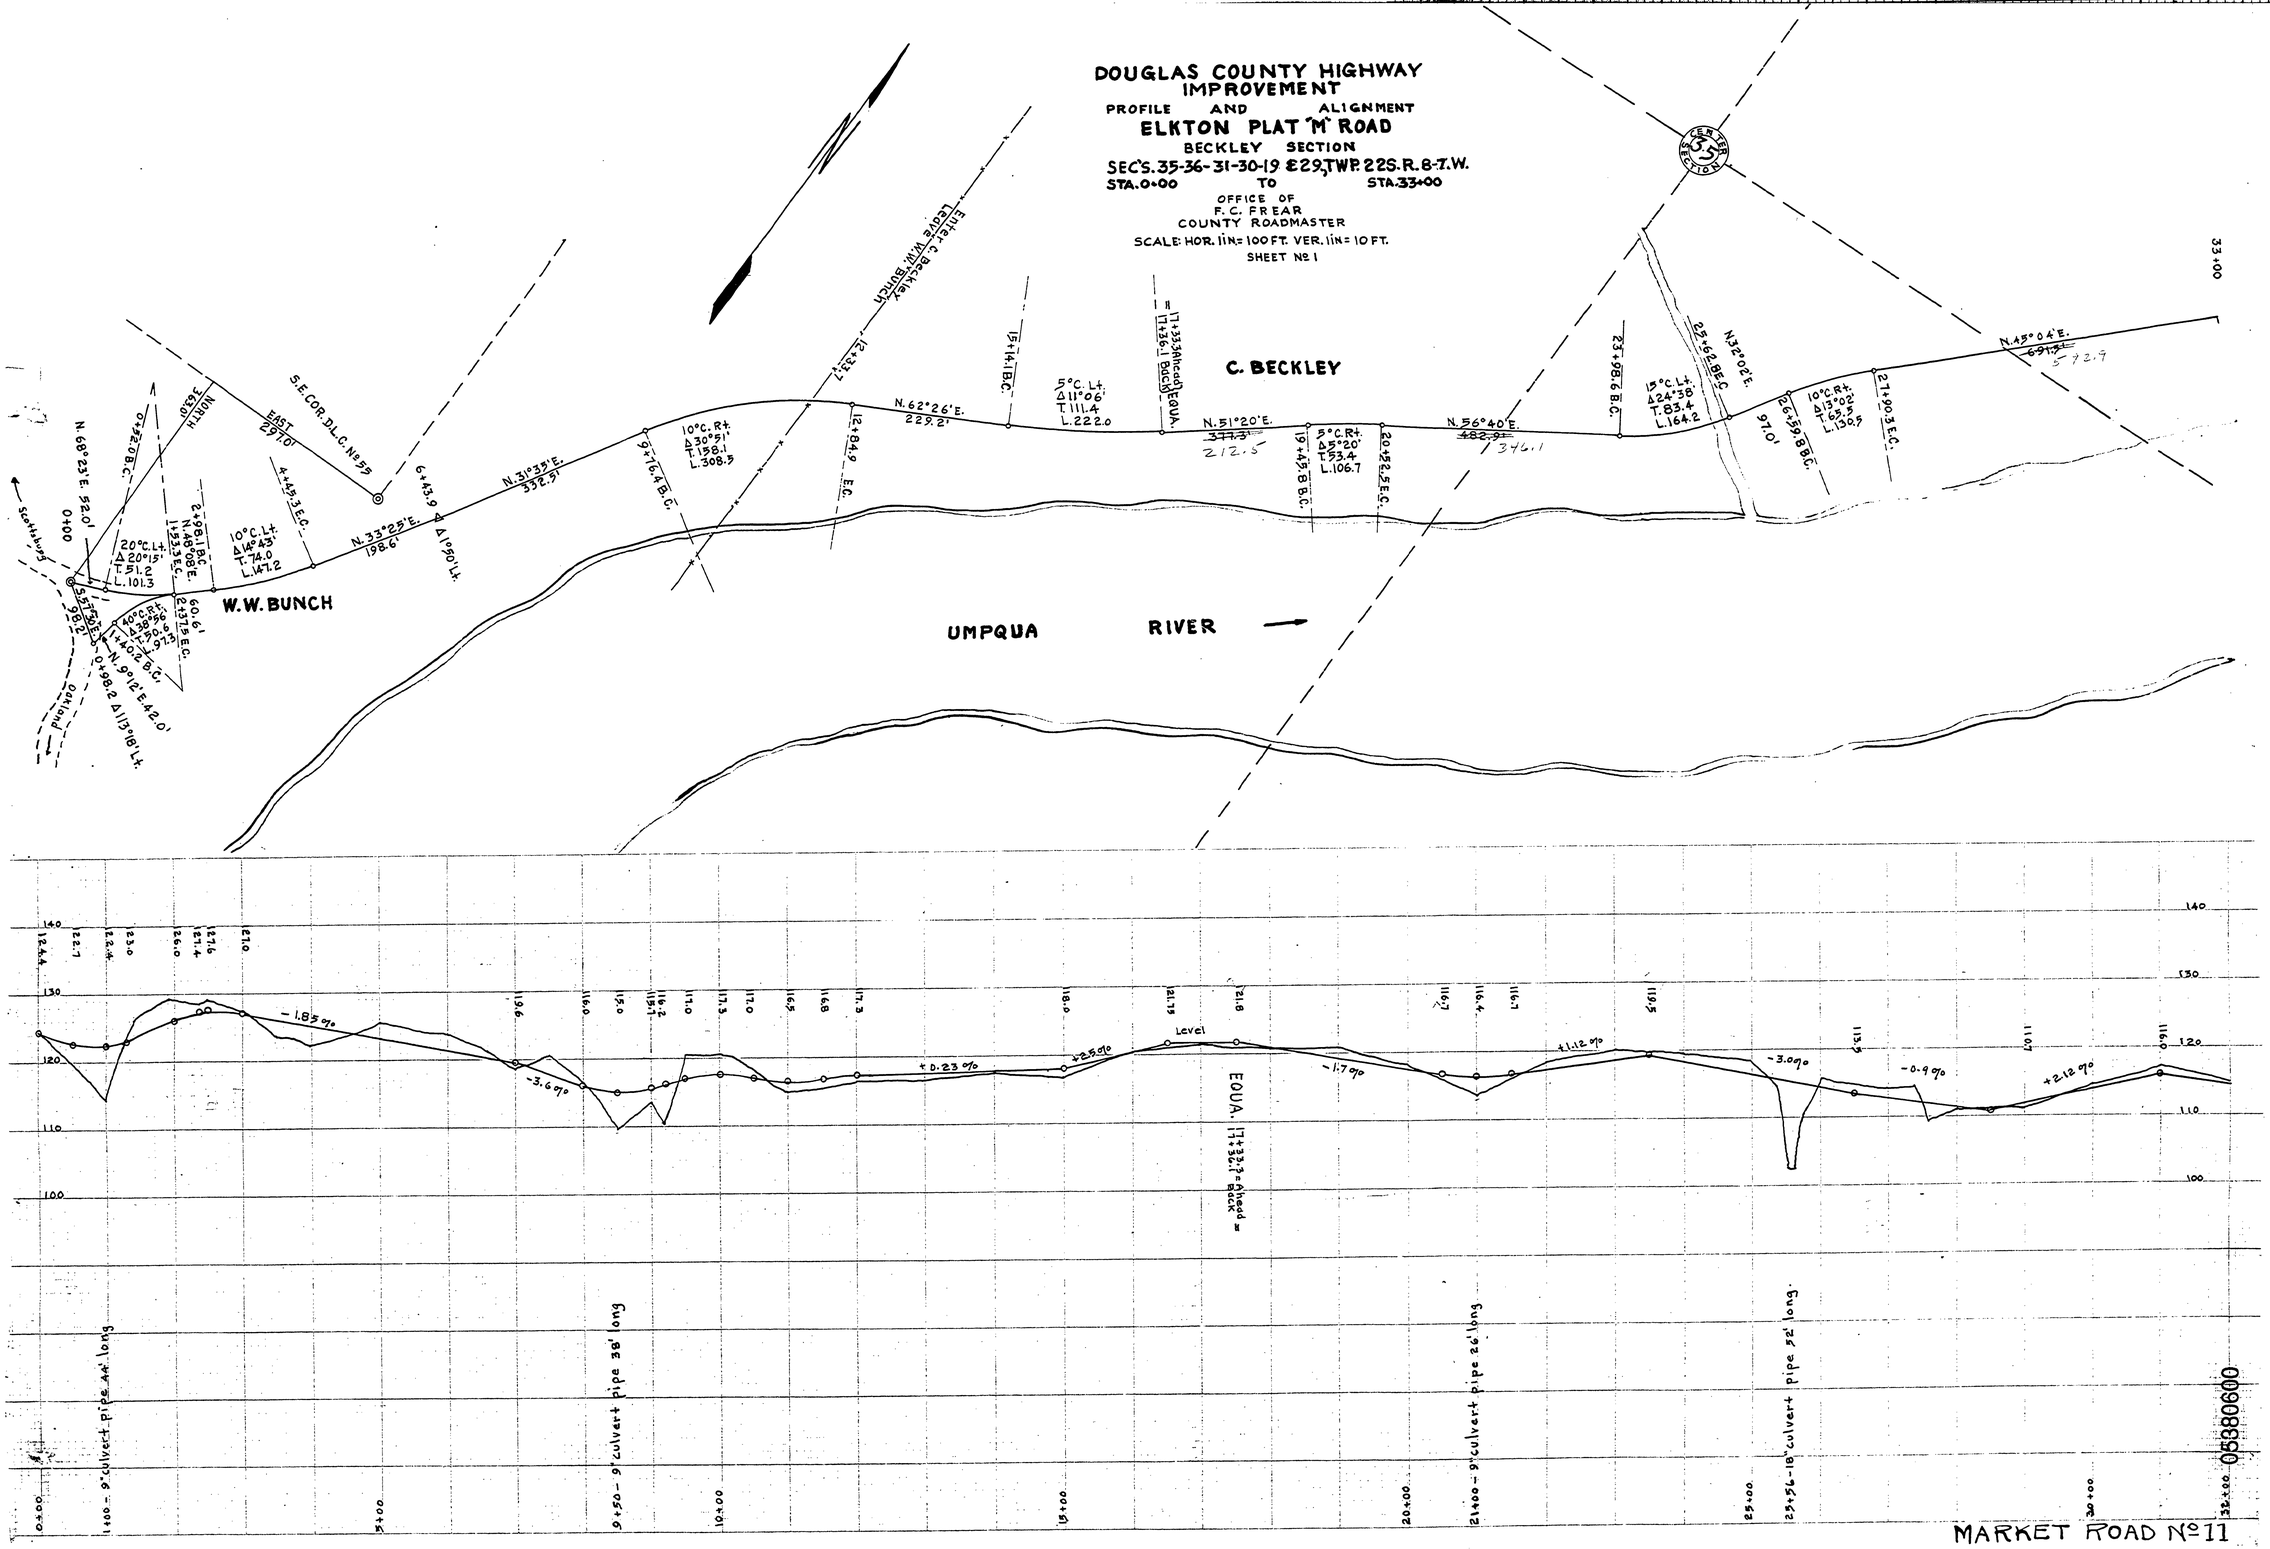
SHEET No 1