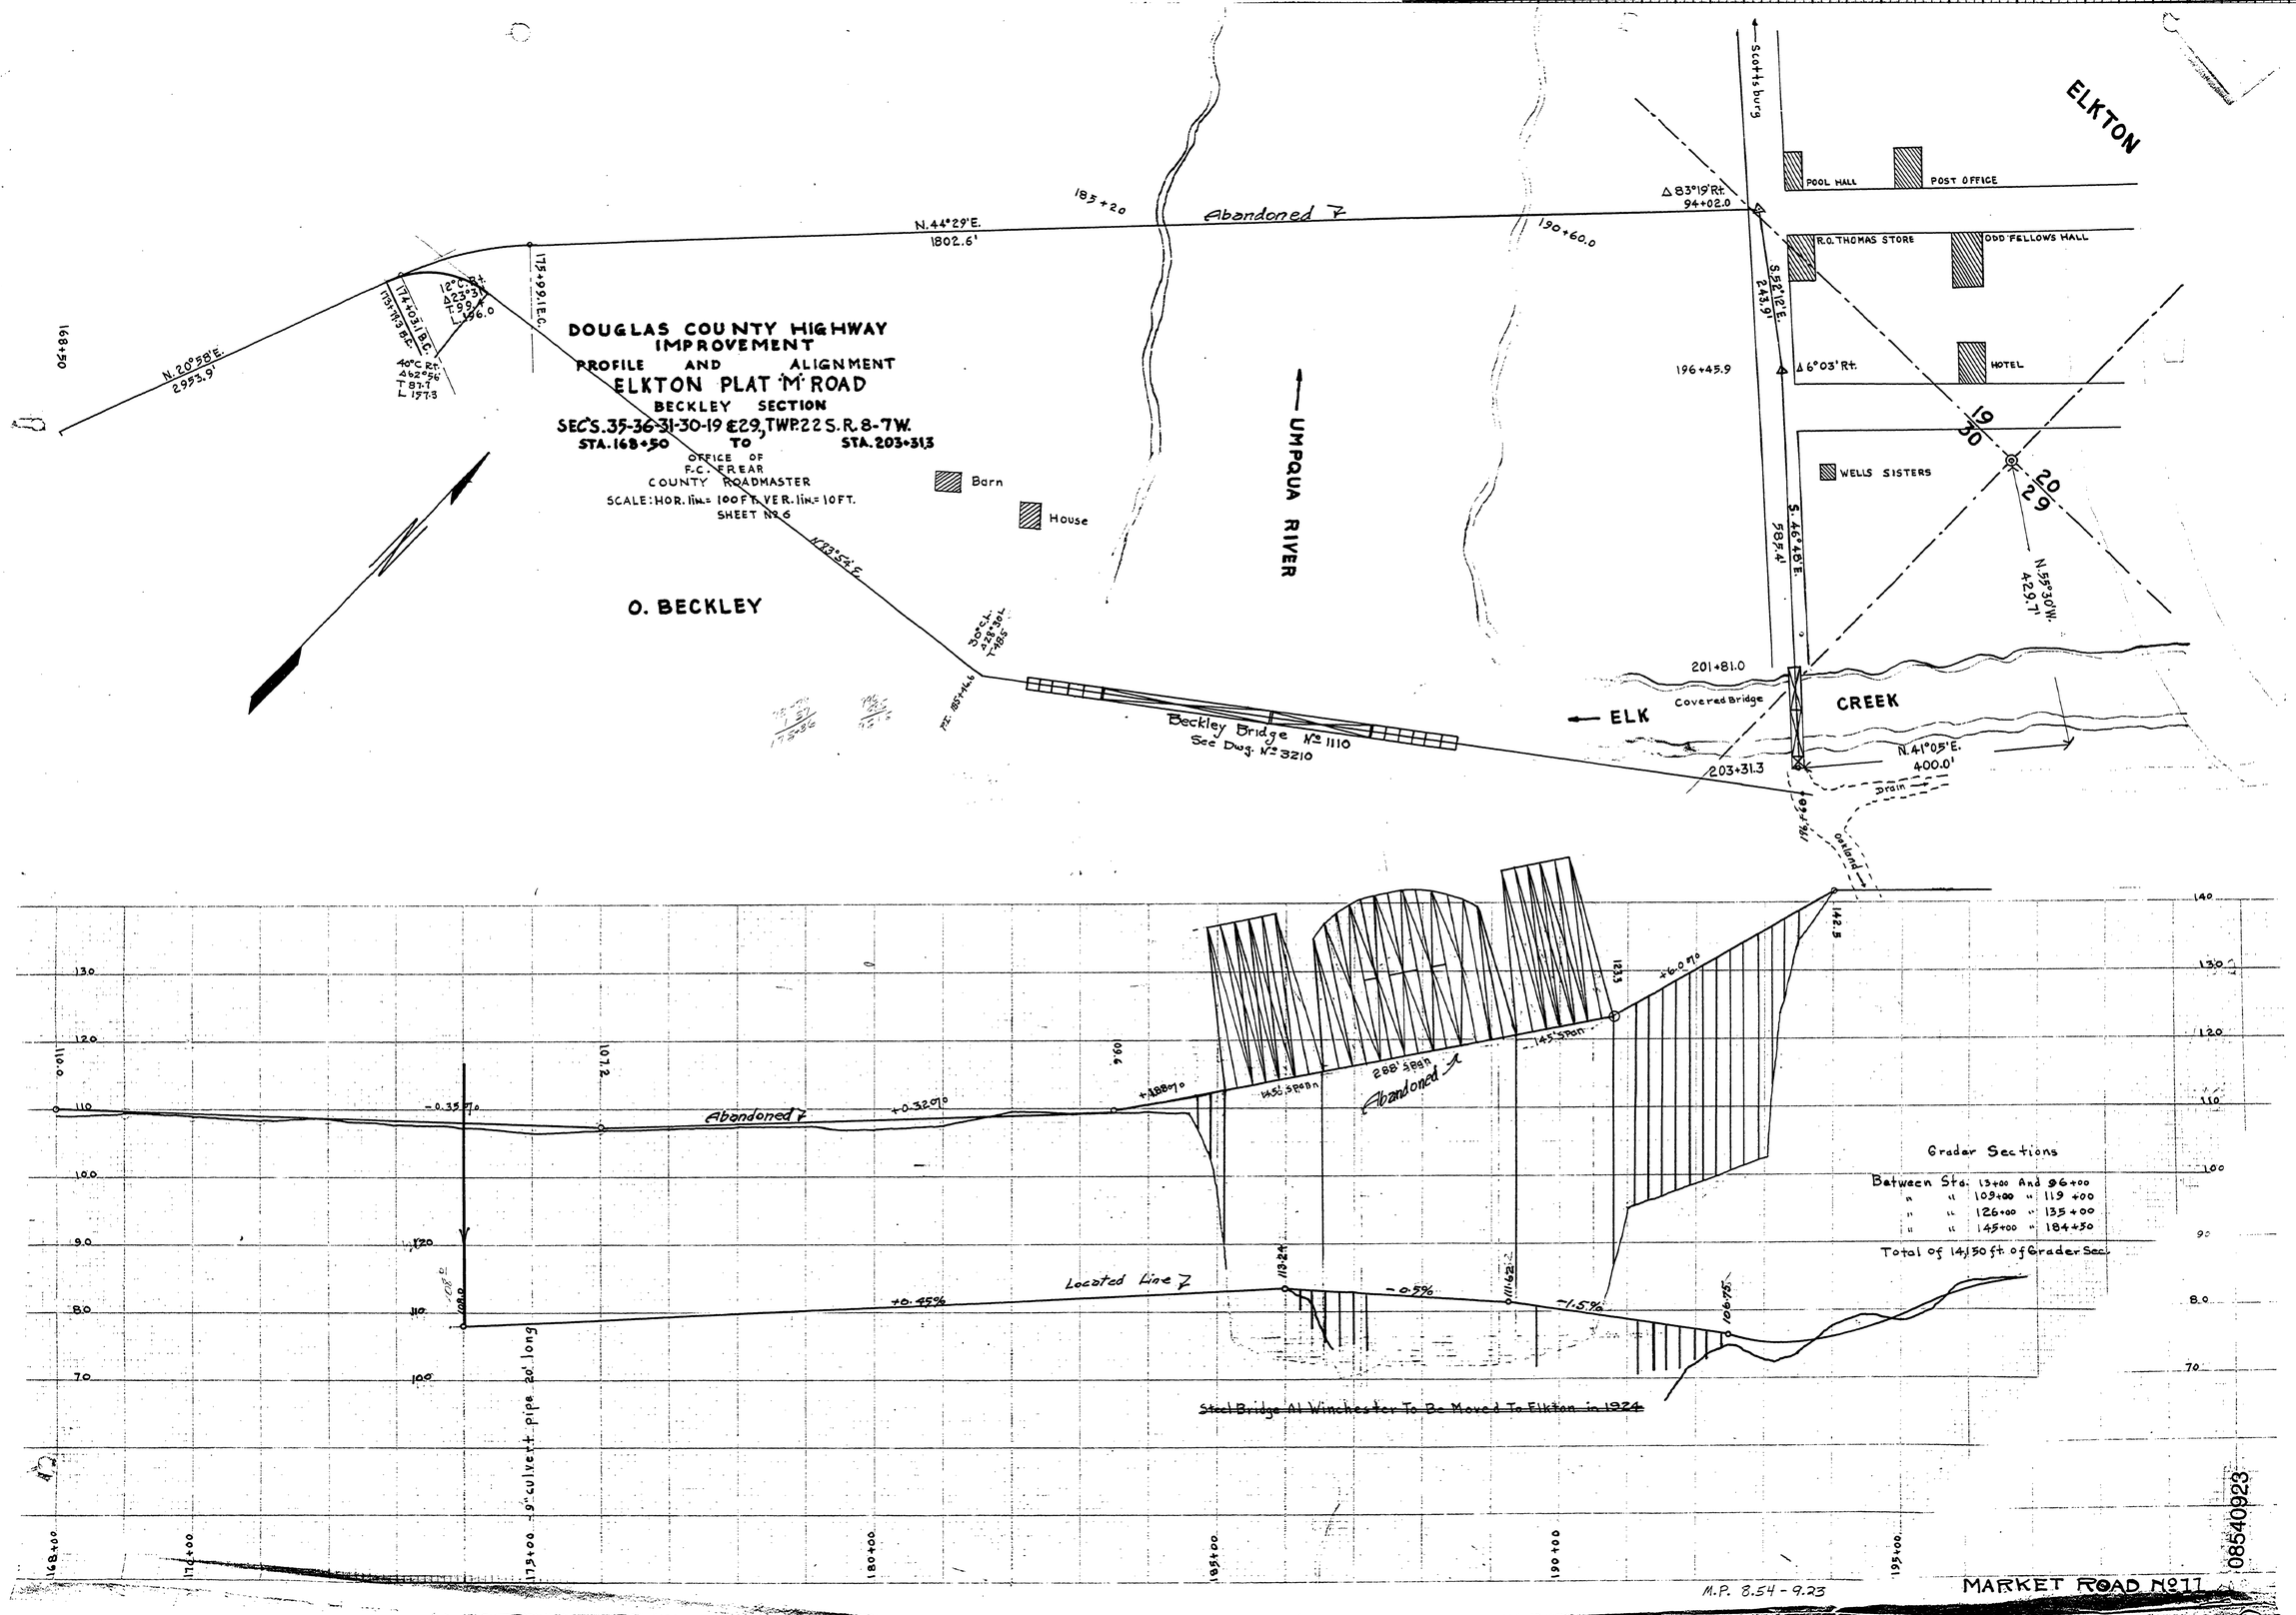
DOUGLAS COUNTY HIGHWAY IMPROVEMENT
PROFILE AND ALIGNMENT
ELKTON PLAT 'M' ROAD
BECKLEY SECTION
SEC'S. 35-36-31-30-19 & 29, TWP. 22 S. R. 8-7 W.
STA. 168+50 TO STA. 203+31.3
OFFICE OF
F. C. ERREAR
COUNTY ROADMASTER
SCALE: HOR. 1in.= 100 FT. VER. 1in.= 10 FT.
SHEET No. 6
N. 20°58' E.
2993.9'
168+50
N. 44°29' E.
1802.6'
175+99.1 E.C.
183+20
Abandoned
190+60.0
Barn
House
O. BECKLEY
UMPQUA RIVER
Beckley Bridge No. 1110
See Dwg. No. 3210
203+31.3
ELK
CREEK
Covered Bridge
201+81.0
N. 41°05' E.
400.0'
Drain
Scottsburg
Δ 83°19' Rt.
94+02.0
S. 52°12' E.
243.9'
196+45.9
Δ 6°03' Rt.
S. 46°48' E.
585.4'
POOL HALL
POST OFFICE
R.O. THOMAS STORE
ODD FELLOWS HALL
HOTEL
WELLS SISTERS
ELKTON
19
30
20
29
N. 53°30' W.
429.7'
Located Line
Abandoned
Steel Bridge At Winchester To Be Moved To Elkton In 1924
Grader Sections
Between Sta. 13+00 And 96+00
" " 109+00 " 119+00
" " 126+00 " 135+00
" " 145+00 " 184+50
Total of 14,150 ft. of Grader Sec.
M.P. 8.54 - 9.23
MARKET ROAD No. 77
08540923