


**DOUGLAS COUNTY HIGHWAY  
IMPROVEMENT  
MARKET ROAD No 12**  
 WINDY CREEK BRIDGE NO. M12-0.55  
 GLENDALE STEEL BRIDGE NO. M12-0.4  
 GLENDALE SECTION OF M.R. No 12  
 Sec. 4 T335 R6W W.M.

F.C. Frear County Engr.  
 Feb. 1927  
 Scale 1" = 50' Hor.  
 1" = 5' Ver.

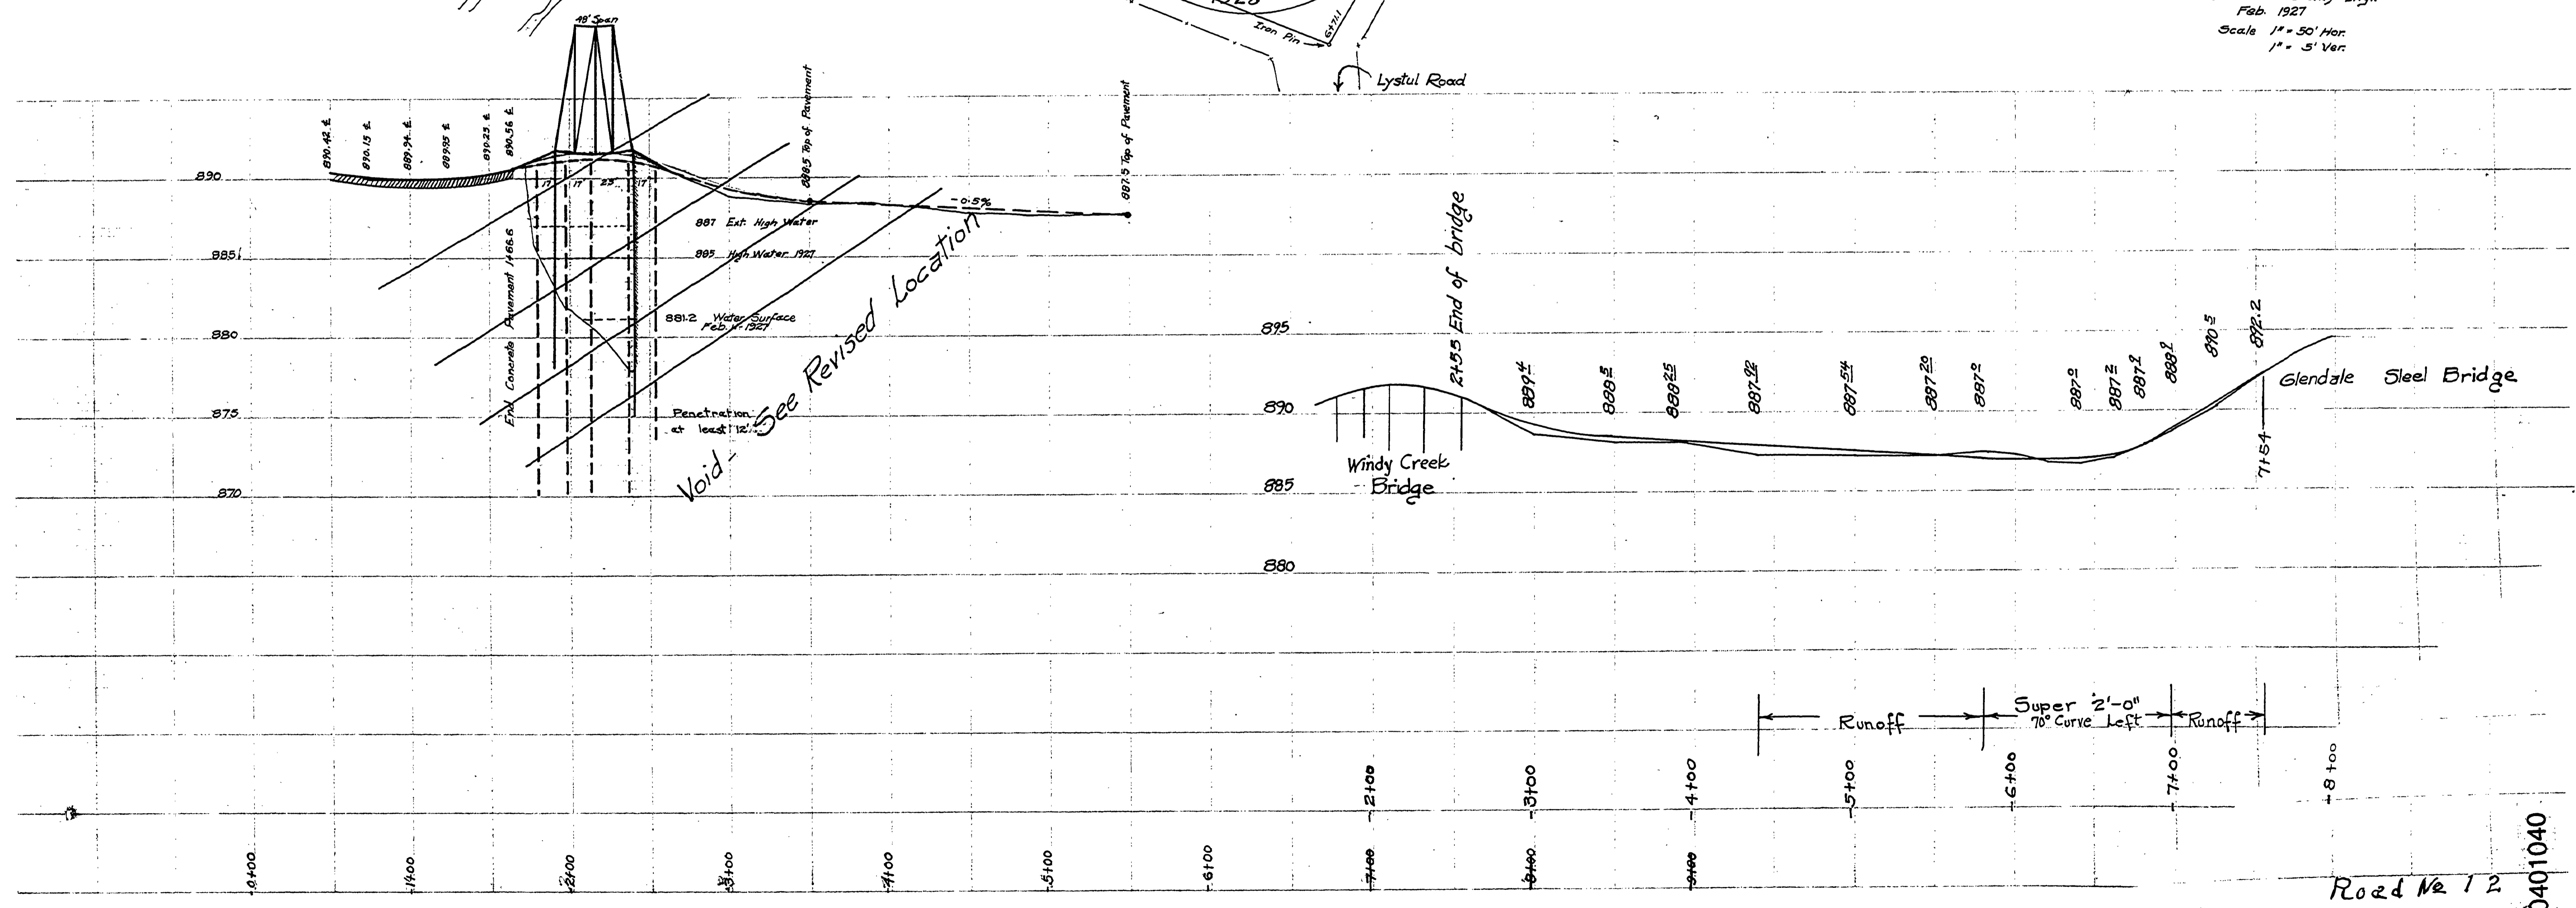

Road No 12  
 0401040

M.P. 10.40