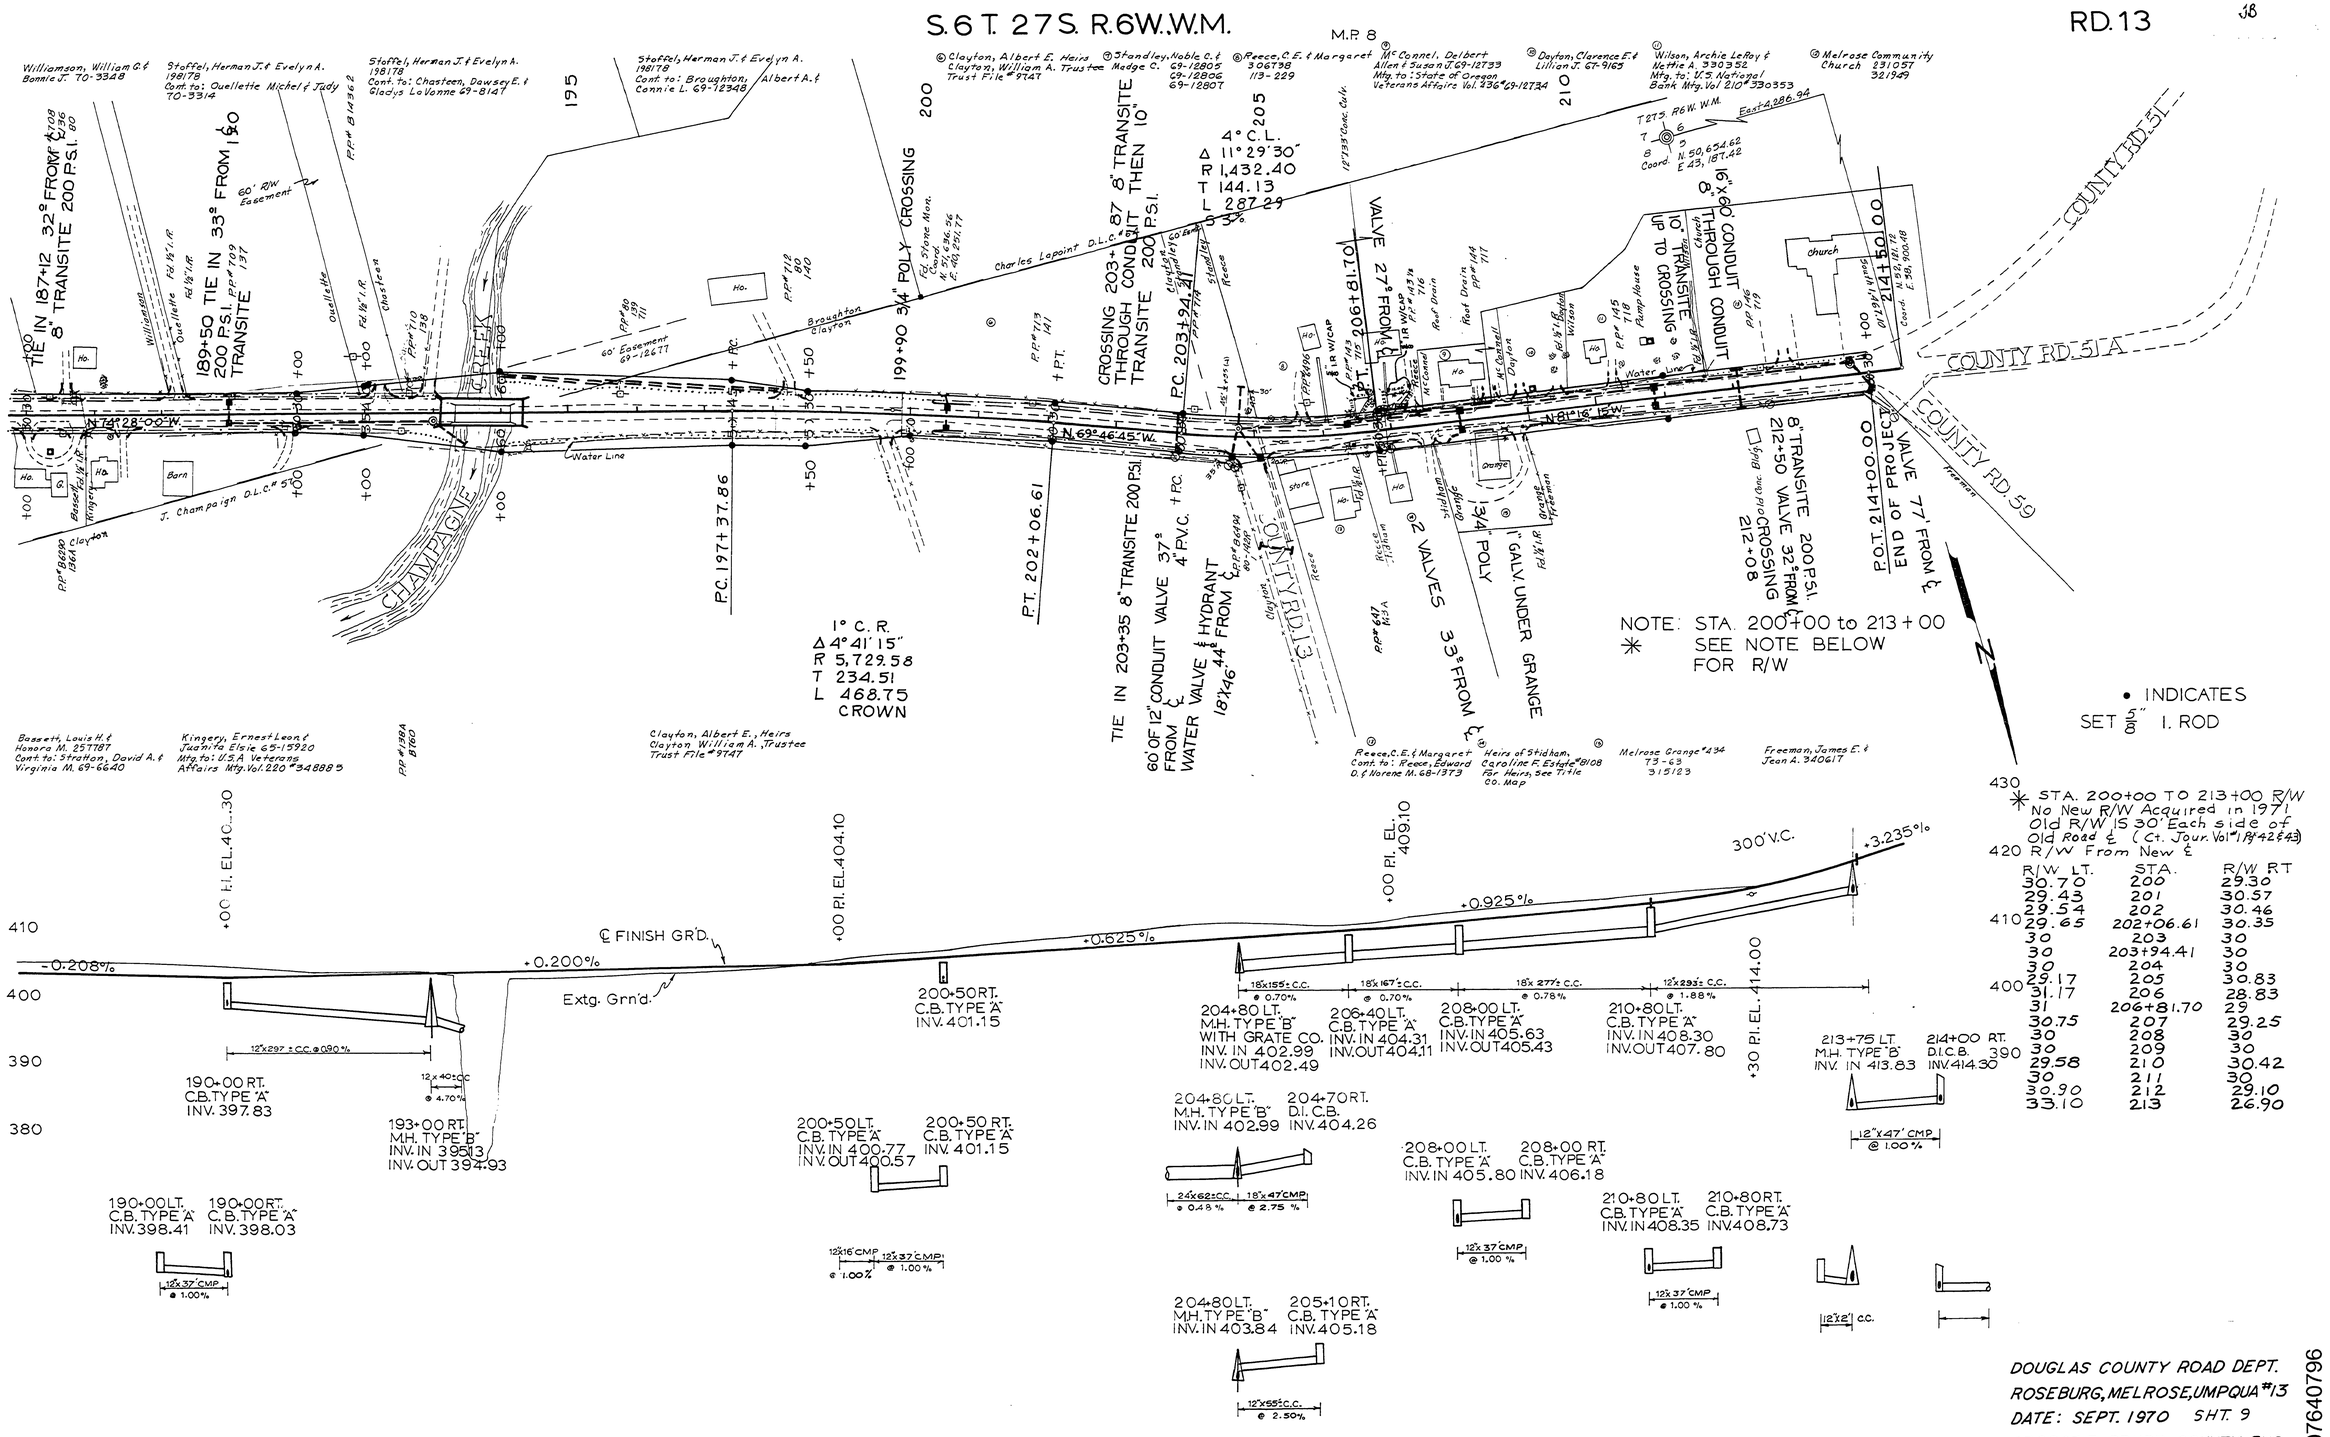

DOUGLAS COUNTY ROAD DEPT.
ROSEBURG, MELROSE, UMPQUA #13
DATE: SEPT. 1970 SHT. 9
GEORGE E. GRUBB COUNTY ENG.

07640796

Rd. # 13