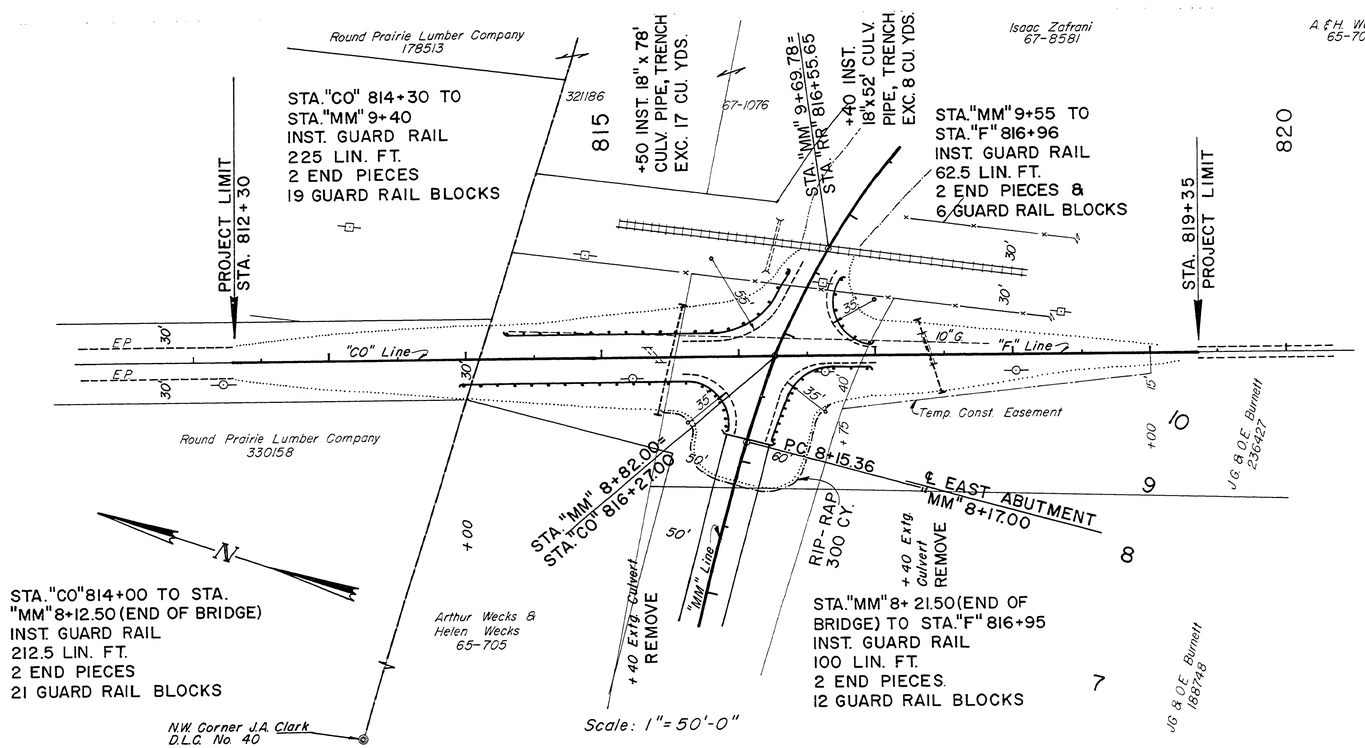

Secs. 1 & 2 T.29S R.6W W.M.

PIPE LIST						
STATION	DIAMETER	LENGTH	MATERIALS: 16 Ga. Galv. Steel, Asph. Coated, Corr.	MATERIALS: Class III Concrete	TRENCH EXC. CU. YDS.	REMARKS
"MM" 10+15	18"	60'	✓	✓	10	CULVERT PIPE
"MM" 15+97	18"	50'	✓	✓	8	" "
"CO" 815+50	18"	78'	✓	✓	17	" "
"F" 817+40	18"	52'	✓	✓	8	" "

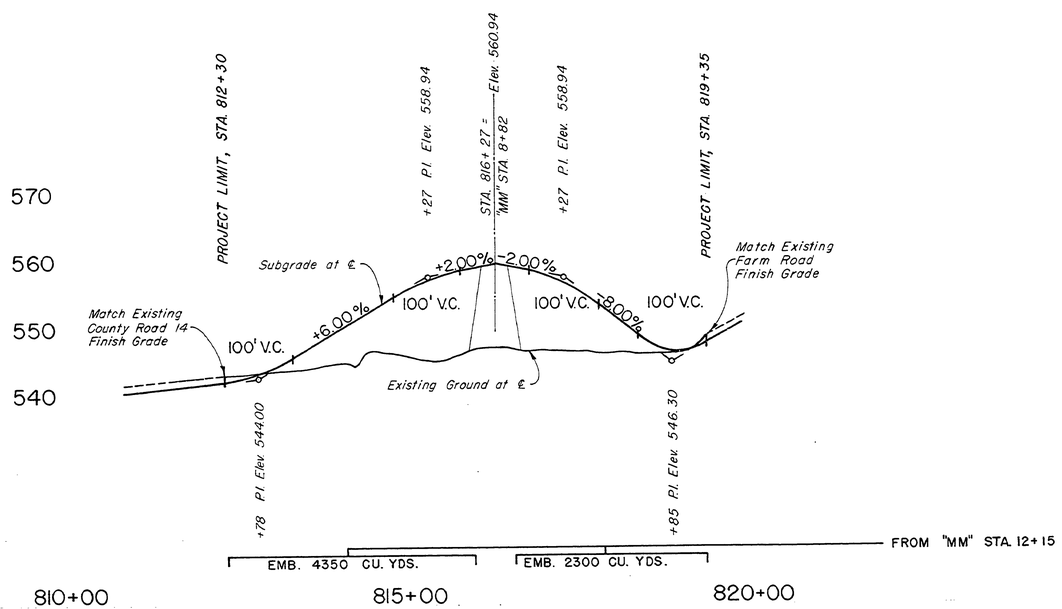

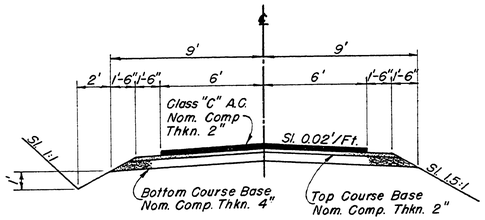

TYPICAL SECTION FOR FARM ROAD
STA."F" 816+27 TO 819+35

AS CONSTRUCTED - 1-6-70

OREGON BRIDGE ENGINEERING COMPANY
CONSULTING ENGINEERS EUGENE, OREGON

Douglas County Road Department
COUNTY ROAD NO. 14
May 1969 Sheet 2 of 2
GEORGE E. GRUBB County Engineer

PLAN AND PROFILE

DRN DC	DATE 5-5-69	PROJECT NO. 8-10	DWG NO. 2 of 2
CKD	DATE	FILE NO. 476	

Rd # 14 MAY, 1969 Sht. 2 of 2 (16)

0000INTS