


NORTH MYRTLE CREEK
 ROAD No. 15.
 SEC. 7. 8. T29 S, R4 W, W.M.
 DOUGLAS COUNTY, OREGON.
 SEPTEMBER, 1953.
 SCALE 1" = 100'
 SHEET No. 4 OF 7.

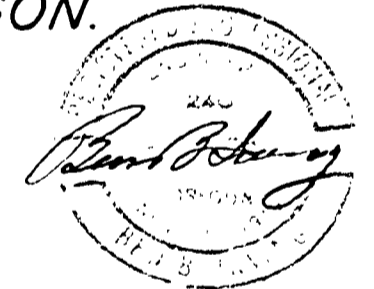

NOTE:-
 BEARINGS SHOWN ARE TRUE, BASED ON SOLAR
 OBSERVATION MADE JULY 22, 1953.
 ○ = 3/4" IRON ROD ON RIGHT OF WAY LINE.
 ● = "P.K." NAIL ON CENTER LINE.
 ⊙ = BOLT OR BRIDGE SPIKE.

ADOPTED, BY ORDER OF THE COUNTY COURT, IN ACCORDANCE WITH
 ORS. 368.585, - 368.590, - 368.595, - 368.600, AND 368.605, BY RESO-
 LUTION DATED APRIL 2, 1954.

W. A. Hill COUNTY JUDGE.
L. V. Buckley COMMISSIONER.
E. R. Metzger COMMISSIONER.

04810540

M.P. 4.81-5.40

Pg 10 JUL 1953 11 00 07

