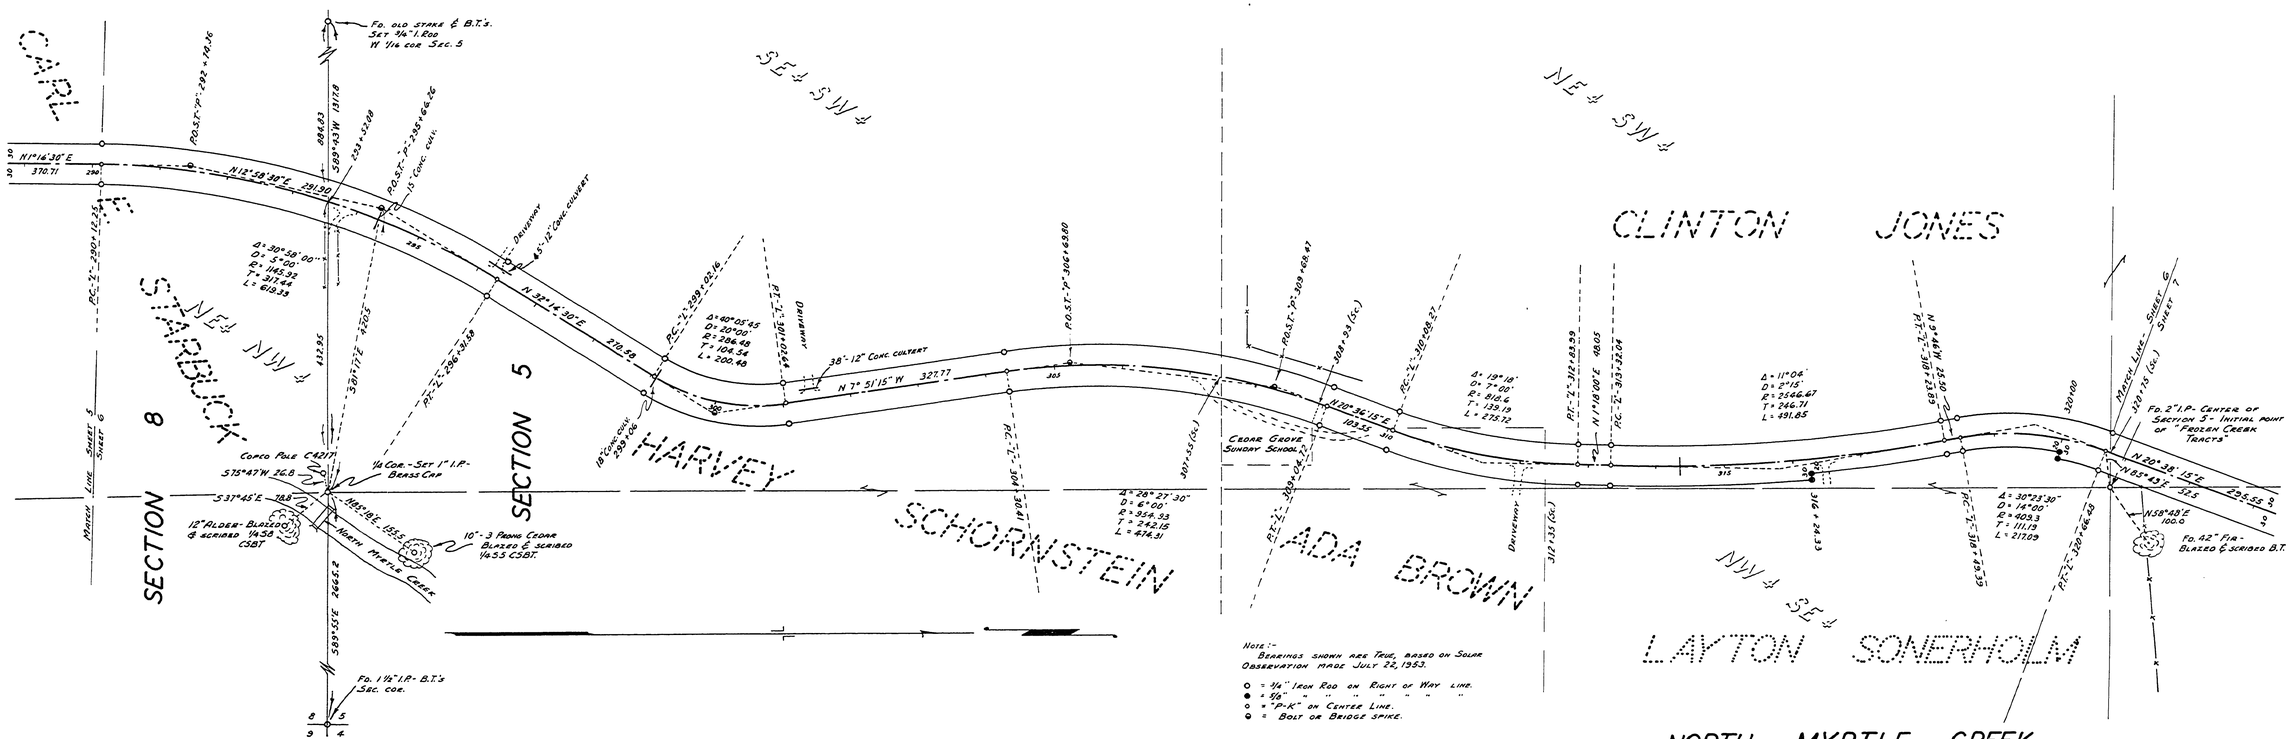

NORTH MYRTLE CREEK
ROAD Nº. 15.
SEC. 8, 5, T29 S, R4 W, W.M.
DOUGLAS COUNTY, OREGON.
SEPTEMBER, 1953.
SCALE 1" = 100'
SHEET Nº. 6 OF 7.

ADOPTED, BY ORDER OF THE COUNTY COURT, IN ACCORDANCE WITH ORS. 368.585 - 368.590 - 368.595 - 368.600 AND 368.605, BY RESOLUTION DATED April 2, 1958.

C. C. Hiel COUNTY JUDGE.
L. V. Buckley COMMISSIONER.
E. R. Metzger COMMISSIONER.

05870645

M.P. 5.37-6.45

R/W 15

34