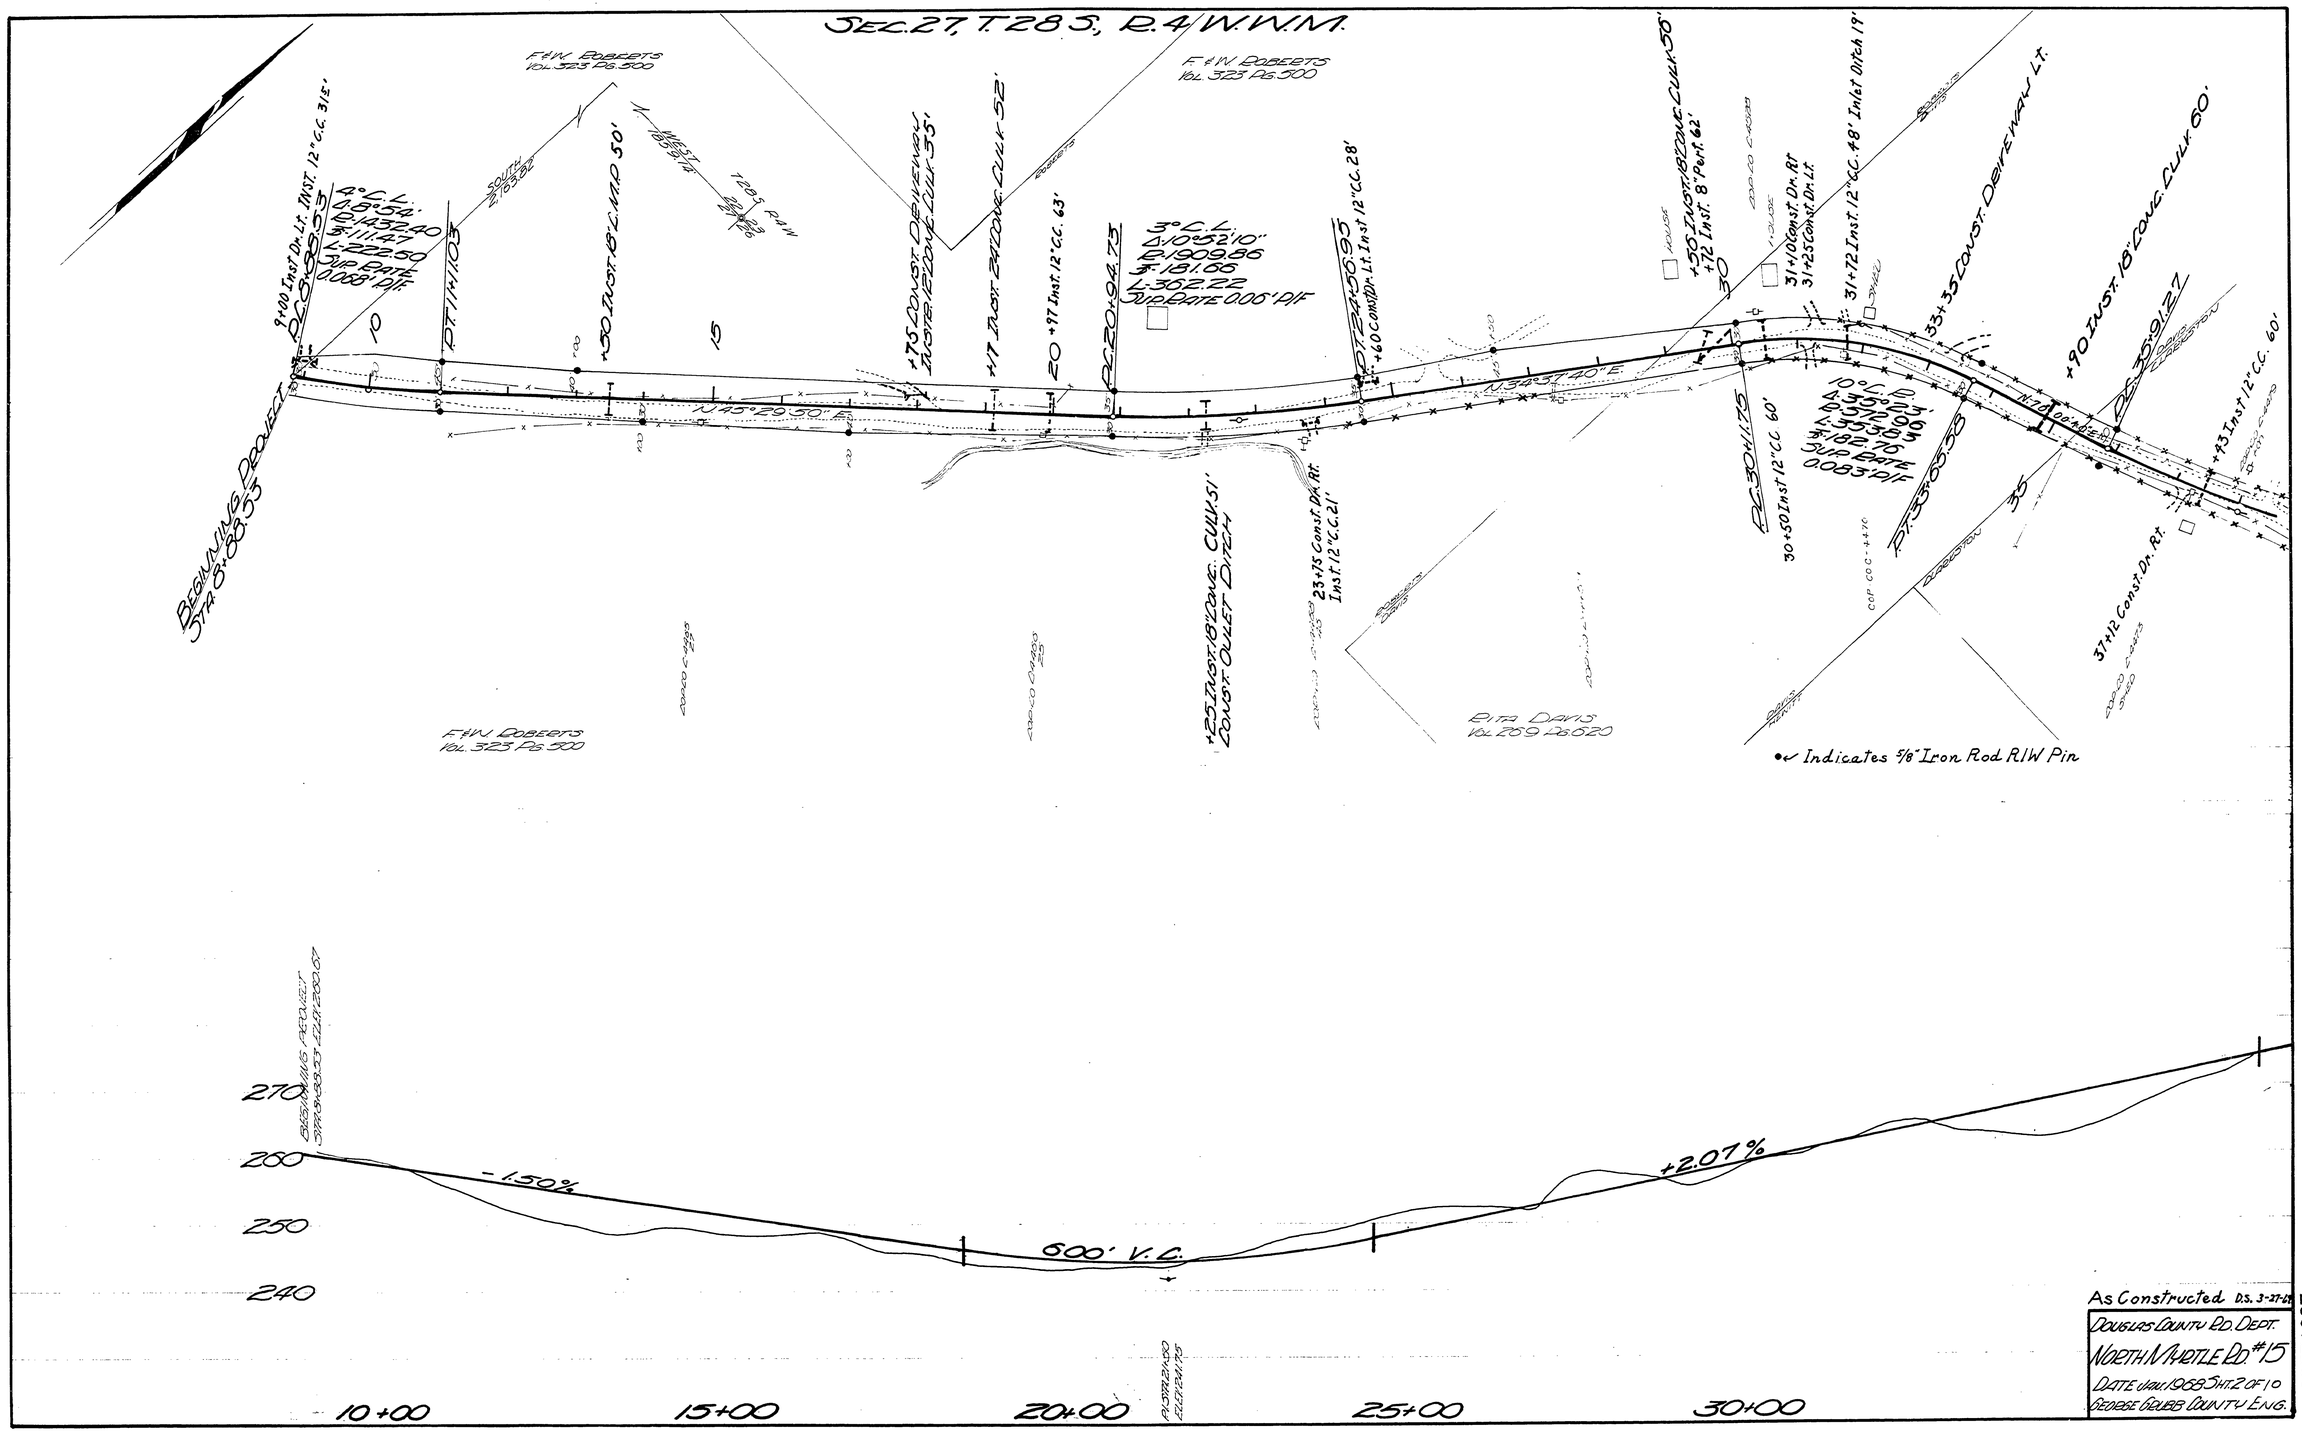

M.P. 9.77 - 10.27

Rd #15

JAN., 1968 SHT. 2 of 10

46