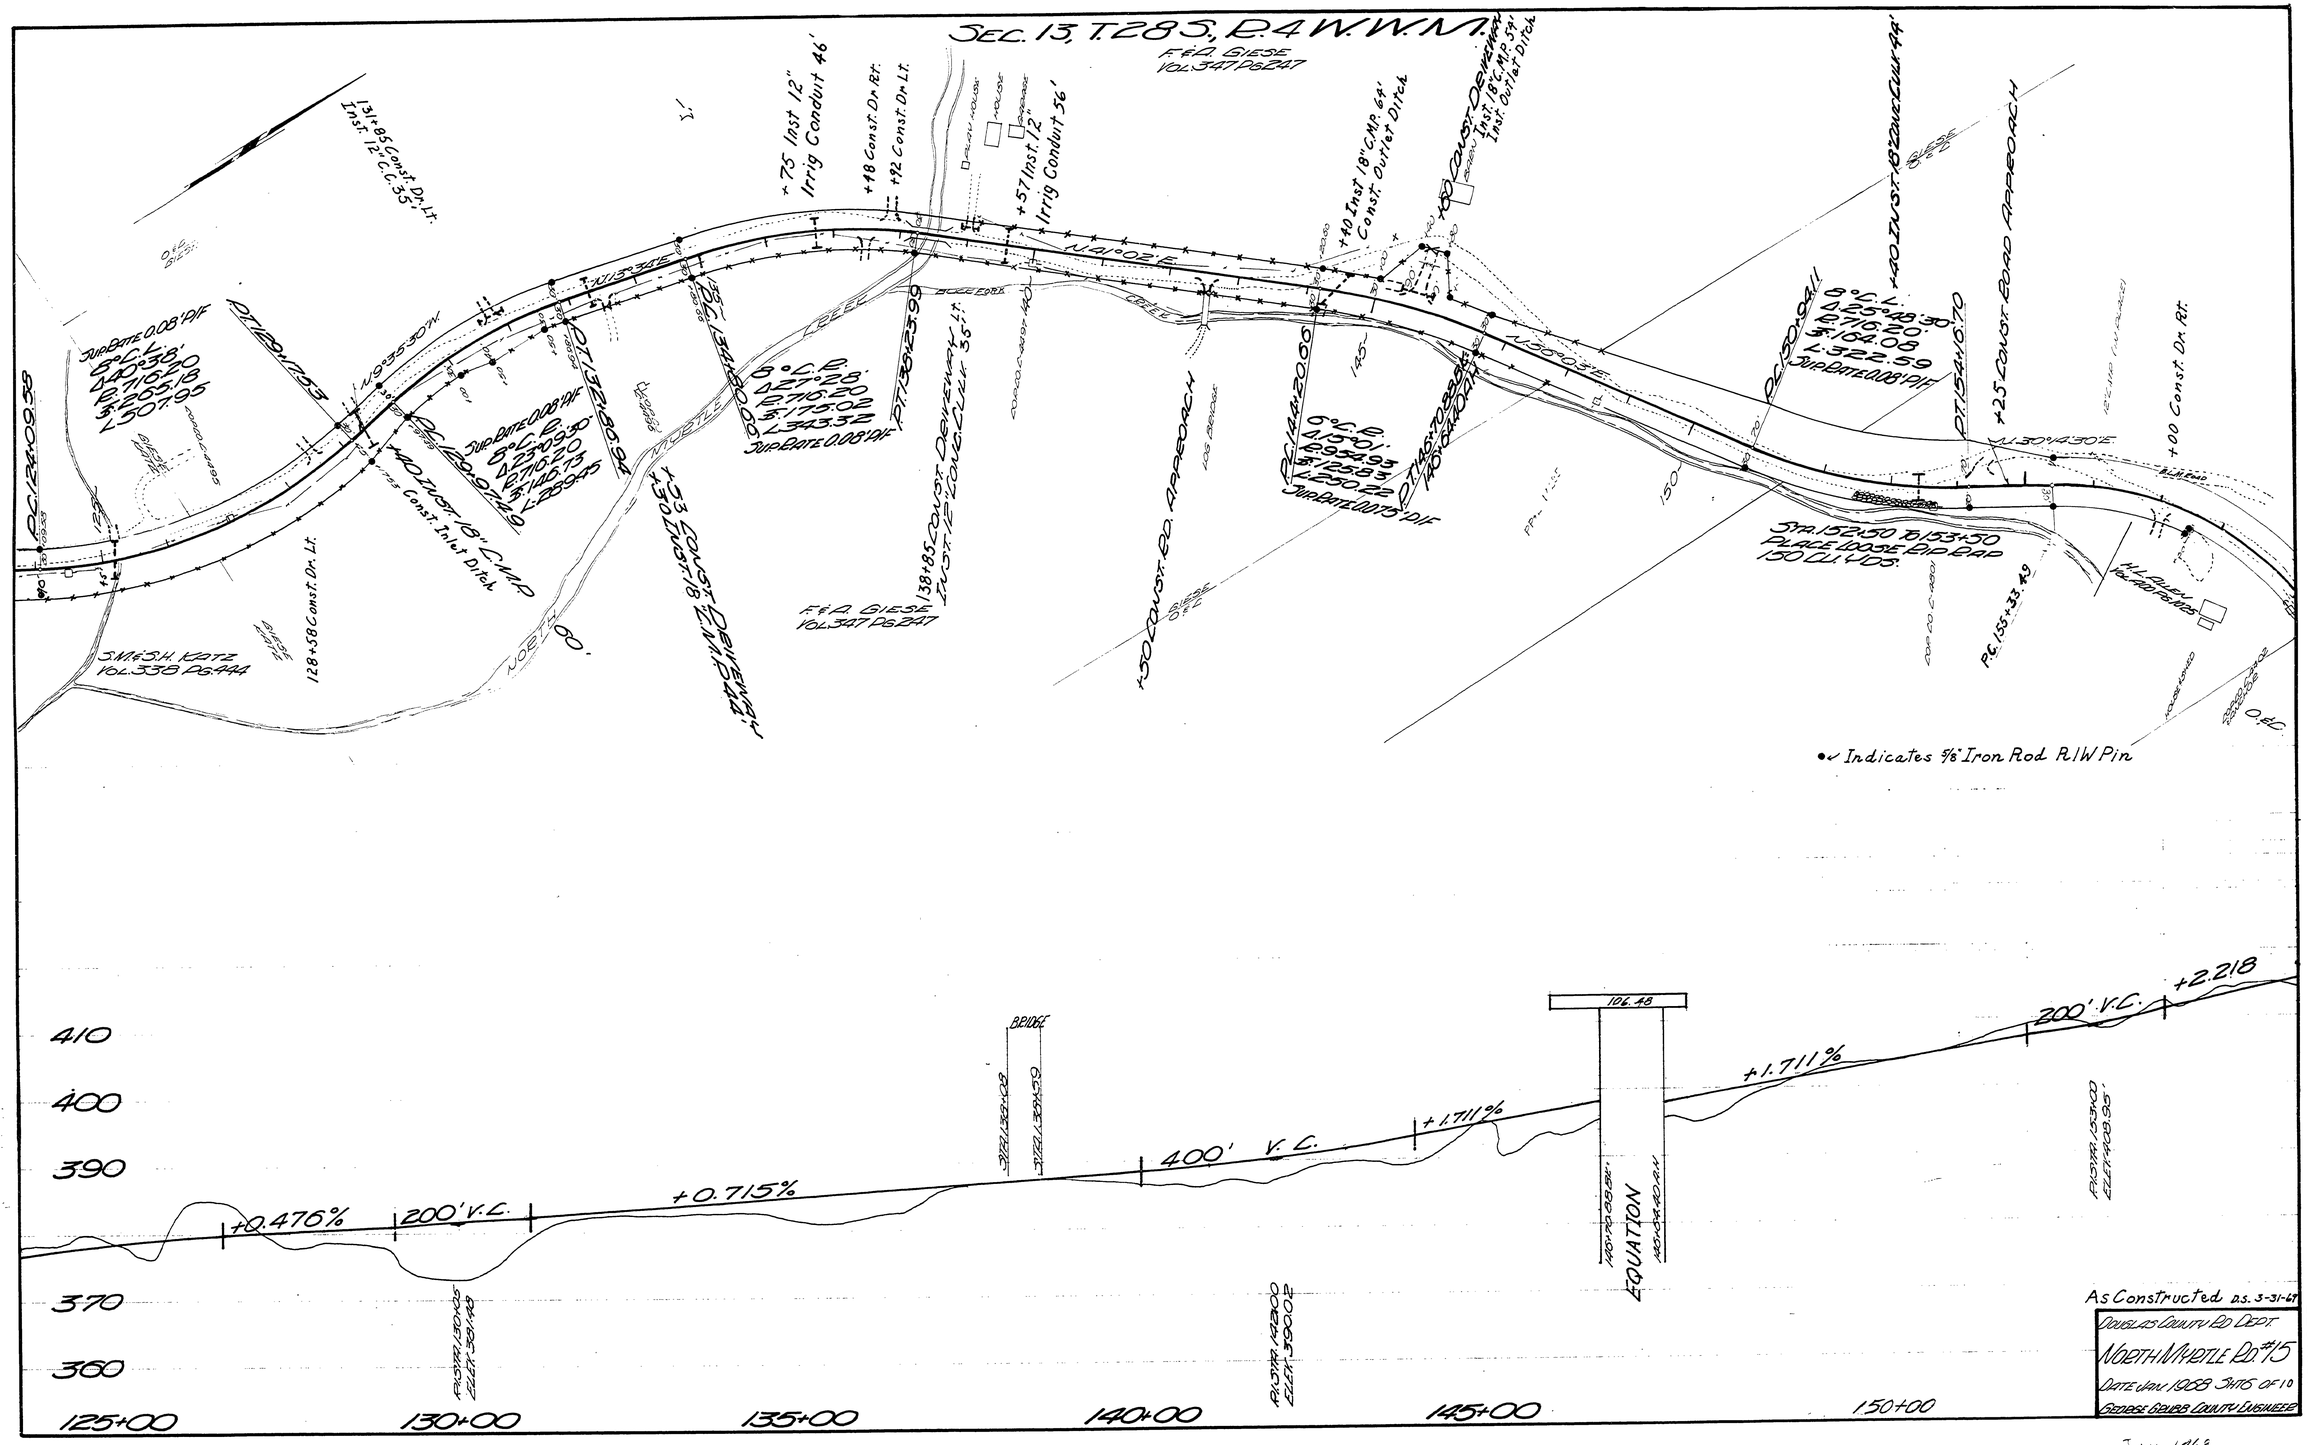

M.P. 11.98 - 12.55

Rd #15

Jan. 1968

50