SEC. 18, T.28S., R.3 W.W.M.

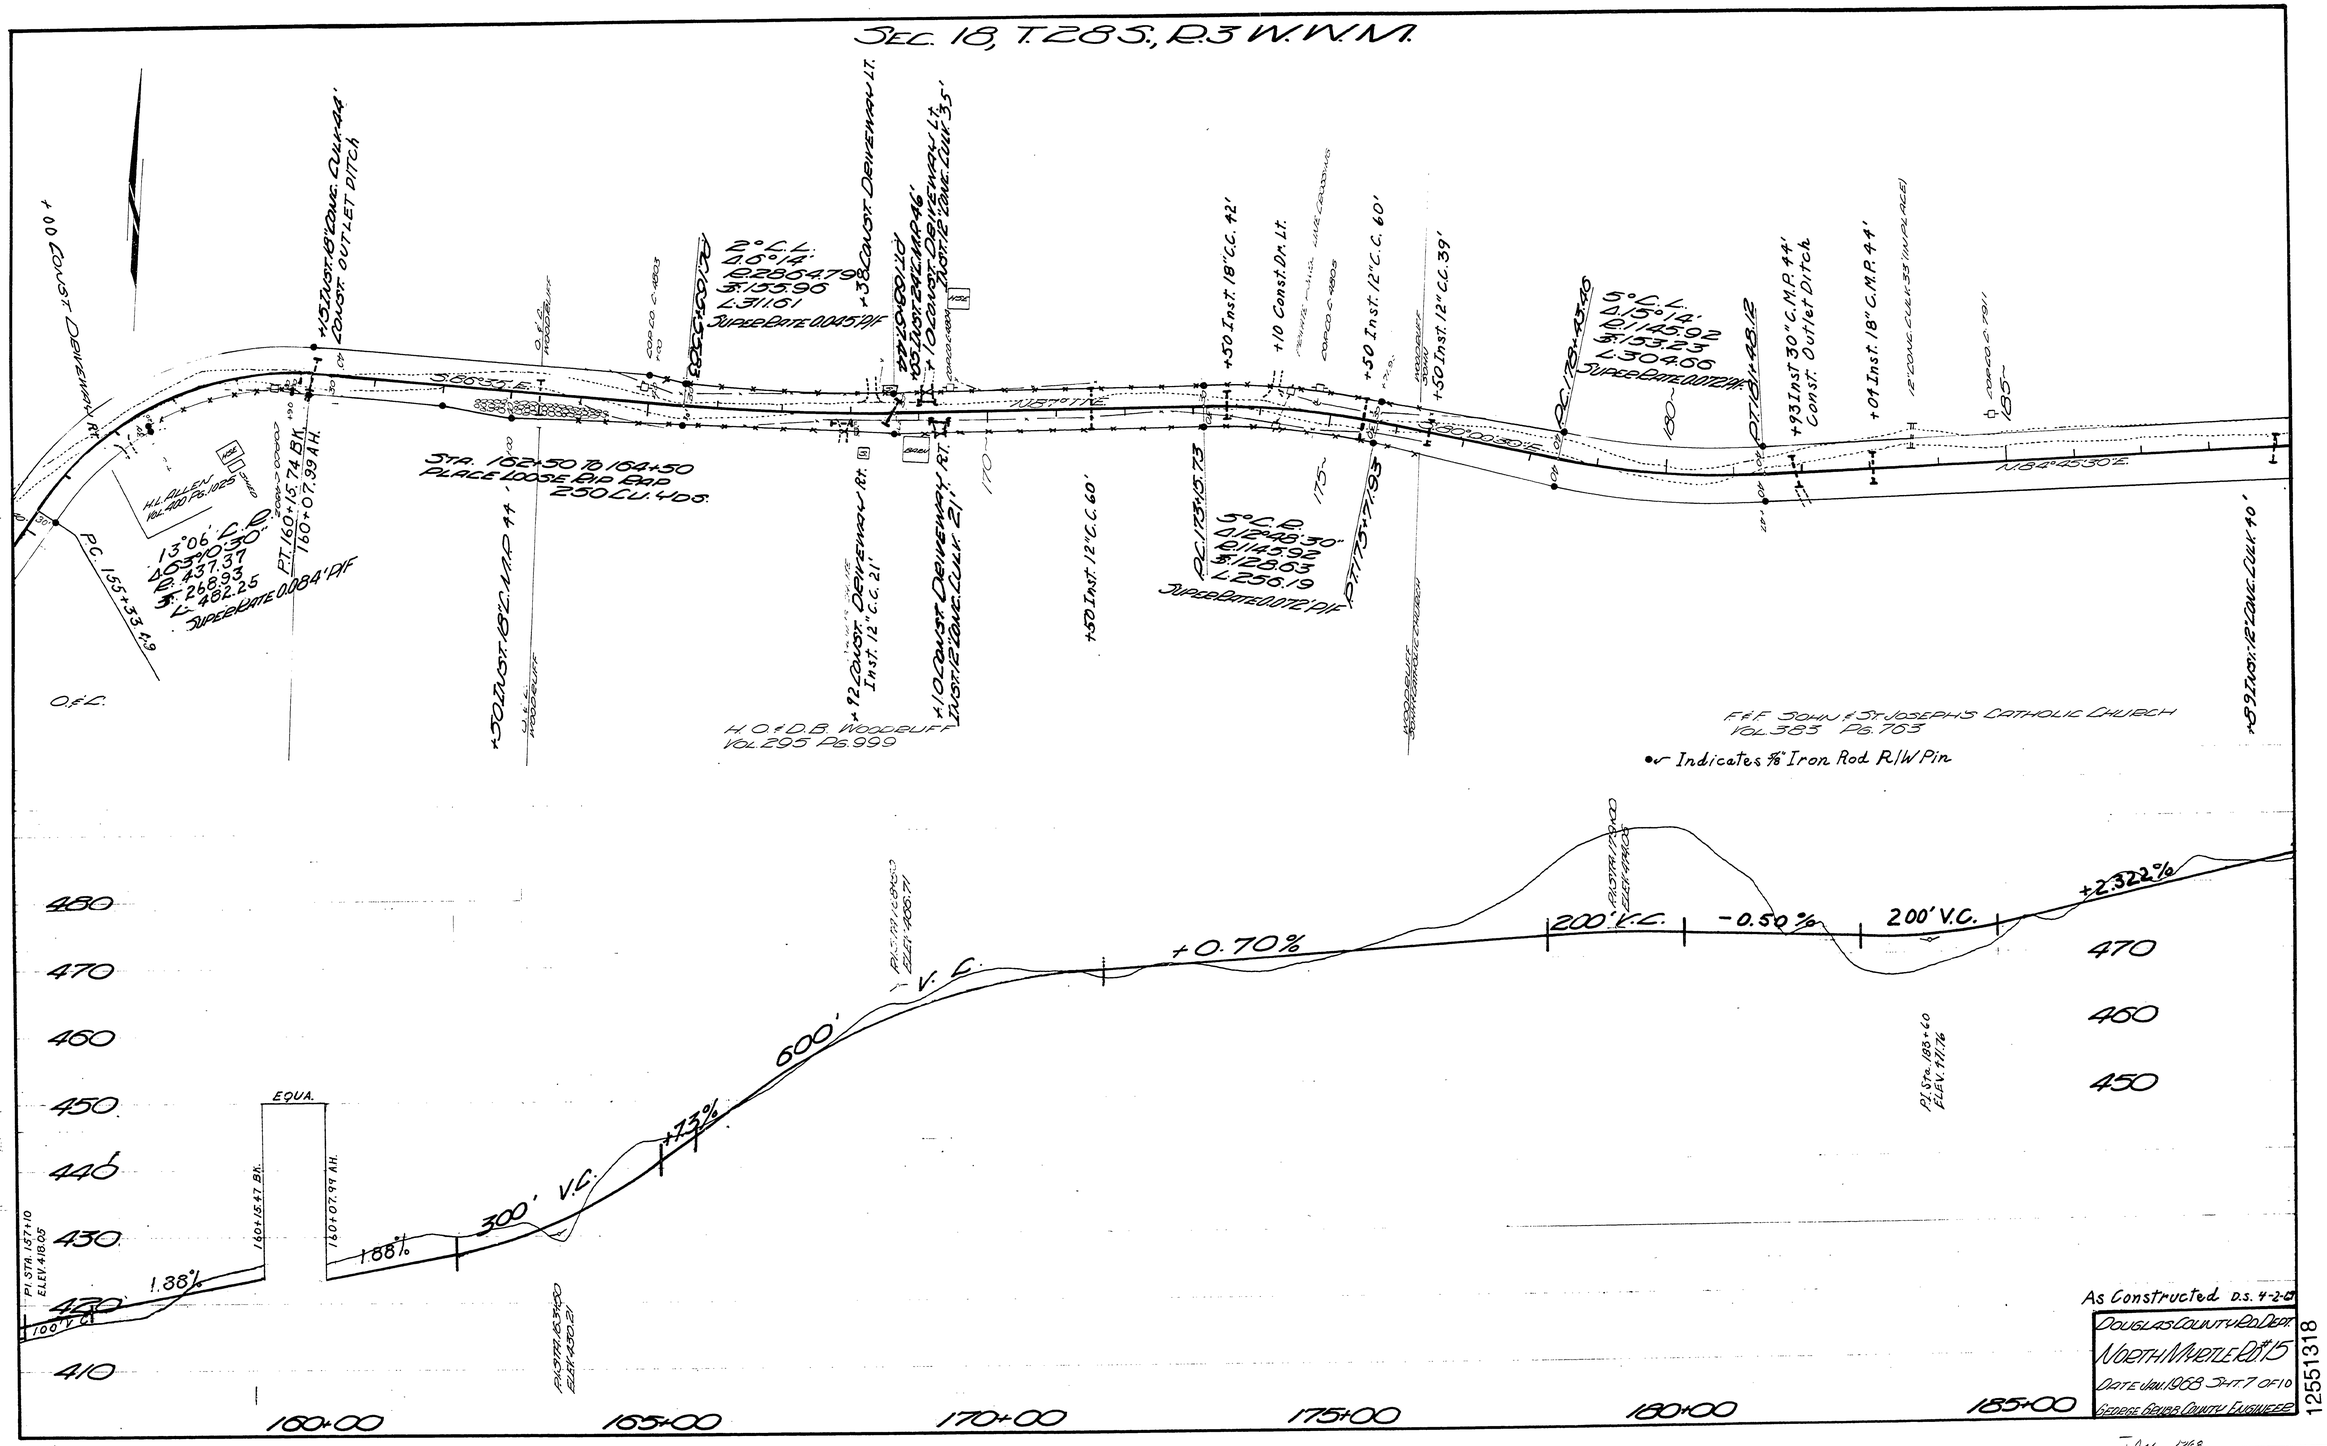

As Constructed D.S. 4-2-69

DOUGLAS COUNTY ROAD DEPT.
DATE JAN. 1968 SHT. 7 OF 10
GEORGE GRIER COUNTY ENGINEER

12551318

JAN., 1968

M.P. 12.55 - 13.18

Rd # 15

51