M.P. 11.68

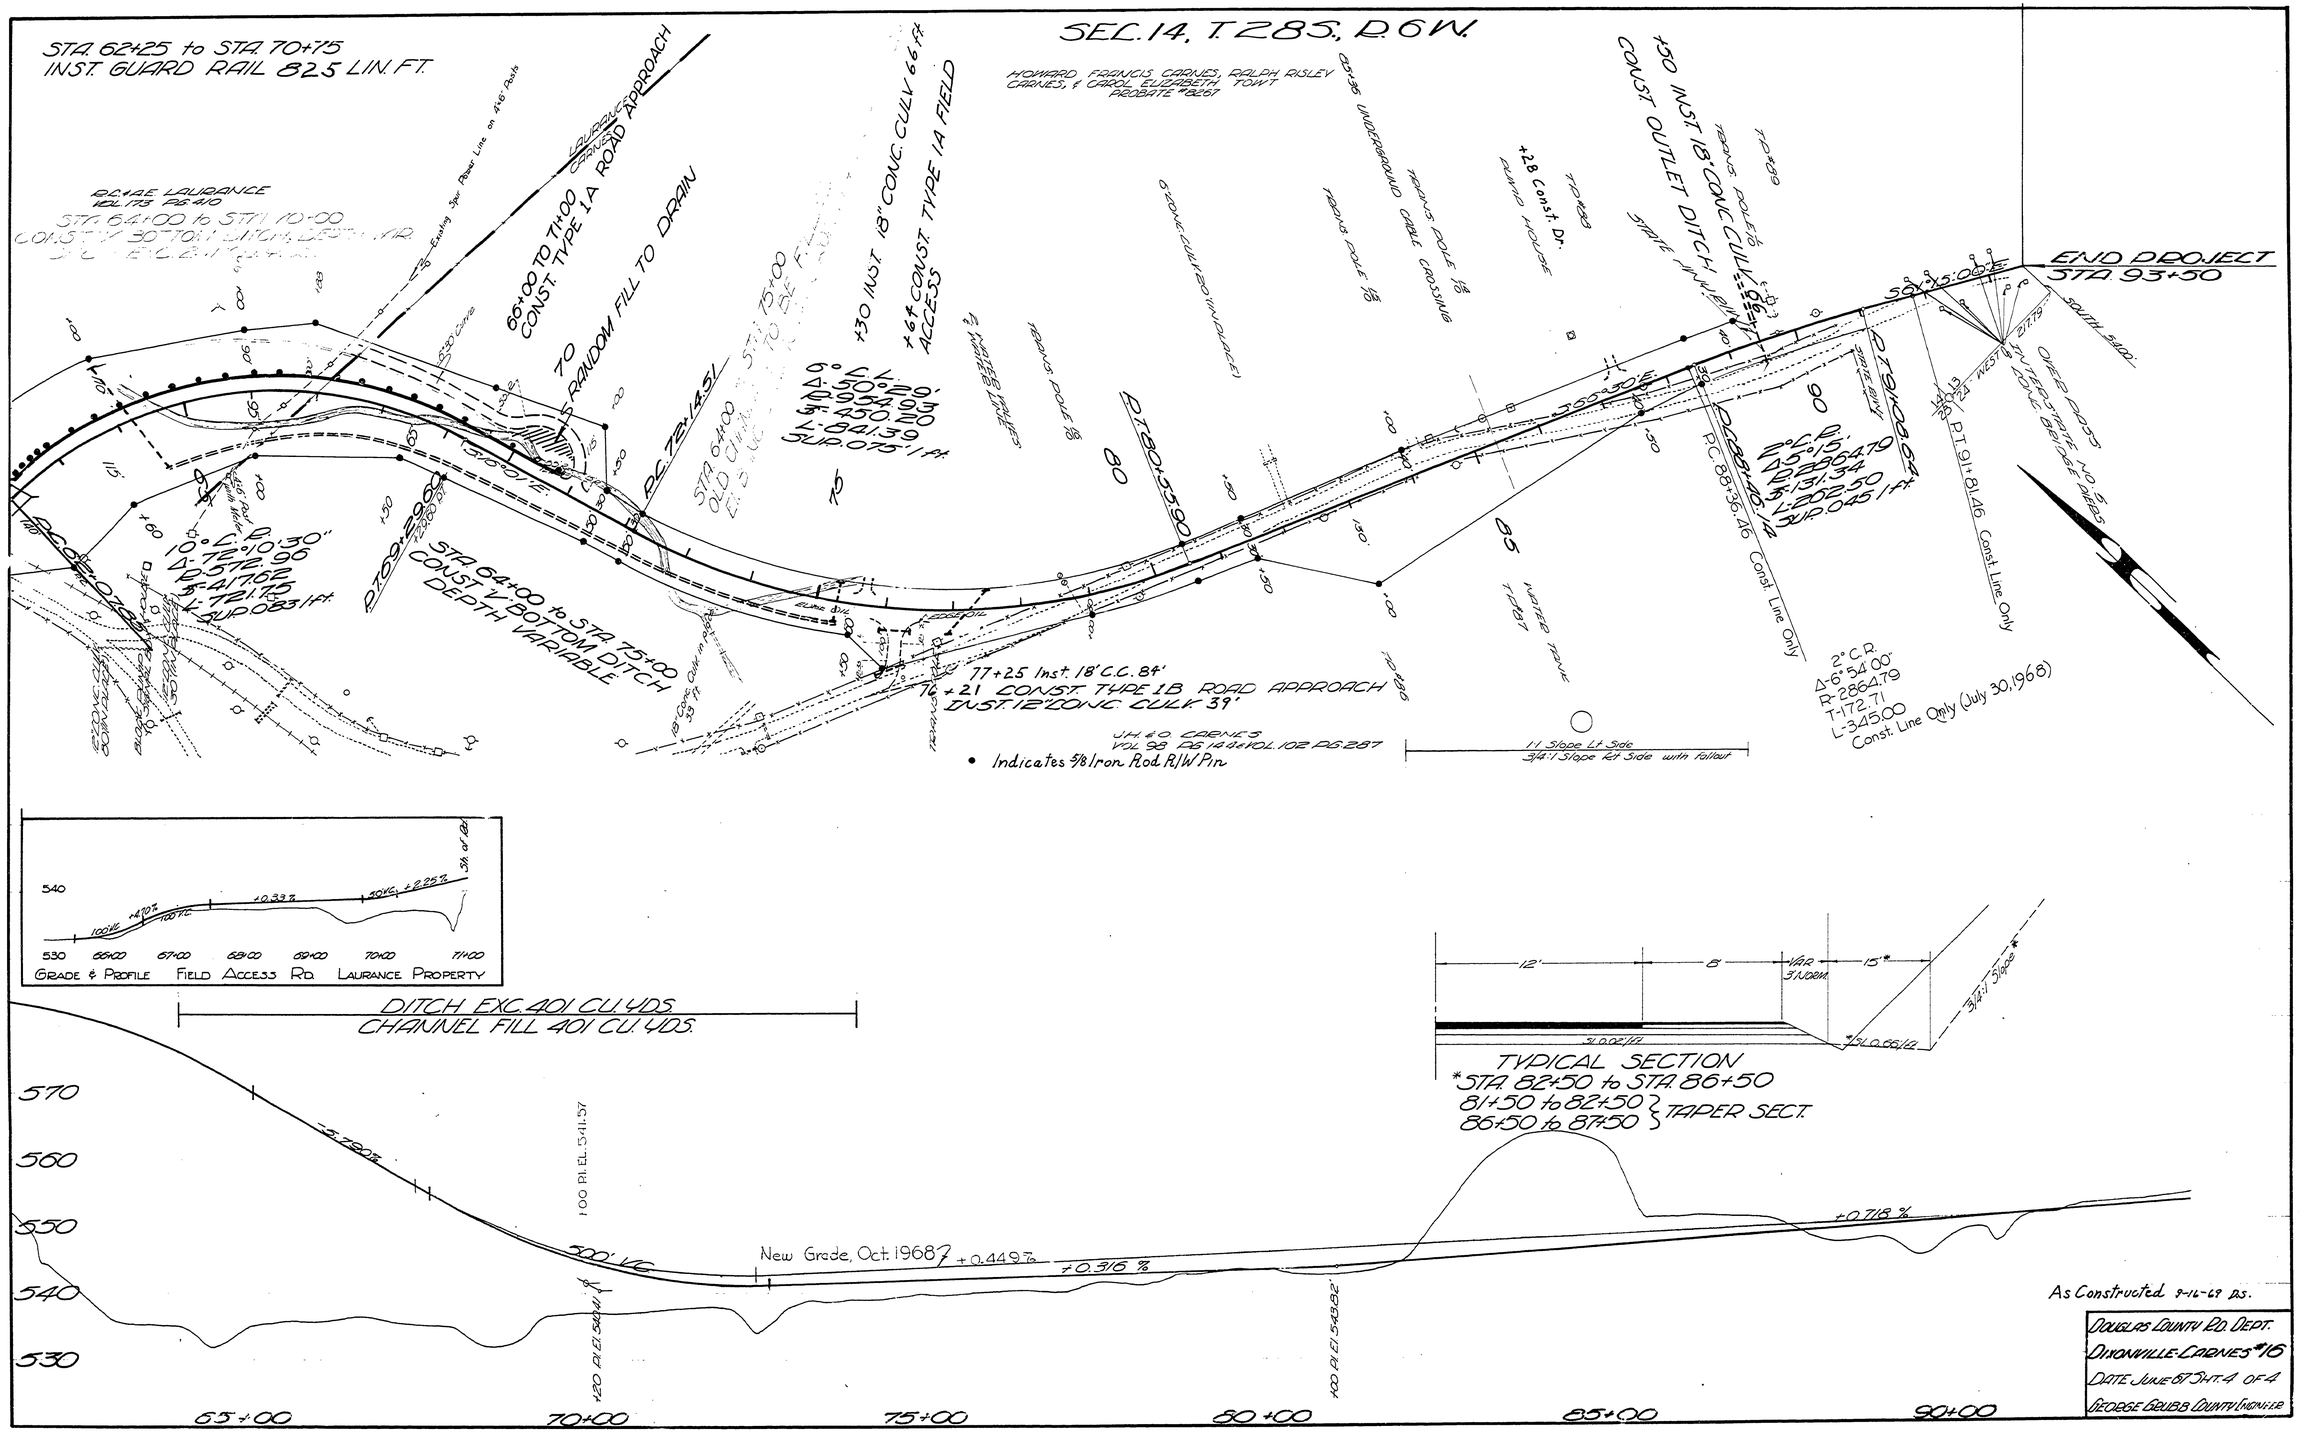

12181164

M.P. 12.18 - 11.64

Rd. # 16 June 1967 Sht. 4 of 4 (66)