



SEE PAGE 3

SEE PAGE 1

POINT #	DESCRIPTION	NORTHING	EASTING
6	CP PK WWASHER	115823.42	151098.42
7	CP IR AC	116083.66	151068.02
8	CP IR AC	116315.03	151035.23
9	CP IR AC	116608.07	150996.84
10	CP IR AC	116933.49	151020.36
11	CP IR AC	117162.99	150931.04
12	CP IR AC	117397.62	150963.36
20	CP PK WWASHER	115574.45	151051.55
127	FIP 1/2	115890.55	151163.95

POINT #	DESCRIPTION	NORTHING	EASTING
128	FIR 5/8	115589.93	150896.64
129	FIP 3/4	116050.48	151142.66
130	FIP 1 1/2	116412.75	151094.39
131	FIR 5/8	116357.91	151039.88
132	FIR 5/8	116358.10	151027.75
133	FIR 5/8	116613.11	150641.66
134	FIR 5/8 AA	116601.06	151068.93
135	FIR 5/8	116801.50	151042.26
136	FIR 5/8	116890.86	151029.80

POINT #	DESCRIPTION	NORTHING	EASTING
138	FIR WELDED	116894.11	150968.14
139	1" SQUARE ROD	117345.74	150907.45
155	AXLE	116608.35	151006.69
156	FIR 5/8	116609.72	150876.37
157	FIR 5/8	116811.10	150801.24
158	FIR 5/8	116611.96	150726.43
165	FIP 3/4	115589.65	151144.00
170	FIR 5/8	115530.01	151151.74
172	FIP 3/4	115709.02	151128.01

POINT #	DESCRIPTION	NORTHING	EASTING
173	FIR 5/8 YPC	115708.59	151115.91
177	FIR 5/8	116683.22	151058.09
178	FIR 5/8	116667.70	151204.92
179	FIR 5/8	116666.58	151256.09
180	FIR 5/8 AA SURV	116596.99	151278.73
181	FIP 1/2	117007.15	150953.39
182	FIR 5/8	117212.77	150986.36

**LEGEND**

- FOUND MONUMENT AS DESCRIBED IN POINT TABLE
- CONTROL MONUMENT - 1/2" IRON ROD w/ALUMINUM OR RED PLASTIC CAP STAMPED "IE CONTROL"
- LOT LINE LOCATIONS (APPROXIMATE) (DOUGLAS COUNTY ASSESSOR DATA)
- CP CONTROL POINT
- FAC FOUND ALUMINUM CAP
- PC PLASTIC CAP
- PK MAG NAIL
- FIR FOUND IRON ROD
- FIP FOUND IRON PIPE
- FBC FOUND BRASS CAP
- YPC YELLOW PLASTIC CAP

**NARRATIVE:**

THE PURPOSE OF THIS MAP IS TO SHOW MONUMENTS OF RECORD FOUND ALONG CARNES ROAD (COUNTY ROAD NO. 16) PRIOR TO CONSTRUCTION. THIS SURVEY WAS PERFORMED BY JEREMY LEONARD, DARRELL JONES AND DEREK FEIGEL USING A COMBINATION OF TOPCON GPS, TOTAL STATION AND DATA COLLECTION EQUIPMENT. DRAFTING WAS PERFORMED BY DEREK FEIGEL.

**BASIS OF BEARING:**


BASIS: O.C.R.S. (OREGON COORDINATE REFERENCE SYSTEM)  
 METHOD: O.R.G.N. (OREGON REAL-TIME GNSS NETWORK)  
 ZONE: COTTAGE GROVE - CANYONVILLE  
 UNITS: INTERNATIONAL FEET  
 DATUM: NAD 83 (2011)  
 EPOCH: 2010.00

**i.e.**  
 ENGINEERING  
 809 SE Pine Street  
 Roseburg, Oregon 97470  
 PHONE (541) 673-0166  
 FAX (541) 440-9392  
 email@ieengineering.com

SURVEYED FOR:  
 DAVID EVANS & ASSOCIATES  
 530 CENTER ST. NE, SUITE 605  
 SALEM, OR 97301

PAGE: 2 OF 3  
 JOB NO: 2467-13  
 DATE: 2/19/2020

**PRECONSTRUCTION MONUMENT LOCATE**  
**CARNES ROAD - COUNTY ROAD NO. 16**  
 LYING IN THE NW QUARTER OF SECTION 11, TOWNSHIP 28 SOUTH,  
 RANGE 6 WEST, WILLAMETTE MERIDIAN, DOUGLAS COUNTY, OREGON

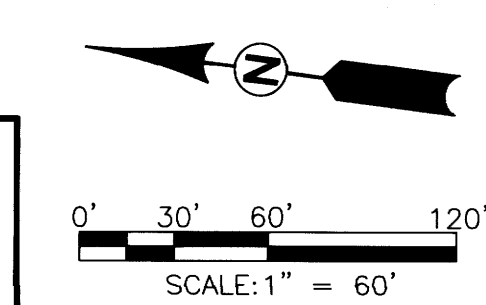

**REGISTERED PROFESSIONAL LAND SURVEYOR**  
 DEREK ALLEN FEIGEL  
 77555  
 EXPIRES: 12/31/21

13891355