

- LEGEND**
- FOUND MONUMENT AS DESCRIBED IN POINT TABLE
 - CONTROL MONUMENT - 1/2" IRON ROD w/ALUMINUM OR RED PLASTIC CAP STAMPED "IE CONTROL"
 - - - LOT LINE LOCATIONS (APPROXIMATE) (DOUGLAS COUNTY ASSESSOR DATA)
 - CP CONTROL POINT
 - FAC FOUND ALUMINUM CAP
 - PC PLASTIC CAP
 - PK MAG NAIL
 - FIR FOUND IRON ROD
 - FIP FOUND IRON PIPE
 - FBC FOUND BRASS CAP
 - YPC YELLOW PLASTIC CAP

NARRATIVE:
 THE PURPOSE OF THIS MAP IS TO SHOW MONUMENTS OF RECORD FOUND ALONG CARNES ROAD (COUNTY ROAD NO. 16) PRIOR TO CONSTRUCTION. THIS SURVEY WAS PERFORMED BY JEREMY LEONARD, DARRELL JONES AND DEREK FEIGEL USING A COMBINATION OF TOPCON GPS, TOTAL STATION AND DATA COLLECTION EQUIPMENT. DRAFTING WAS PERFORMED BY DEREK FEIGEL.


BASIS OF BEARING:
 BASIS: O.C.R.S. (OREGON COORDINATE REFERENCE SYSTEM)
 METHOD: O.R.G.N. (OREGON REAL-TIME GNSS NETWORK)
 ZONE: COTTAGE GROVE - CANYONVILLE
 UNITS: INTERNATIONAL FEET
 DATUM: NAD 83 (2011)
 EPOCH: 2010.00

FILED
 Date: 2/16/2020 By: DJ
 This survey consists of:
 Map: CO. RD. 16
 Narrative: 14261389
 Corner Rpt:
 DOUGLAS COUNTY SURVEYOR

POINT #	DESCRIPTION	NORTHING	EASTING
12	CP IR AC	117397.62	150963.36
13	CP IR AC	117576.03	150875.58
14	CP PK WWASHER	117735.92	150844.00
15	CP IR AC	118063.42	150866.95
16	CP IR AC	118286.37	150798.19
17	CP IR AC	118614.38	150914.25
18	CP IR AC	118952.62	150960.64
22	CP IR PC	118443.08	150876.40
23	CP PK WWASHER	118106.65	150551.30
139	1" SQUARE ROD	117345.74	150907.45
140	FIR 5/8	117487.60	150948.97
141	FIR 5/8	117678.58	150528.23
142	1" BOLT	117772.40	150911.38
143	FIR 3/4	117984.71	150880.73
144	FIP 1"	118063.90	150813.16
145	FIR 5/8	118082.48	150880.34
146	FIR 5/8 BROWN	118391.36	150796.71
147	FIR 5/8 BENTZ	118391.55	150803.60
148	FIR 5/8	118618.47	150769.36
149	FIR 5/8	118703.36	150742.52
150	FIR 5/8	118830.52	150902.85
151	FIR 5/8	118843.12	150908.14
152	FIR 5/8 BENTZ	117832.51	150830.45
153	FIR 5/8 AA	118379.56	150874.84
154	FIP 1 1/2"	118379.45	150882.90
183	FIR 1/2	118379.88	150862.70
184	FIR 5/8 IE	118576.24	150906.34
185	FIR 5/8	118631.92	150828.15
186	FIR 5/8	118628.06	150834.83
187	FIR 5/8 YPC	118793.42	150777.17

POINT #	DESCRIPTION	NORTHING	EASTING
188	FIR 5/8 YPC	118990.94	150780.84
189	FIR 5/8 IE	118919.92	150873.79
190	FIP 1"	118802.46	151191.24
191	FIR 5/8 IE	118882.80	151153.60
192	FIR 5/8 IE	118942.98	151150.11
193	FIR 5/8 IE	118973.22	151159.82
194	FIR 5/8 IE	118990.21	151133.63
195	FIR 5/8 IE	119002.60	151140.11
197	FIR 5/8 YPC BENT	119286.08	151135.30
198	FIR 5/8 IE	118680.78	151273.70
199	FIP 1"	118705.75	151291.76
205	FAC DC RW	118753.49	151088.14
206	FAC DC RW	118707.06	151127.61
207	FIR 5/8 IE	118573.59	151082.32
208	FIR 5/8	119239.61	151172.86
209	FIR 3/4	117739.89	150331.34

POINT #	DESCRIPTION	NORTHING	EASTING
211	FIR 5/8 BENTZ	117745.15	150721.68
212	FIR 5/8	117690.68	151039.26
213	FIR 5/8 IE	117687.98	151232.27
221	FIR 3/4	117686.72	150688.29
222	FBC 1956	117700.94	150331.38
304	FBC CARNES NO 2 1985	119051.13	151046.80
305	FBC CARNES NO 1 1985	118938.99	151021.55
306	FIP 1 1/2	118887.96	151173.28
316	FIR 3/4	118064.18	150810.34
318	FIP 3/4	118064.28	150615.53
319	FD BOLT	118064.20	150520.48
320	FIP 1"	118124.10	150425.66

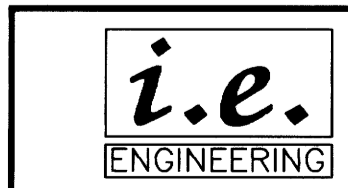


809 SE Pine Street
 Roseburg, Oregon 97470
 PHONE (541) 673-0166
 FAX (541) 440-9392
 email@ieengineering.com

SURVEYED FOR:
 DAVID EVANS & ASSOCIATES
 530 CENTER ST. NE, SUITE 605
 SALEM, OR 97301

PAGE: 3 OF 3
 JOB NO: 2467-13
 DATE: 2/19/2020

PRECONSTRUCTION MONUMENT LOCATE
CARNES ROAD - COUNTY ROAD NO. 16
 LYING IN THE NW QUARTER OF SECTION 11 AND IN THE SW QUARTER OF SECTION 2,
 TOWNSHIP 28 SOUTH, RANGE 6 WEST, WILLAMETTE MERIDIAN, DOUGLAS COUNTY, OREGON

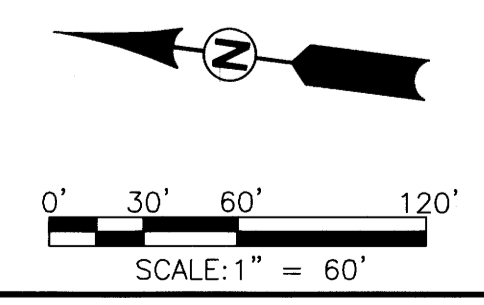

REGISTERED PROFESSIONAL LAND SURVEYOR
 DEREK ALLEN FEIGEL
 OREGON JULY 10, 2018
 77555
 EXPIRES: 12/31/21

SEE PAGE 2

14261389