T.29S. R.3W. W.M.

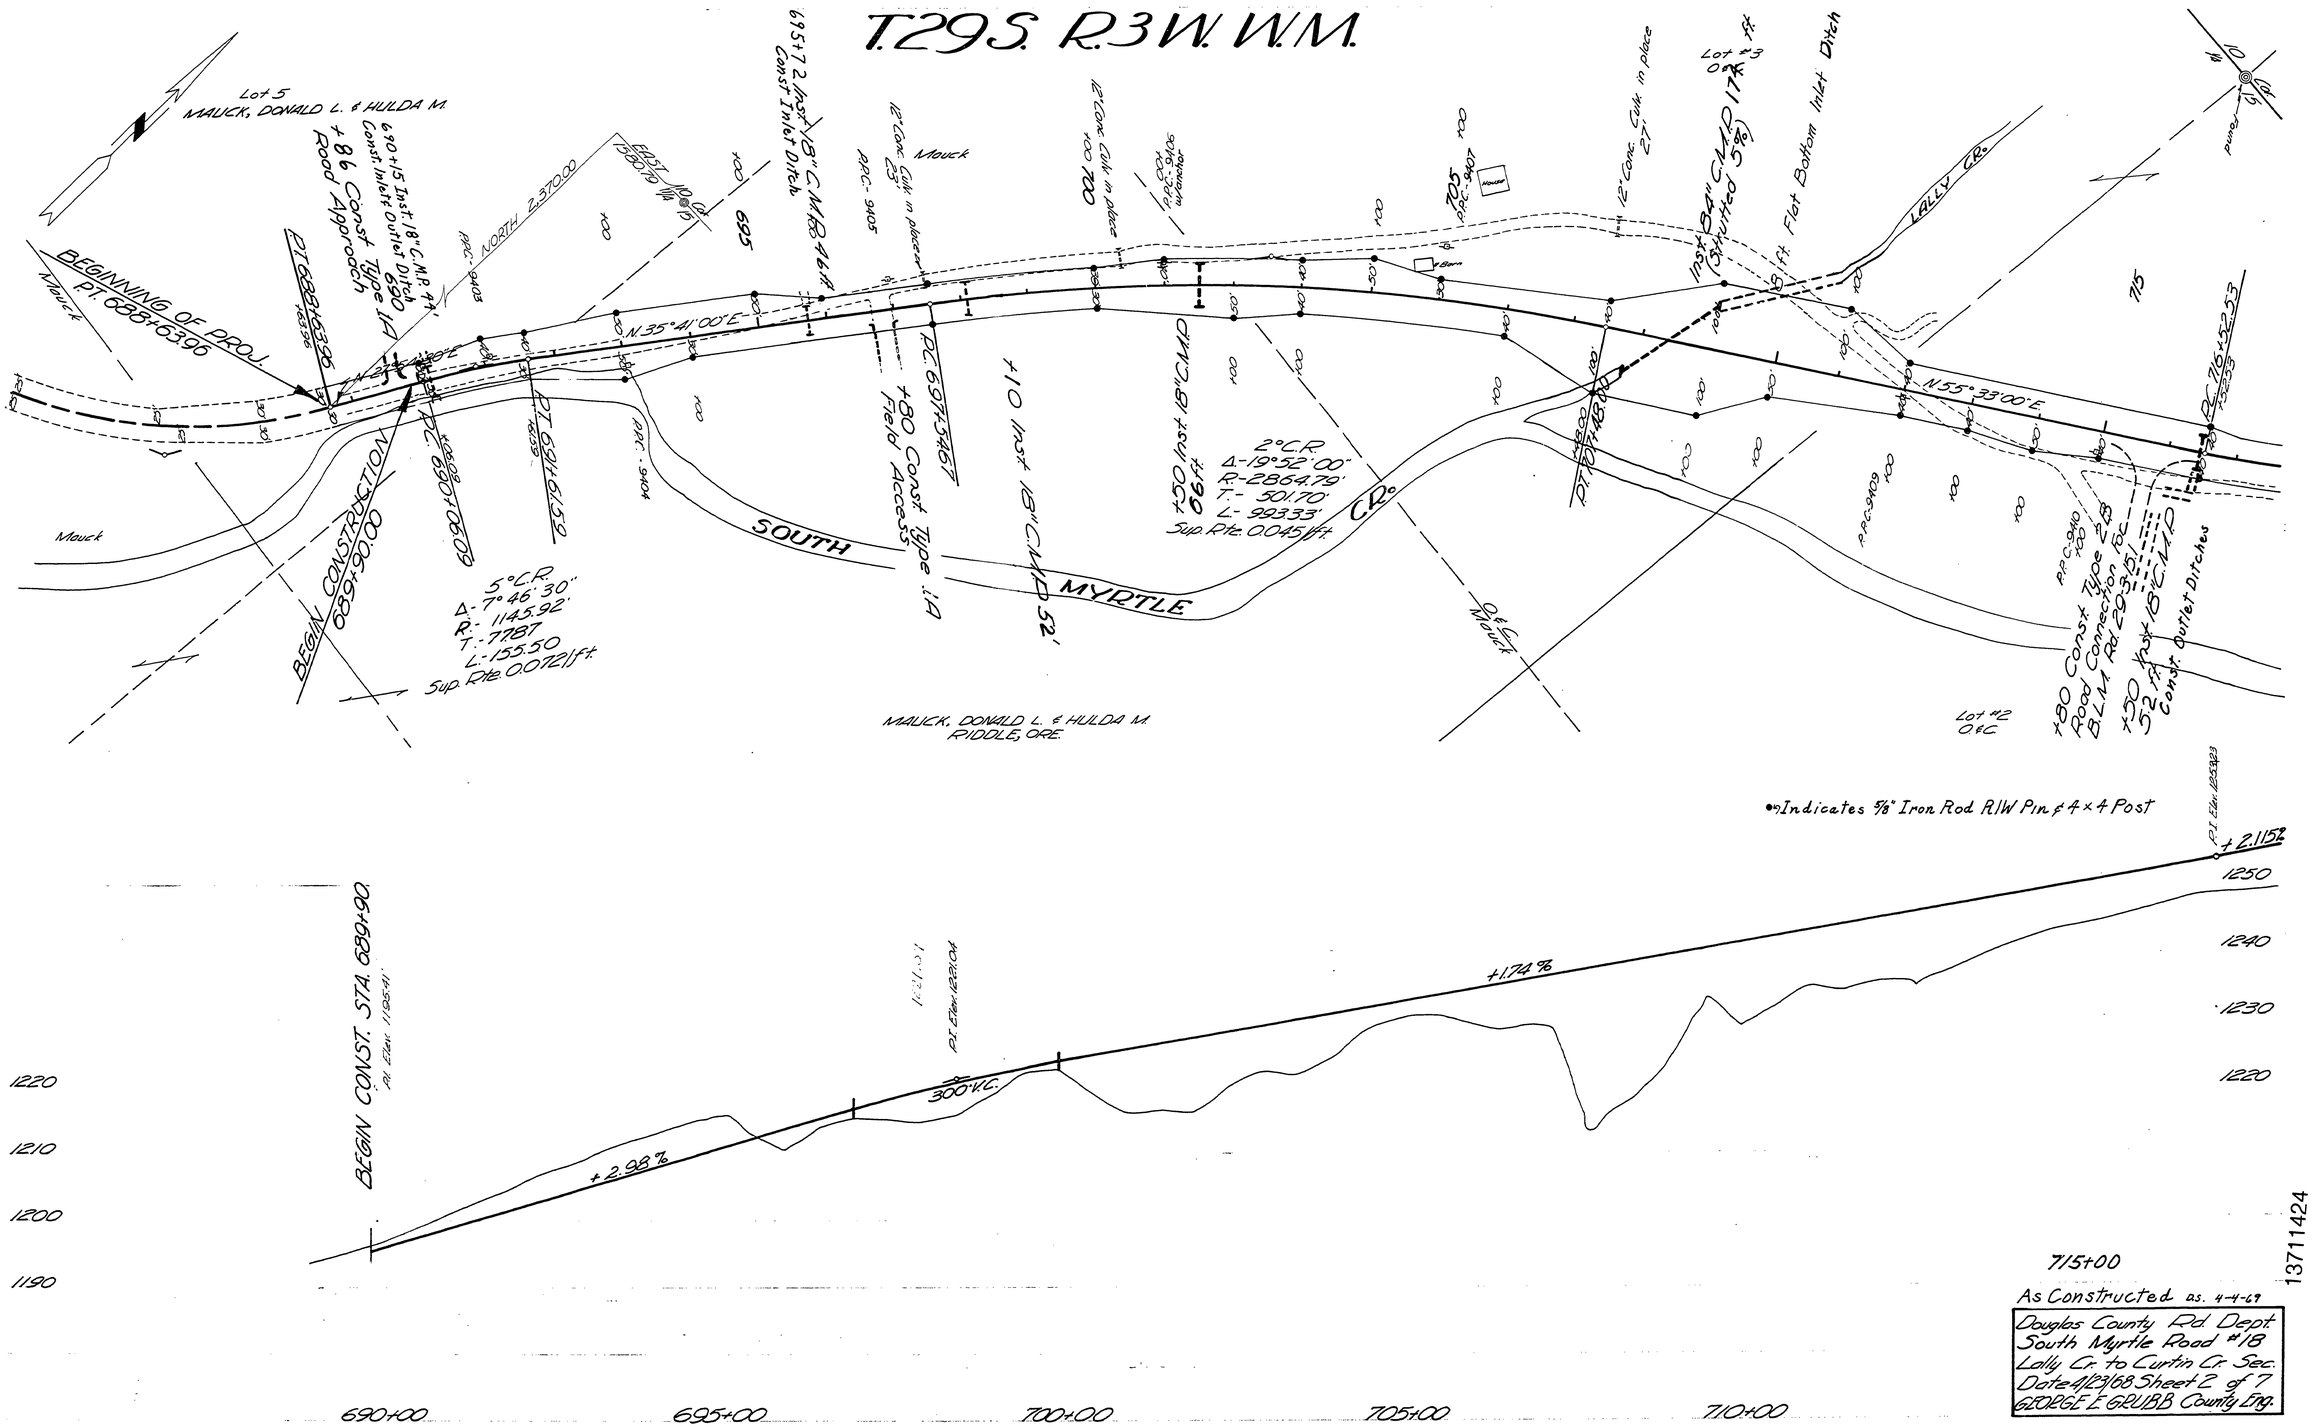

715+00

As Constructed as. 4-4-69

Douglas County Rd. Dept.
South Myrtle Road #18
Lally Cr. to Curtin Cr. Sec.
Date 4/23/68 Sheet 2 of 7
GEORGE E. GRUBB County Eng.

13711424

M.P. 13.71 - 14.24

Rd #18 April, 1968 Sht. 2 of 7

24