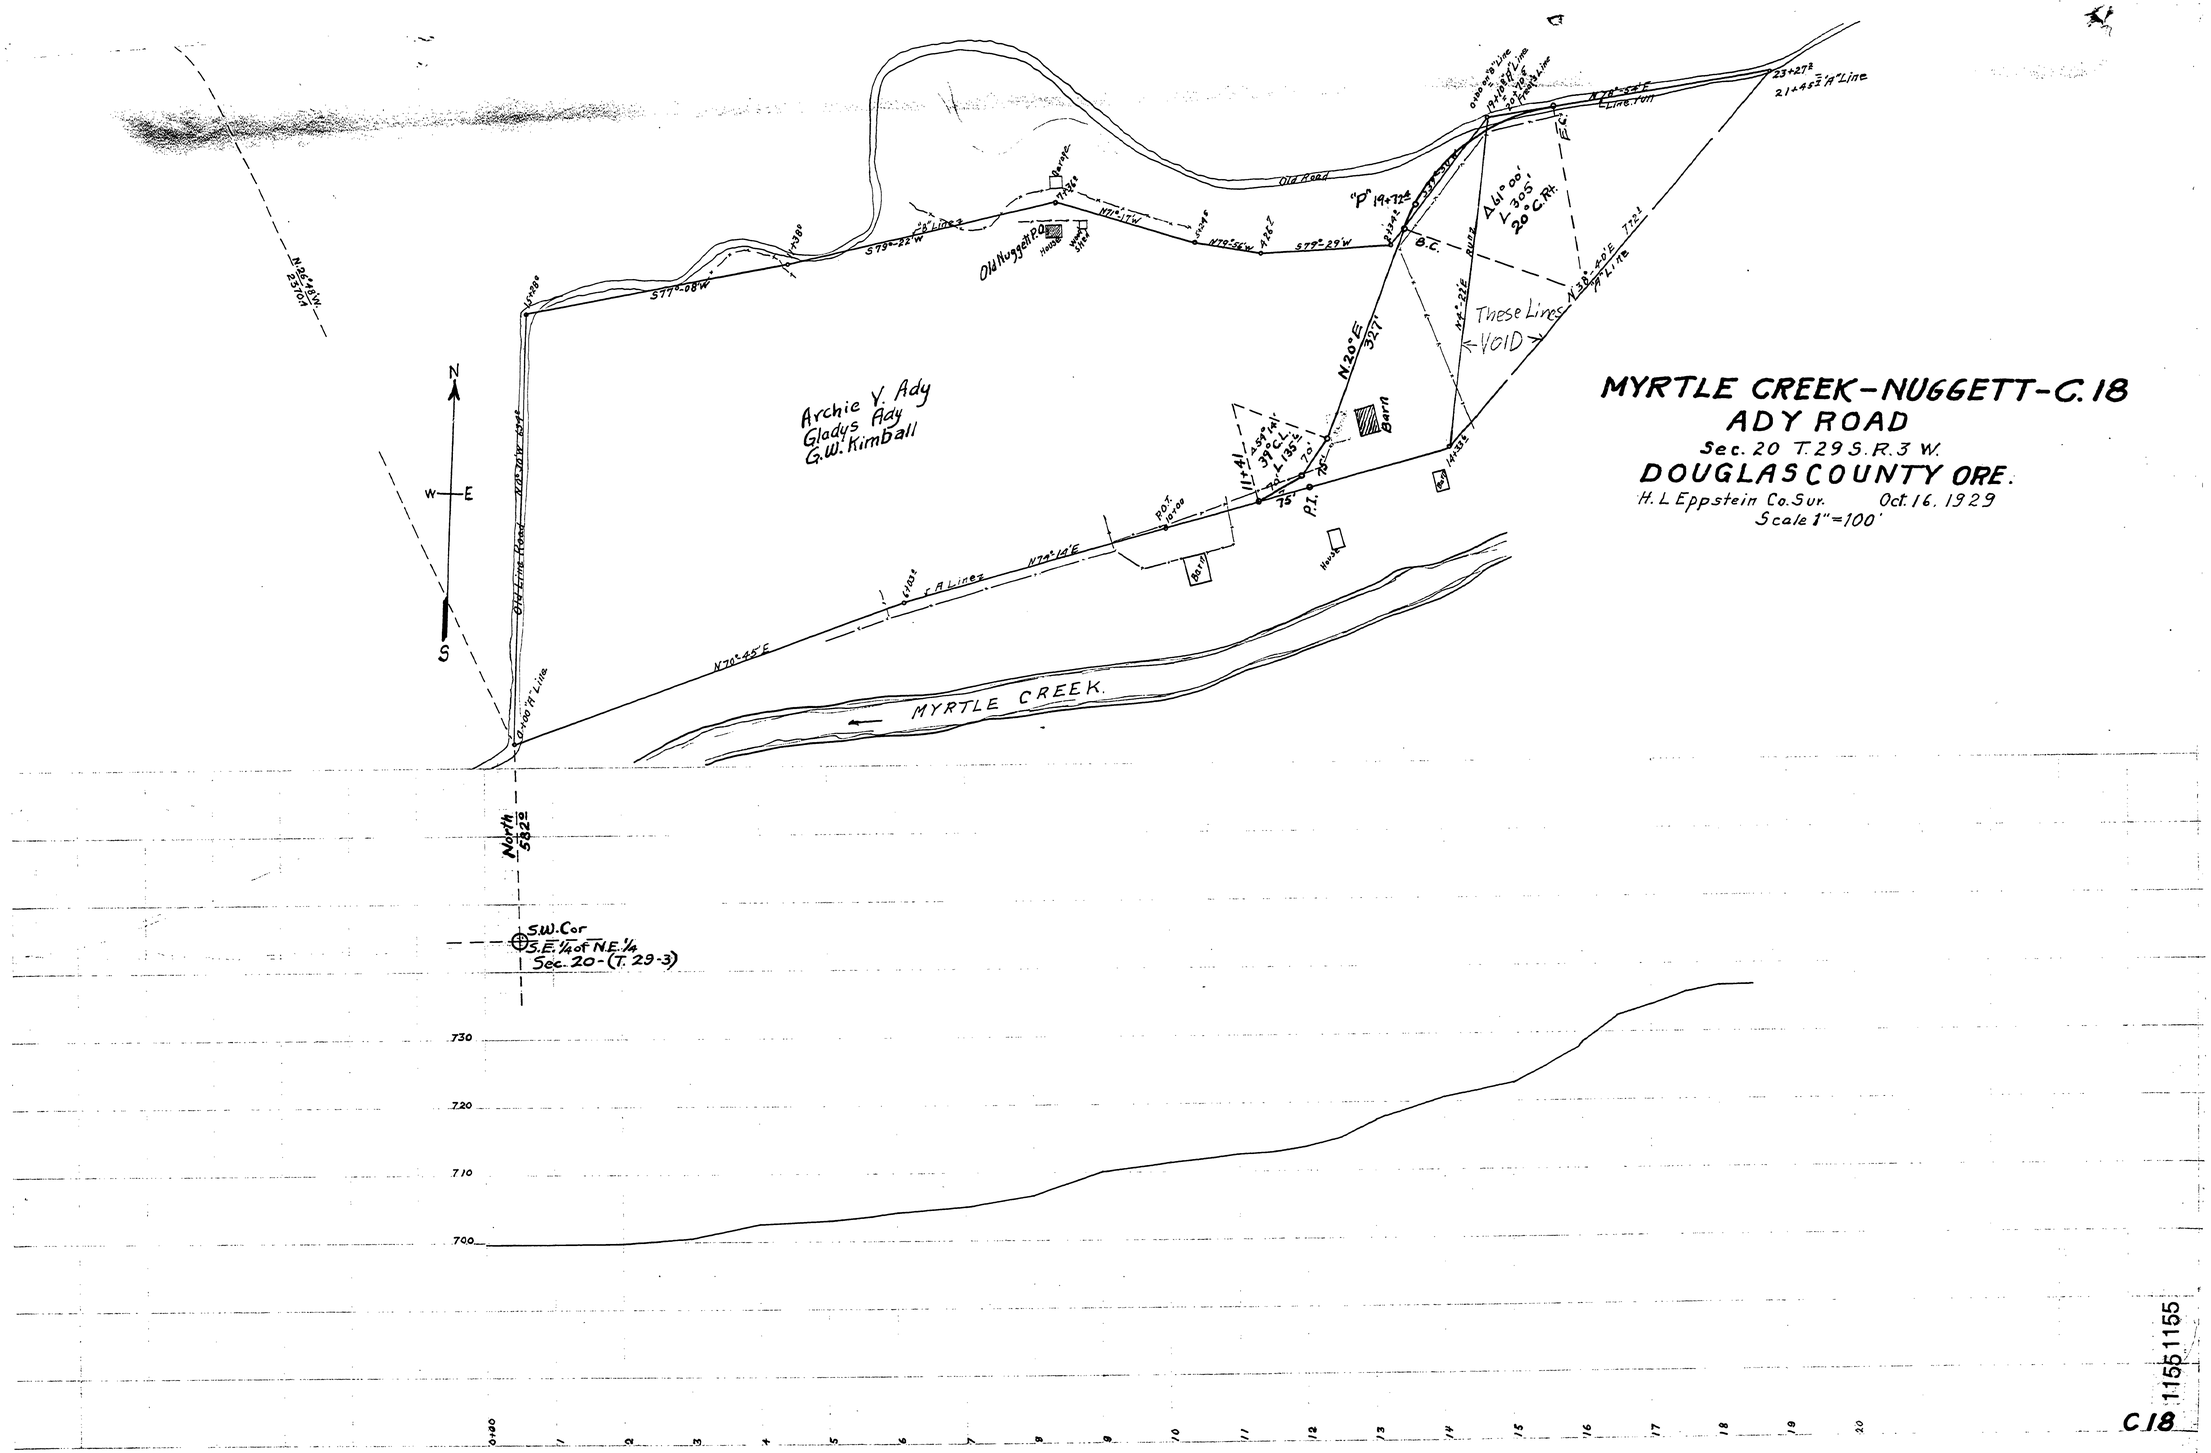
MYRTLE CREEK-NUGGETT-C.18
ADY ROAD
Sec. 20 T. 29 S. R. 3 W.
DOUGLAS COUNTY ORE.
H. L. Eppstein Co. Sur. Oct. 16, 1929
Scale 1" = 100'
Archie V. Ady
Gladys Ady
G.W. Kimball
MYRTLE CREEK.
Old Nuggett P.O.
House
Barn
Old Road
Old Line Road
These Lines VOID
Δ 41° 00'
L 305'
20° C.R.
N 20° E
327'
39° C.L.
L 135'
P.I.
B.C.
"P" 19+72
S.W. Cor
S.E. 1/4 of N.E. 1/4
Sec. 20 - (T. 29-3)
North
5822
730
720
710
700
0+00
1
2
3
4
5
6
7
8
9
10
11
12
13
14
15
16
17
18
19
20
C18
1155
