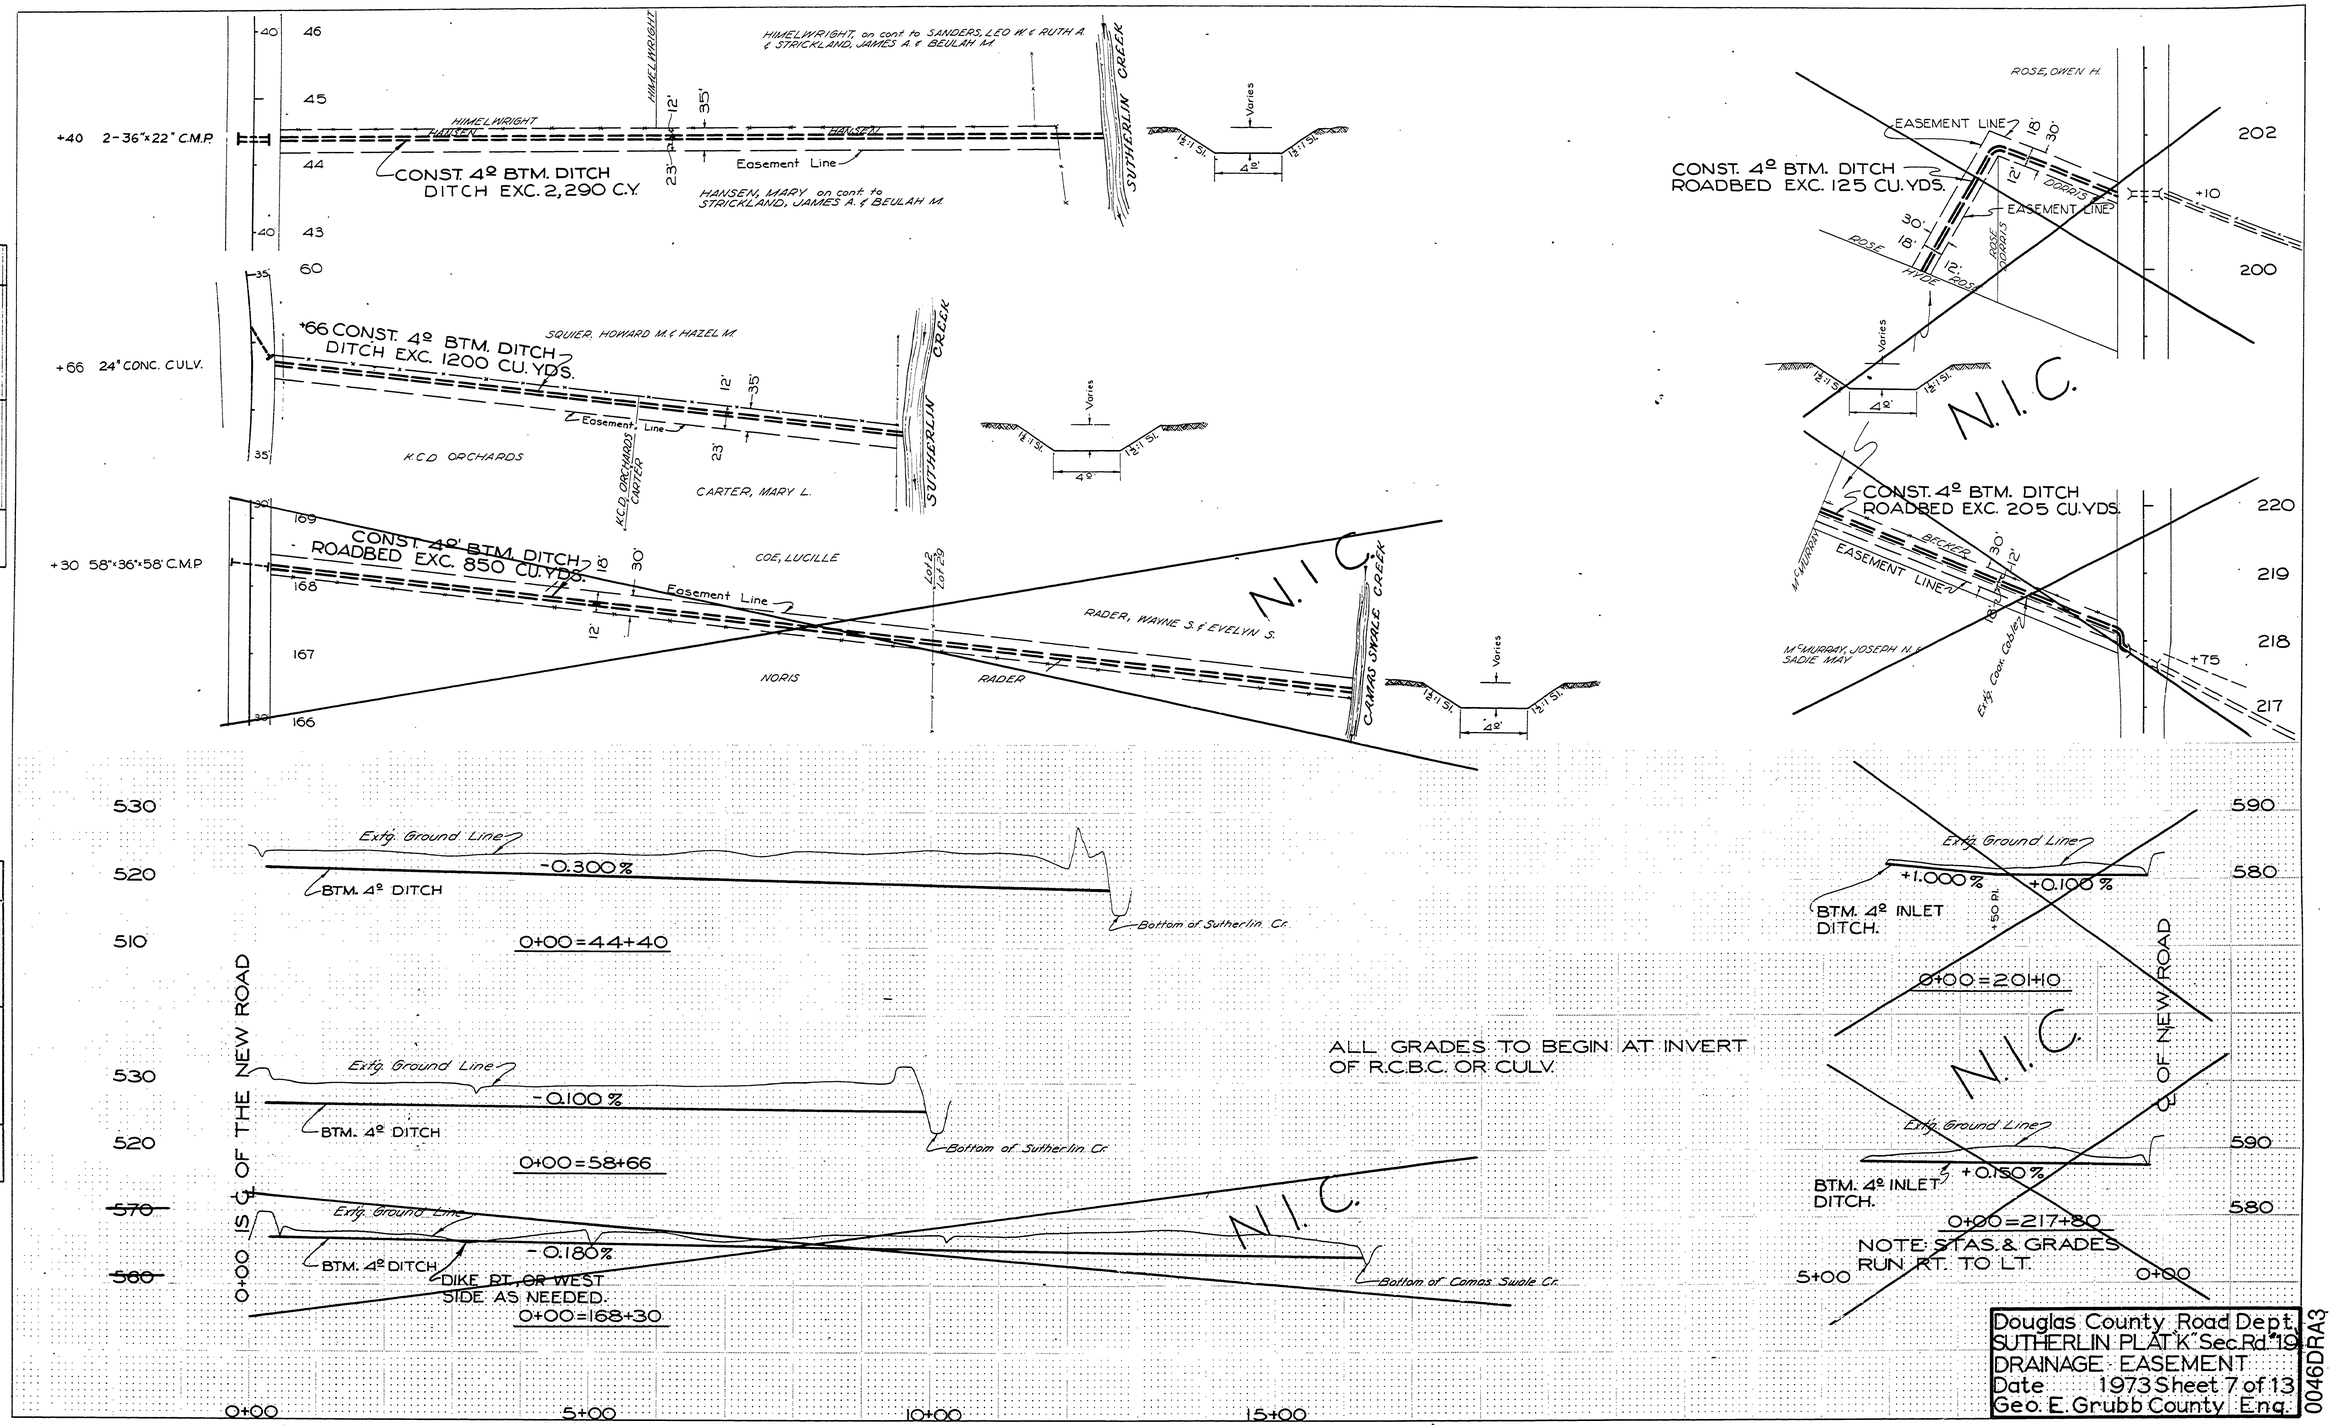

Rd. #19 1973 sht. 7 of 13 (33)