

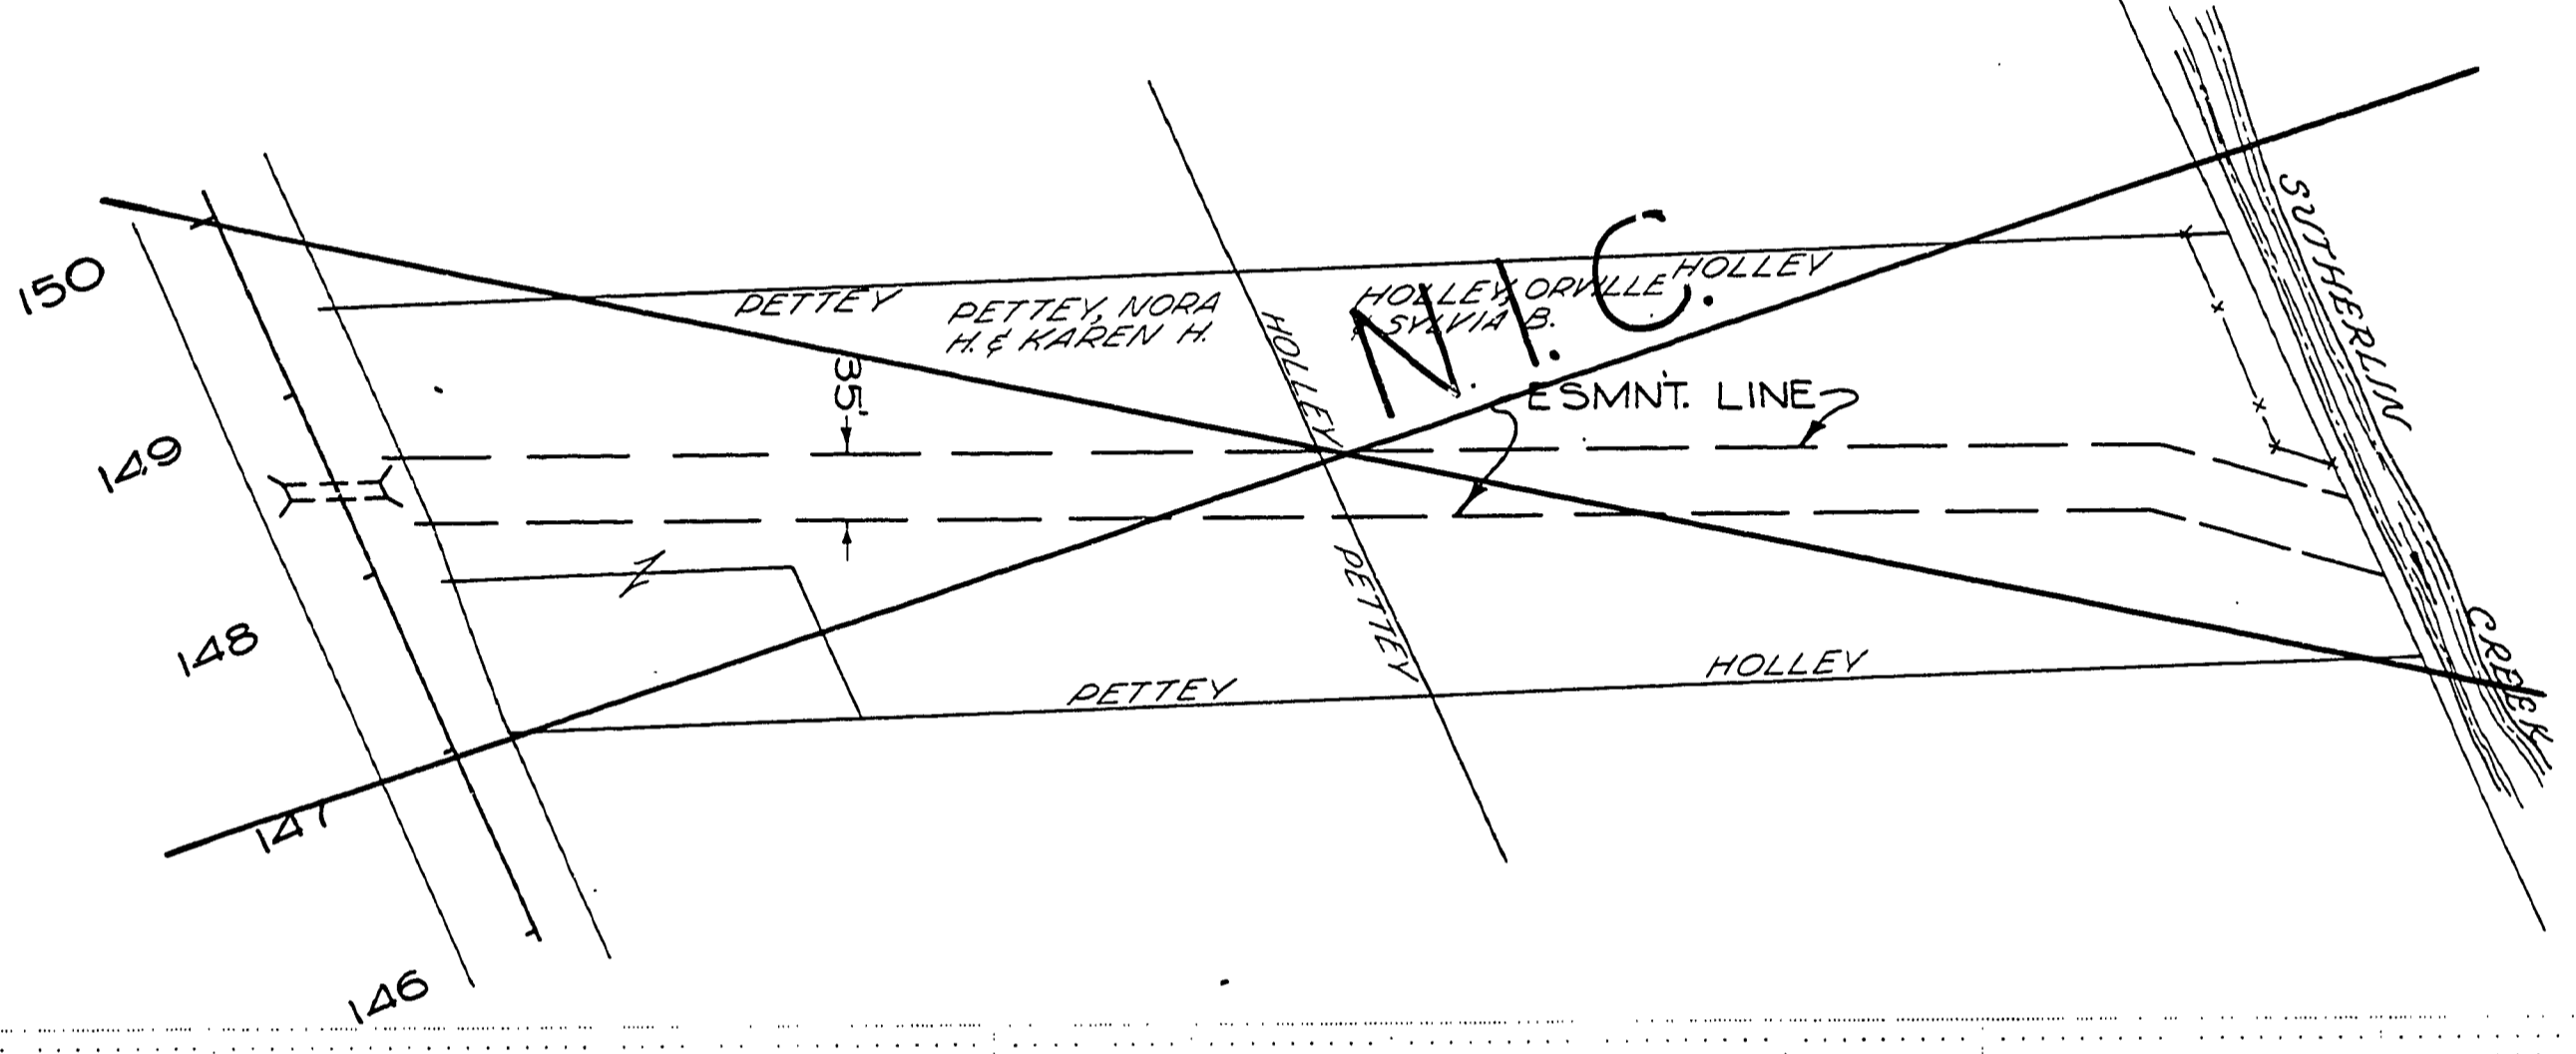
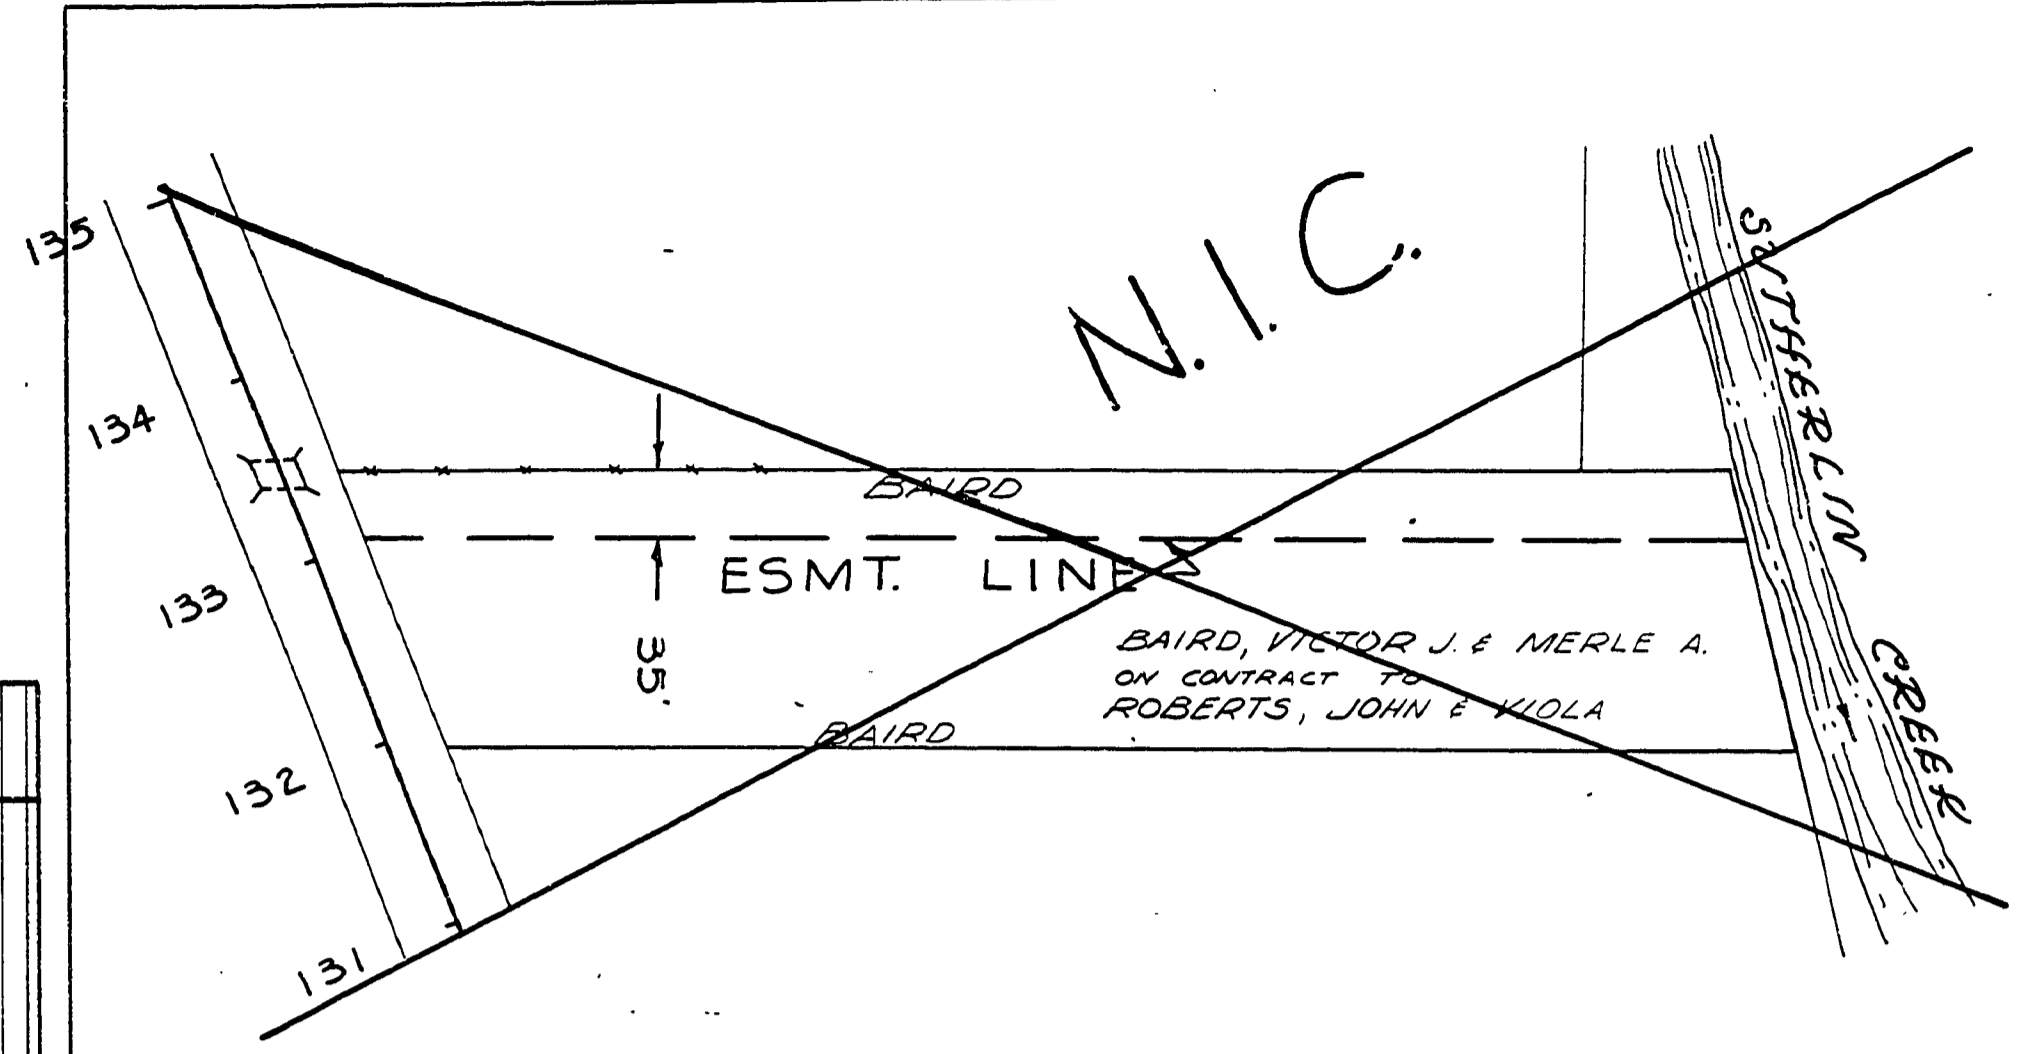
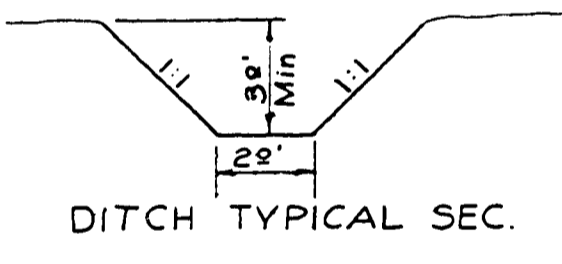
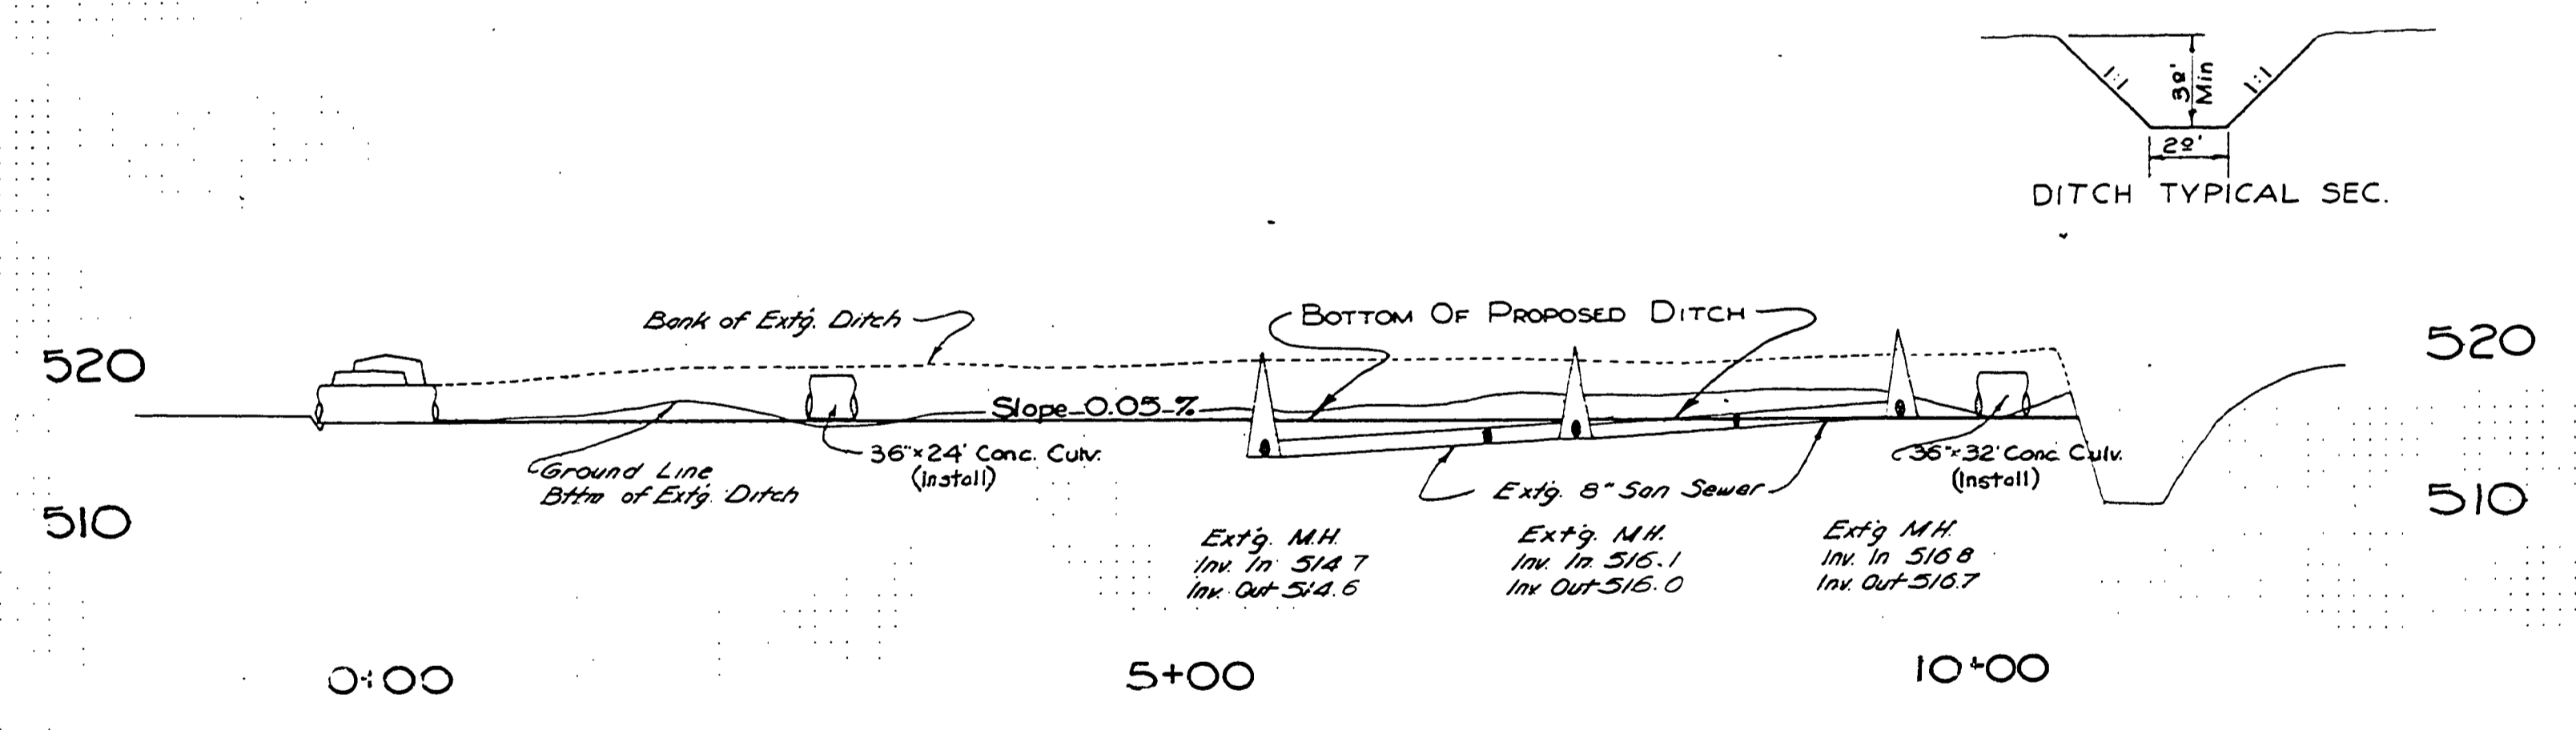


DATE	
BY	
PLAN	
NO. OF WAY CHECKED	
NO. OF WAY CHECKED	
NO. OF WAY CHECKED	
NO. OF WAY CHECKED	

DATE	
BY	
PROFILE	
NO. OF WAY CHECKED	
NO. OF WAY CHECKED	
NO. OF WAY CHECKED	
NO. OF WAY CHECKED	

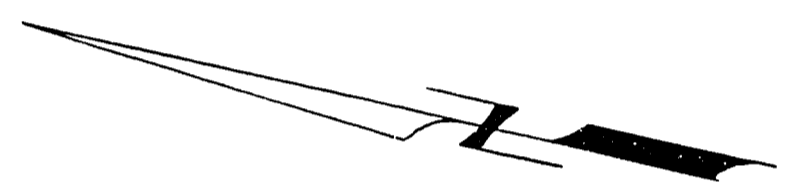

5th 28'02.58" Central Ave =  
0+00.00 Waite Street

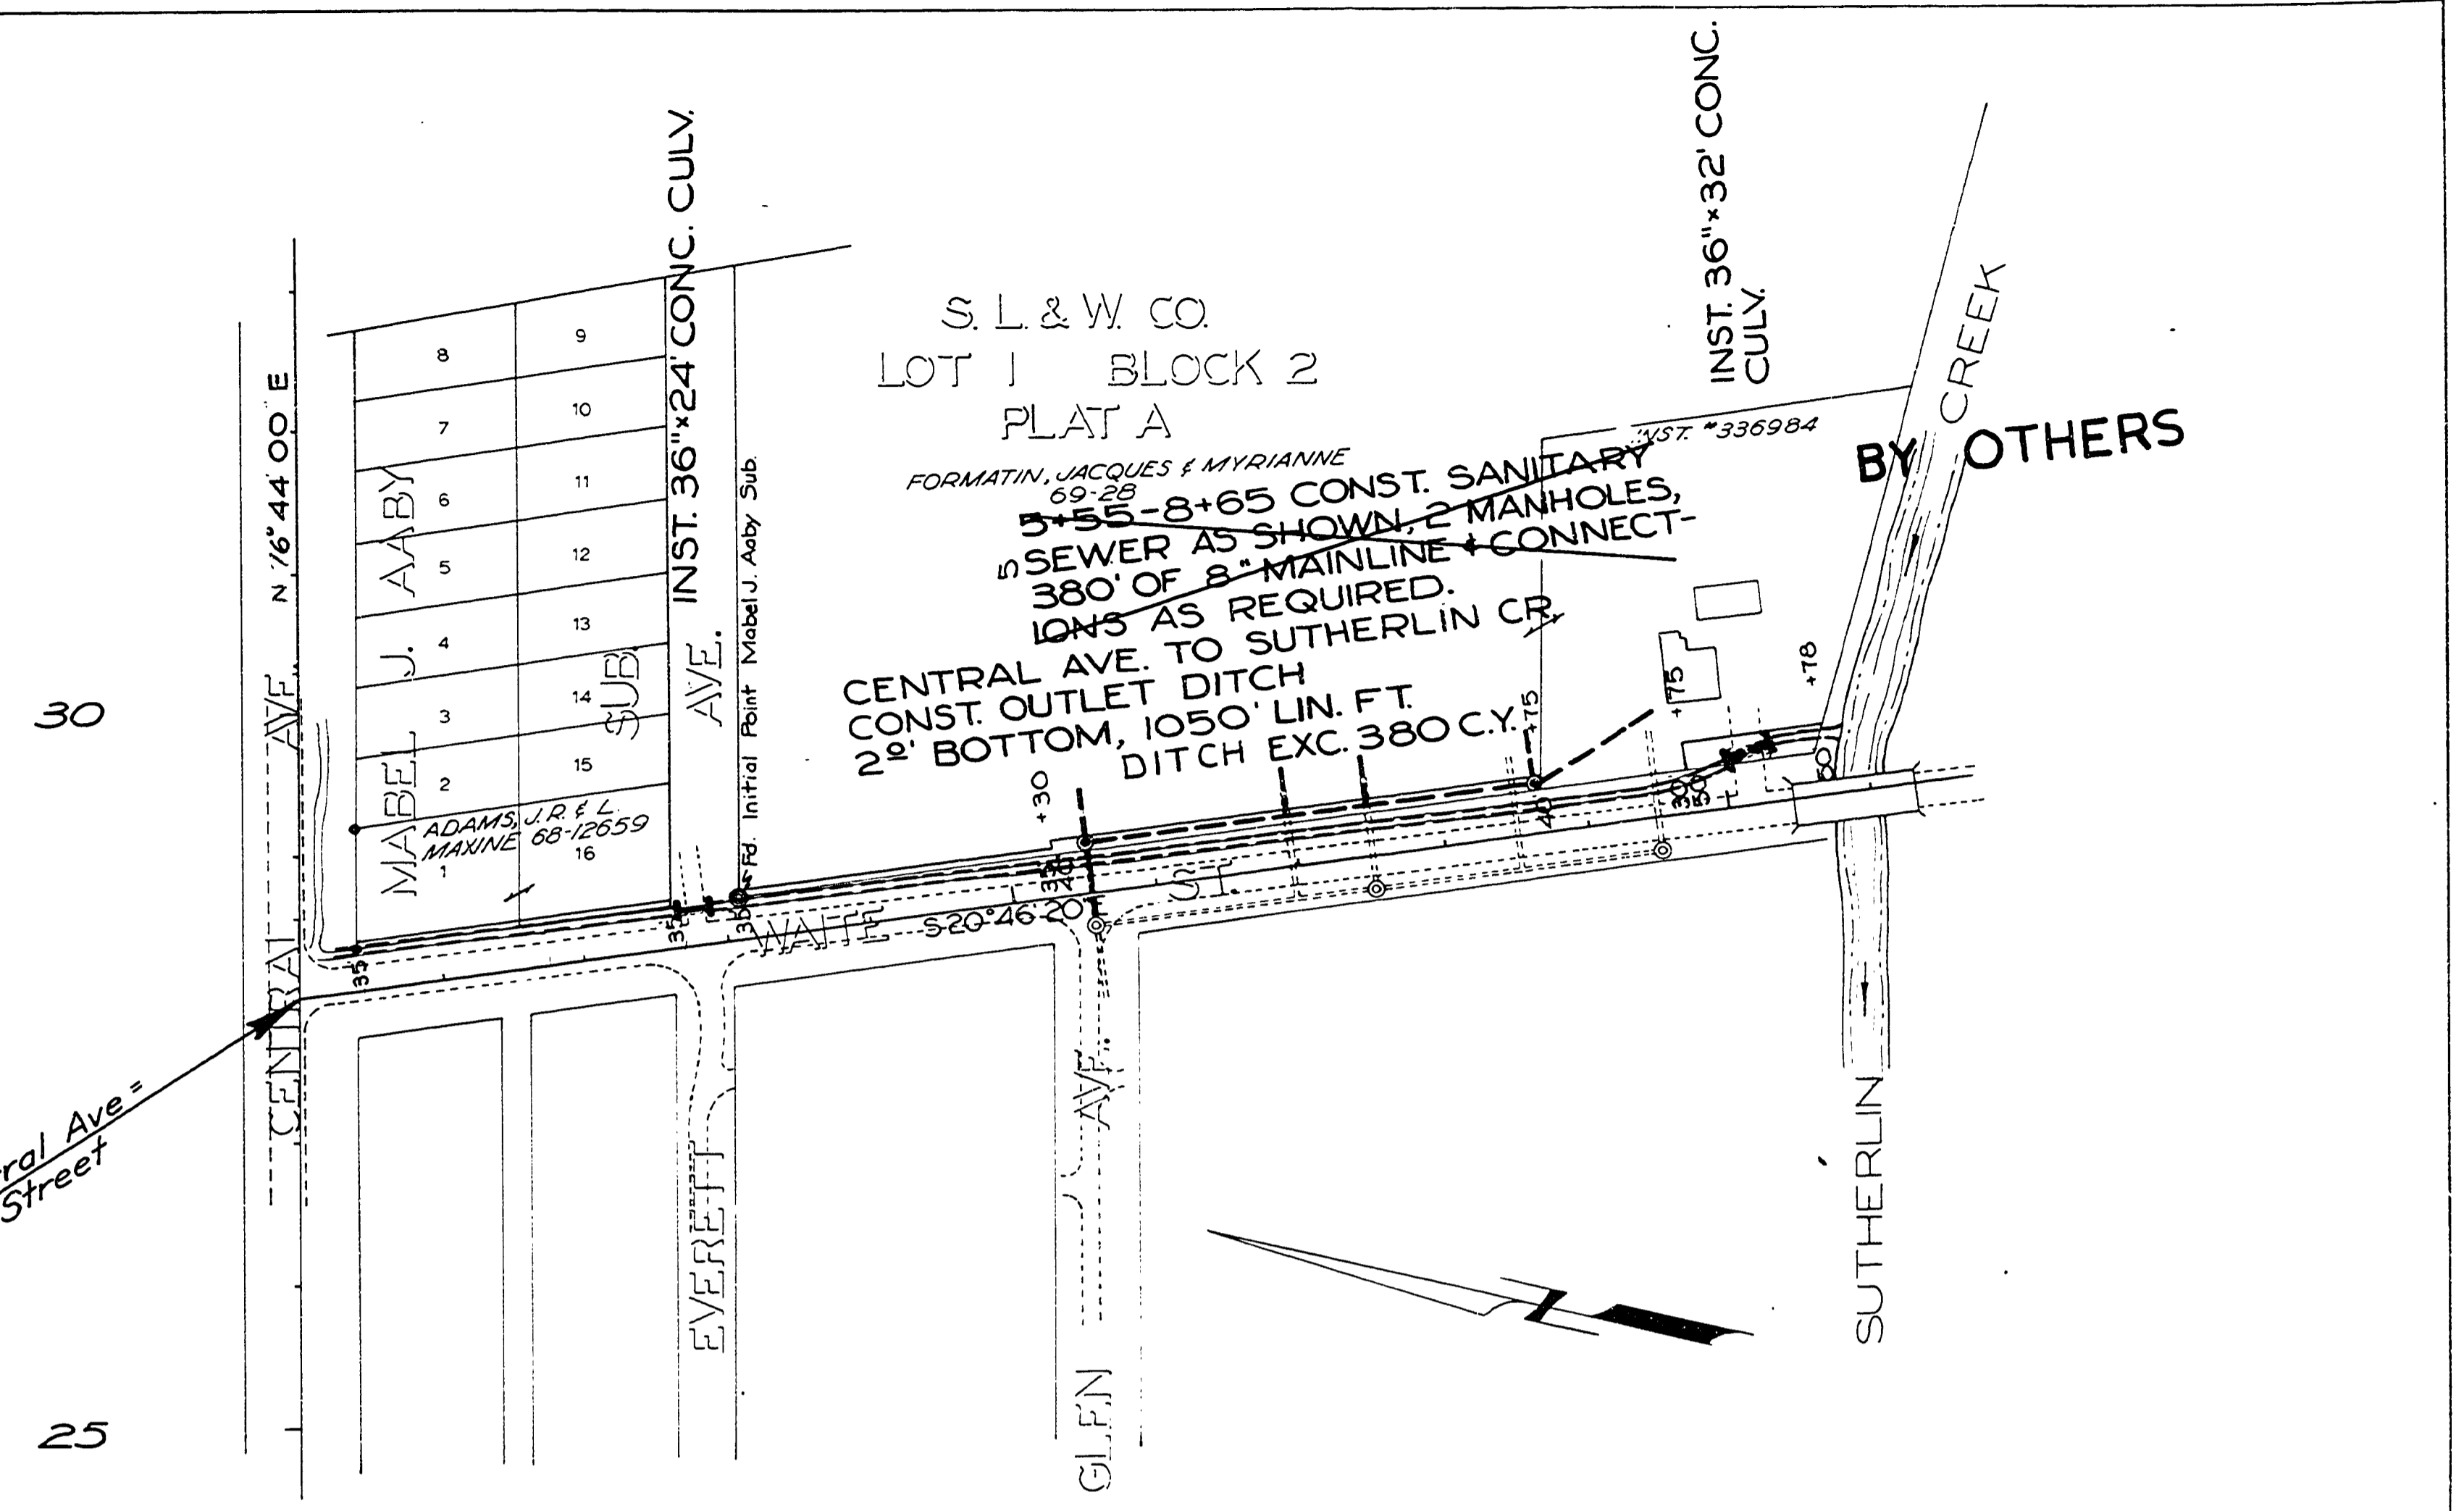

Douglas County Road Dept.  
SUTHERLIN PLAT K Sec. Rd. #19  
DRAINAGE EASEMENT  
Date 1973 Sheet 5 of 13  
Geo. E. Grubb County Eng.

0046DRA