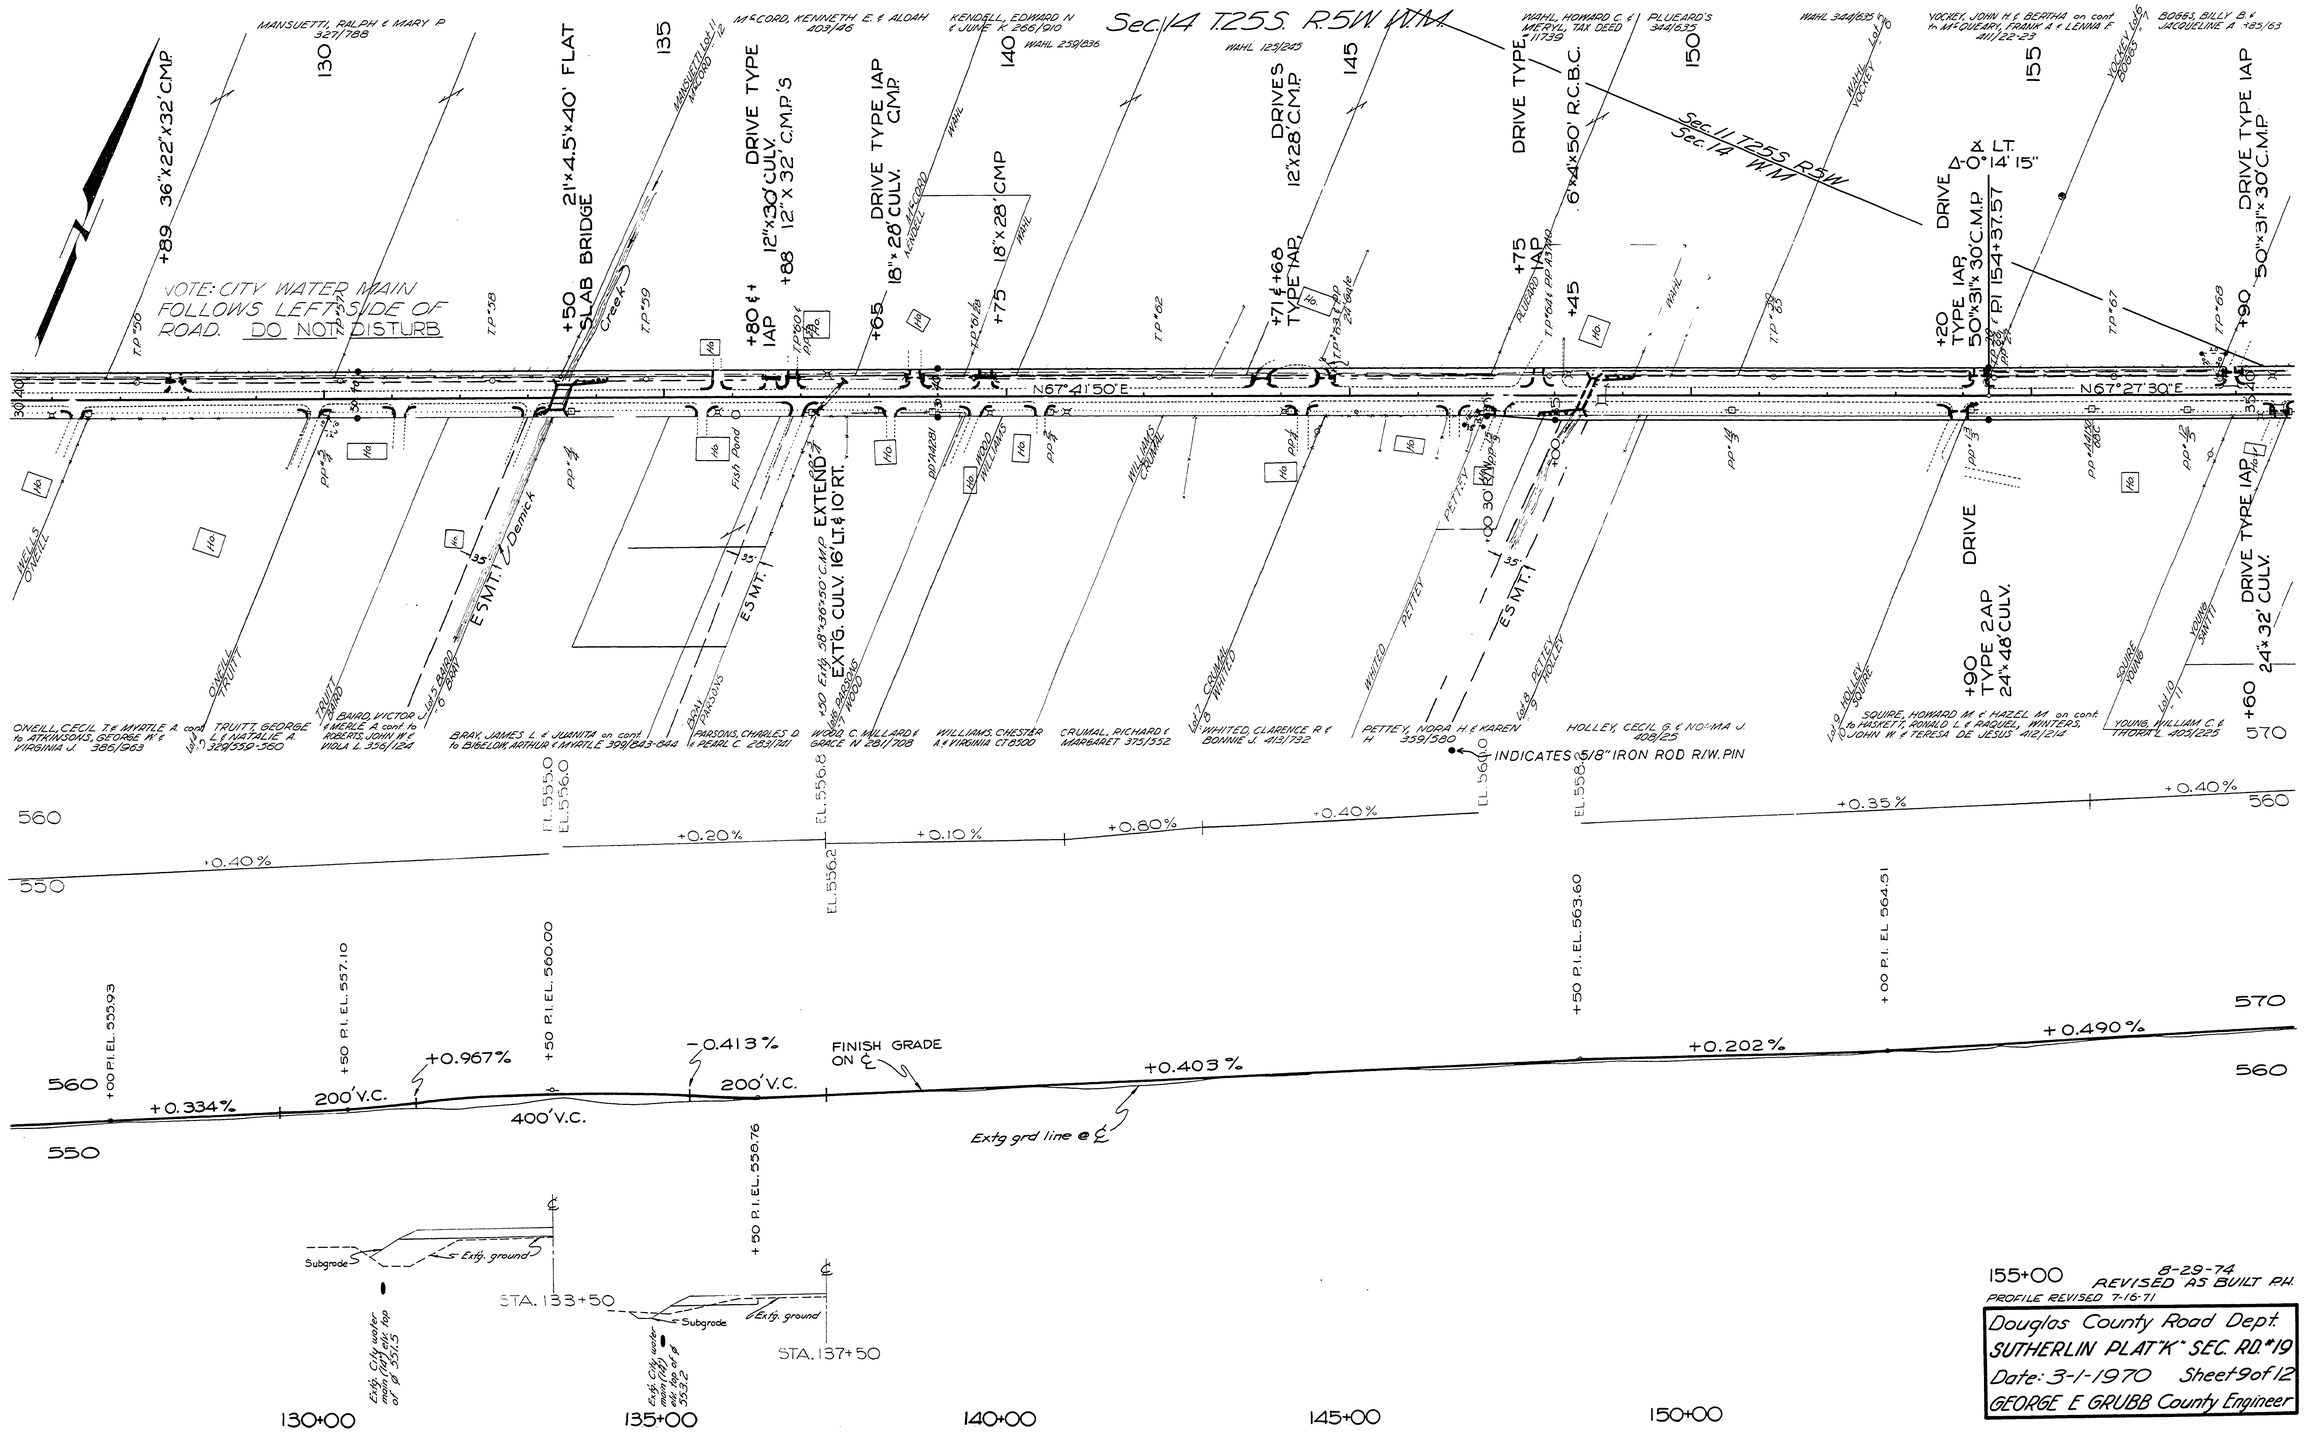

155+00 8-29-74 REVISED AS BUILT P.H.
PROFILE REVISED 7-16-71

Douglas County Road Dept.
SUTHERLIN PLAT "K" SEC. RD. #19
Date: 3-1-1970 Sheet 9 of 12
GEORGE E GRUBB County Engineer

02350292

M.P. 2.35-2.92

Rd. # 19 MAR. 1970 Sht. 9 of 12 (49)