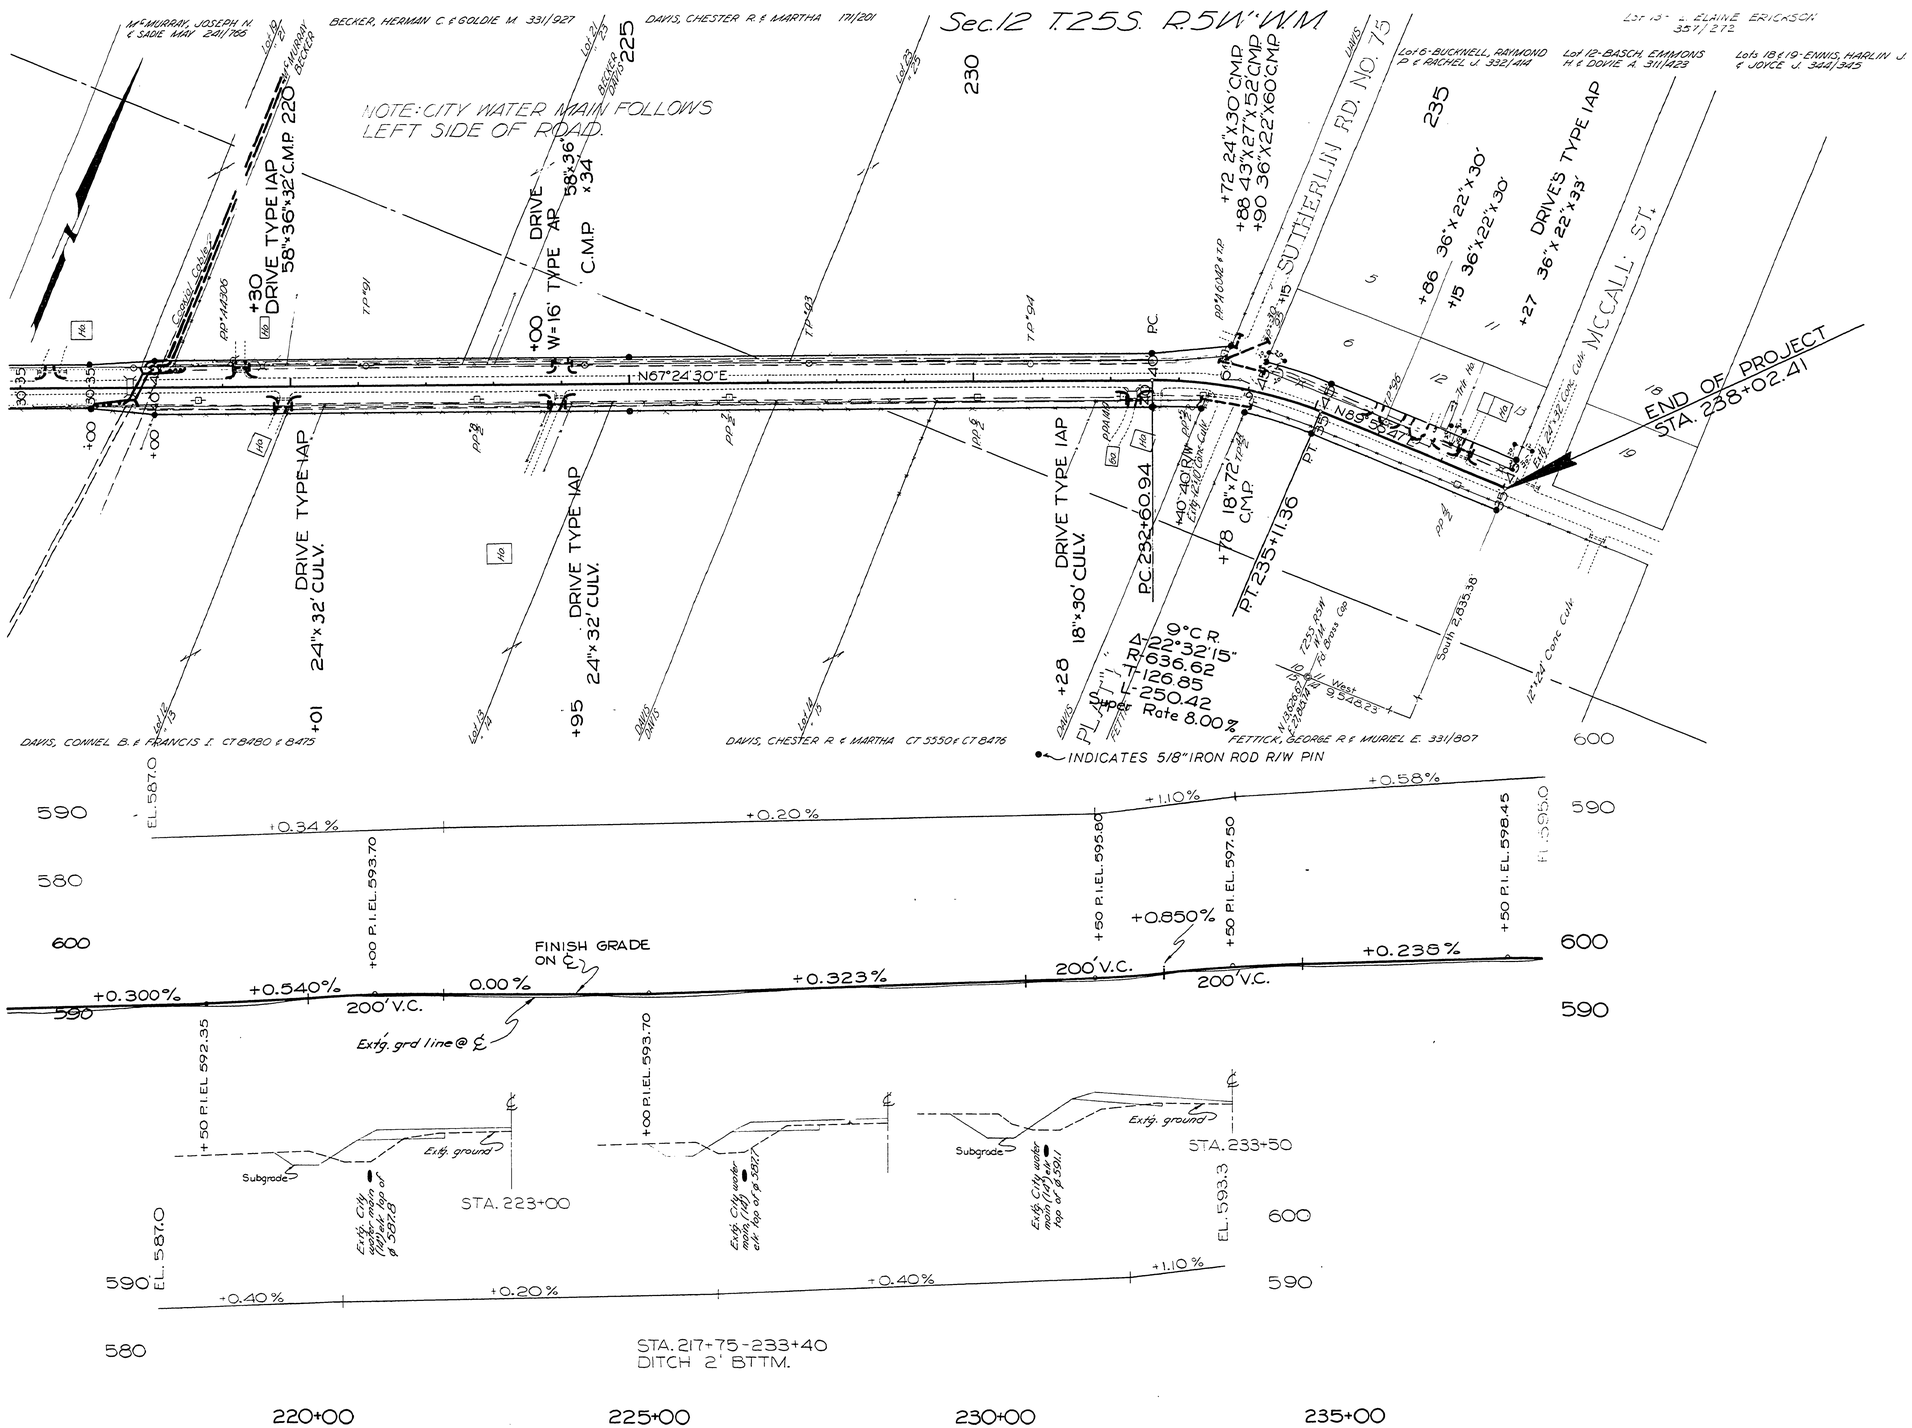

8-29-74
REVISED AS BUILT PH.
PROFILE REVISED 7-16-71

Douglas County Road Dept.
SUTHERLIN PLAT "K" SEC. RD. #19
Date: 3-1-1970 Sheet 12 of 12
GEORGE E. GRUBB County Engineer

04060444

M.P. 4.06 - 4.44

Rd # 19 MAR. 1970 Sht 12 of 12 (52)