51-244

YOKUM BRIDGE SECTION YOKUM ROAD DOUGLAS COUNTY				SHEET No. 3
FED. ROAD Div. No.	STATE	PROJECT NUMBER	FISCAL YEAR	TOTAL SHEETS See Index
8	OREGON	S-302(1)		

FILED
RECEIVED
NOV 7 1967
COUNTY SURVEYOR
DOUGLAS COUNTY, OREG.

REVISED AS CONSTRUCTED
5-5-7 CONTRACT 4537

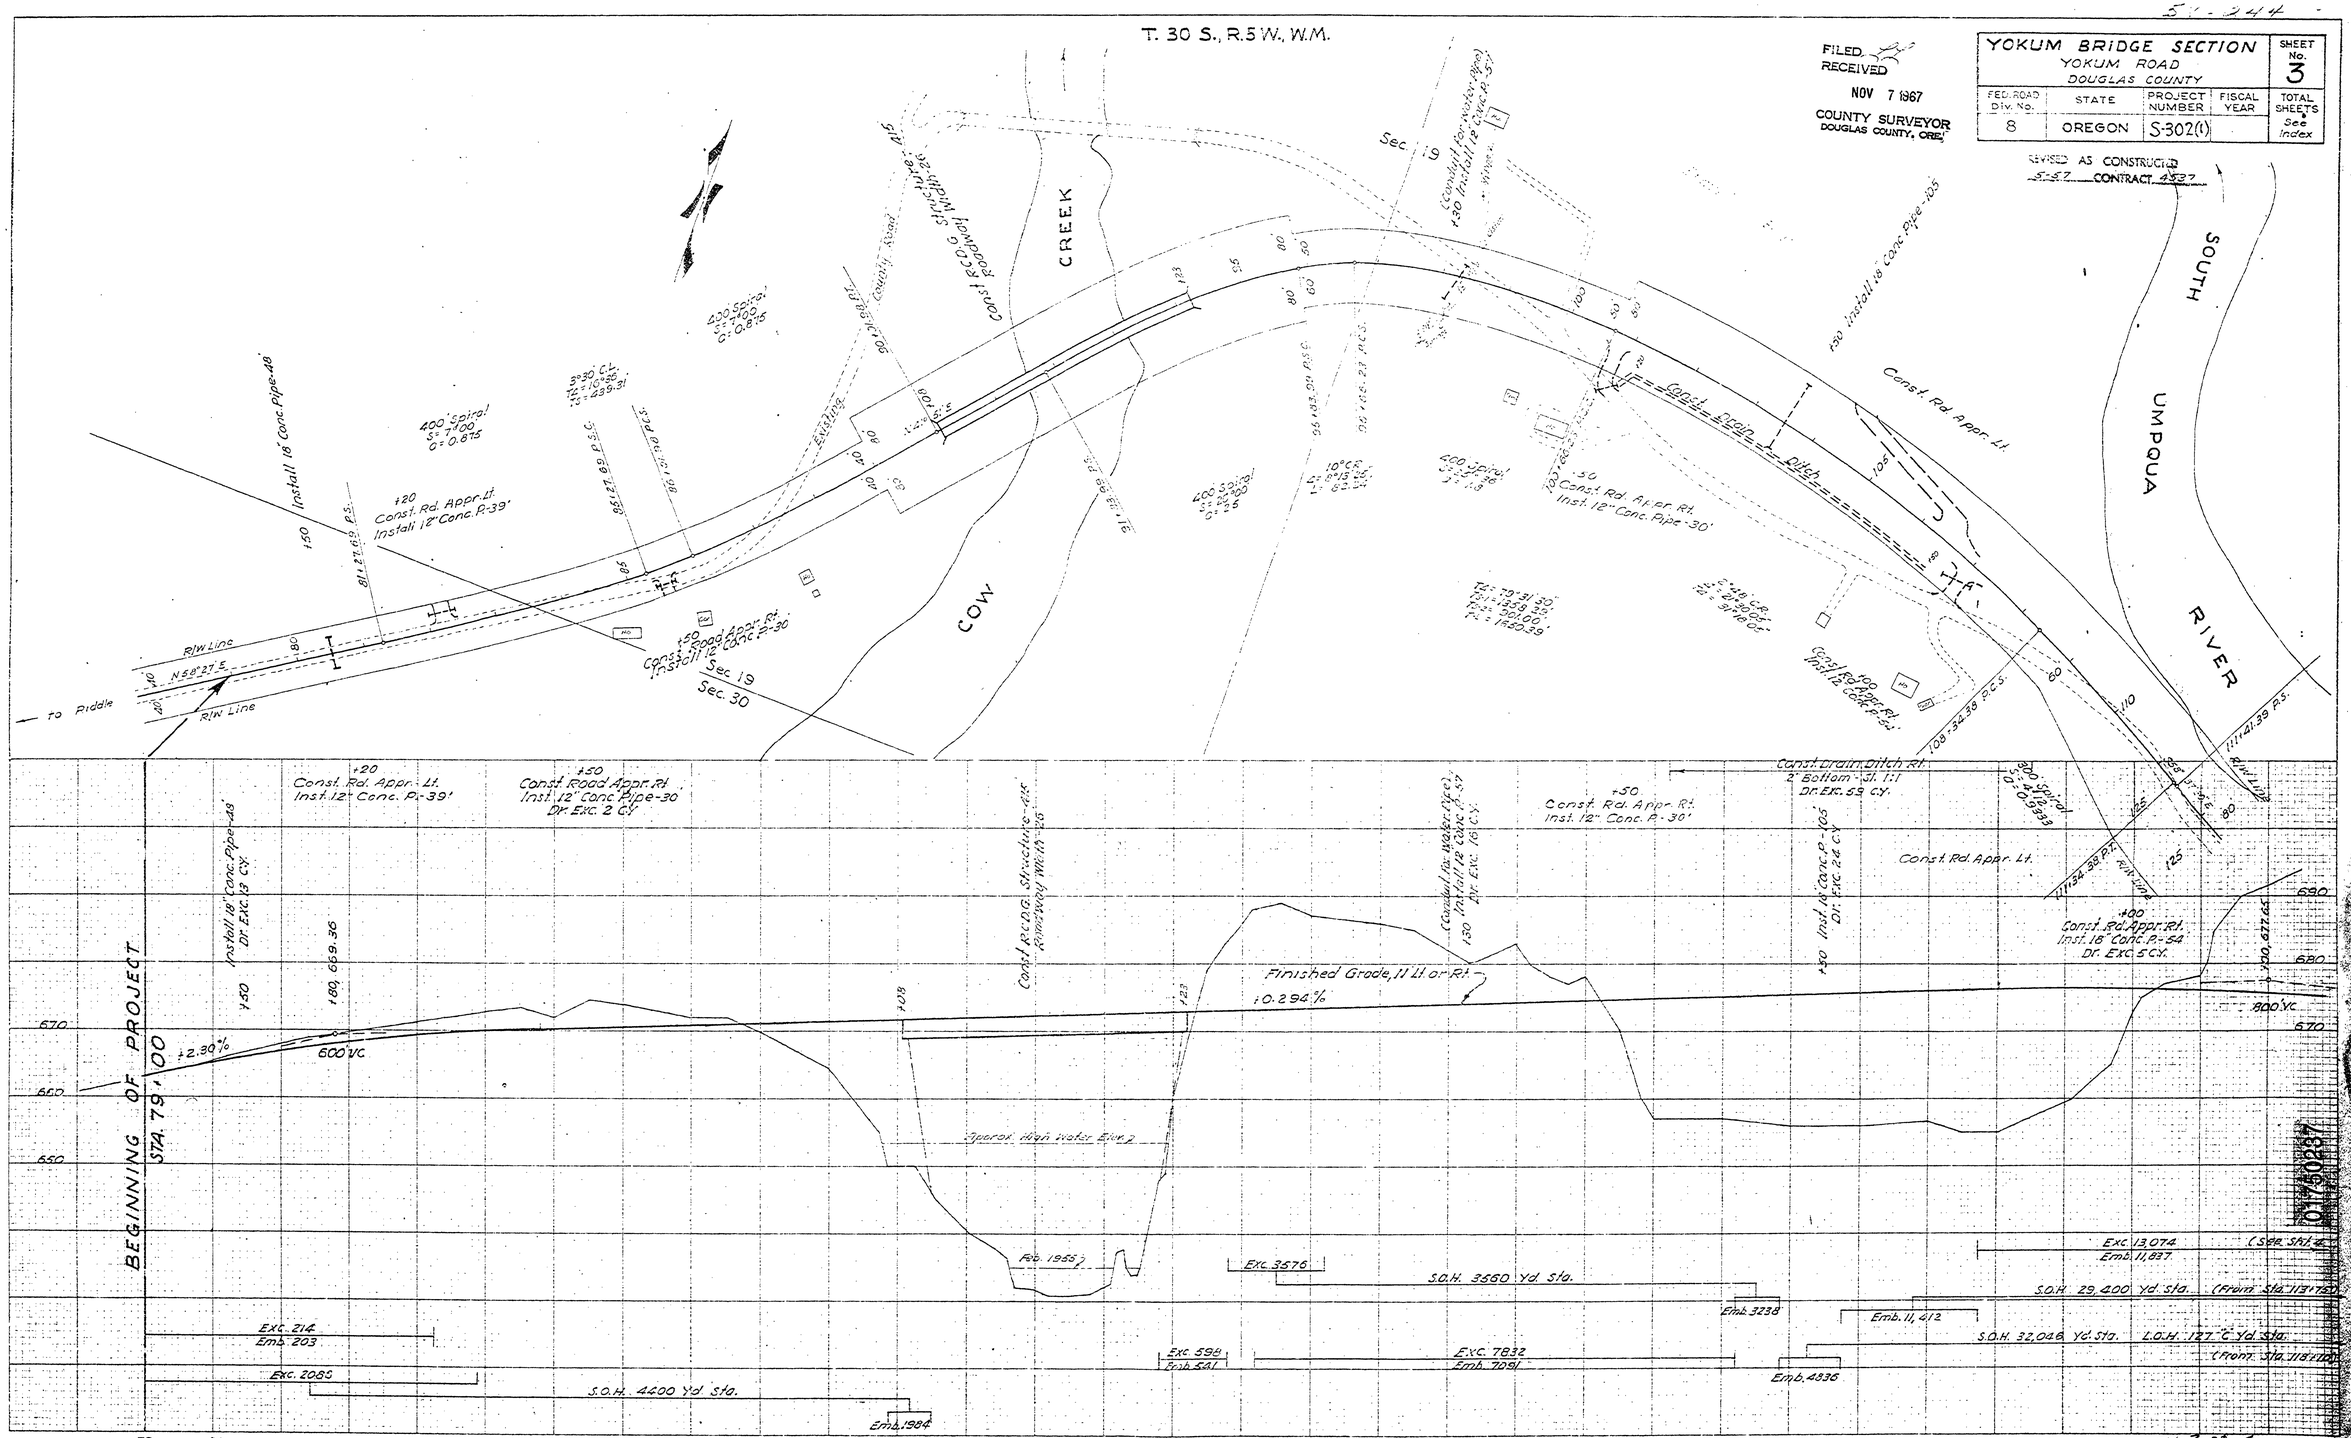

FINAL SURVEY
SURVEYED
FIELD BOOK
NOTE BOOK
NO.
TAB.
PG.
FIELD CHECKED

ORIGINAL SURVEY
SURVEYED
PLOTTED
FIELD BOOK
NOTE BOOK
NO.
FIELD CHECKED

DATE
BY

01750237