F.V. - 244

YOKUM BRIDGE SECTION YOKUM ROAD DOUGLAS COUNTY				SHEET No. 2
FED. ROAD Div. No.	STATE	PROJECT NUMBER	FISCAL YEAR	TOTAL SHEETS
8	OREGON	S-302(1)		See Index

REVISED AS CONSTRUCTED
5-57 CONTRACT 4537

SUMMARY

Length of F.A. Project - 0.786 Mi

ITEM	UNIT	NET QUANTITY	ALLOWANCE	TOTAL QUANTITY	
Clearing and Grubbing	All	All	--	All	Roadwork
Drainage Excavation, Unclassified	Cu. Yd.	127	13	140	Roadwork
General " "	" "	45,864	4,636	50,500	Roadwork
Short Overhaul	Yd. Sta.	69,406	6,994	76,400	Roadwork
Long "	C-Yd. Sta.	127	13	140	Roadwork
Finishing Roadbed and Slopes	Mile	0.71	--	0.71	Roadwork
12-inch Concrete Pipe	Lin. Ft.	30	-	30	Roadwork
18 " " "	" "	333	27	360	Roadwork
Selected Roadbed Topping	Cu. Yd.	5,378	522	5,900	Roadwork
Hauling Roadbed Topping	Yd. Mi.	11,104	1,096	12,200	Roadwork
Crusher-run Material in Base	Cu. Yd.	3,237	313	3,600	Roadwork
3/4"-0 Material in Base	" "	702	98	800	Roadwork
Sprinkling	M-Gals.	205	25	230	Roadwork
Shoring, Cribbing, Etc.	Lump Sum	All	—	All	Structure
Structural Excavation	Cu. Yd.	448	42	490	Structure
Excavation Below Elevations Shown	" "	0	40	40	Structure
Class 'A' Concrete	" "	1,003	47	1,050	Structure
Metal Reinforcement	Lb.	228,000	11,000	239,000	Structure
8" Metal Drain Pipe	Lin. Ft.	90	10	100	Structure

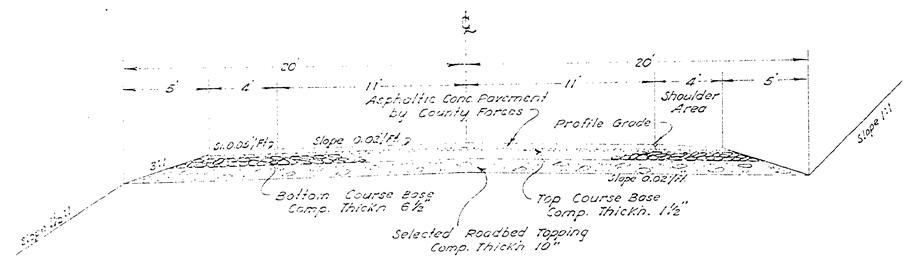

TYPICAL SECTION

FILED
RECEIVED
NOV 7 1967
COUNTY SURVEYOR
DOUGLAS COUNTY, ORE.

01750260X

SEPT. 1955 SH. 2 OF 4
ROAD No. 20-A