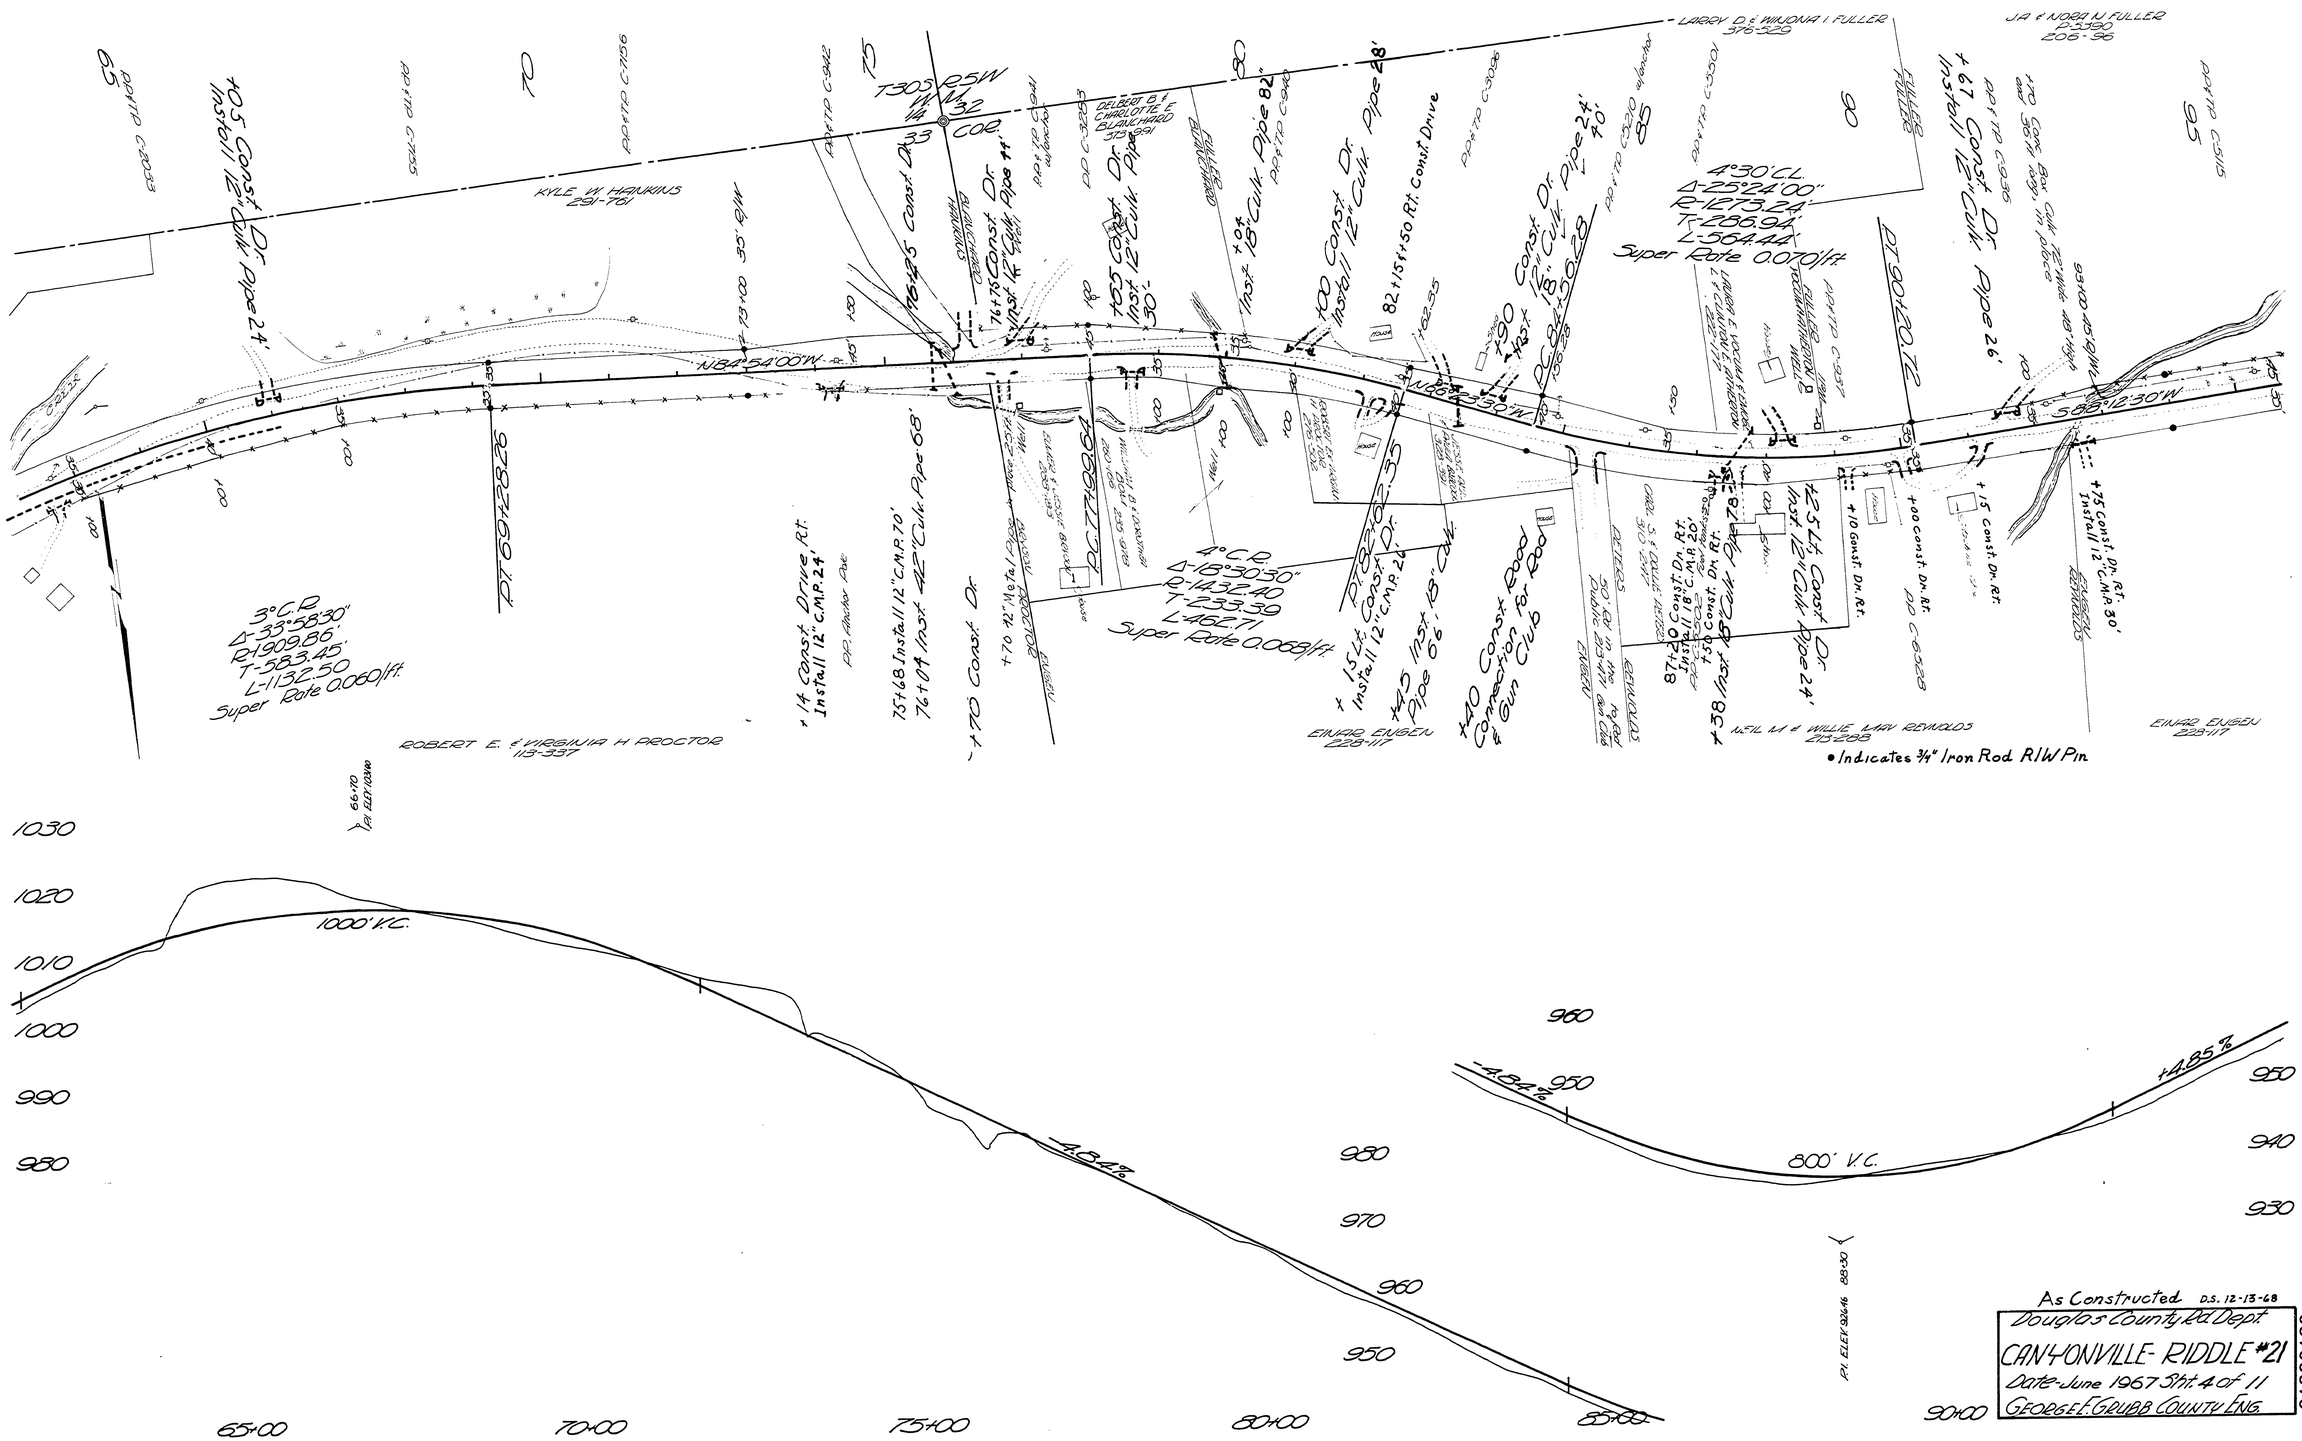

As Constructed D.S. 12-13-68
Douglas County Rd Dept.
CANYONVILLE-RIDDLE #21
Date-June 1967 Sht. 4 of 11
GEORGE E. GRUBB COUNTY ENG.
01260183

M.P. 1.26 - 1.23

Co Rd. #21 JUNE, 1967 SHT. 4 of 11

59