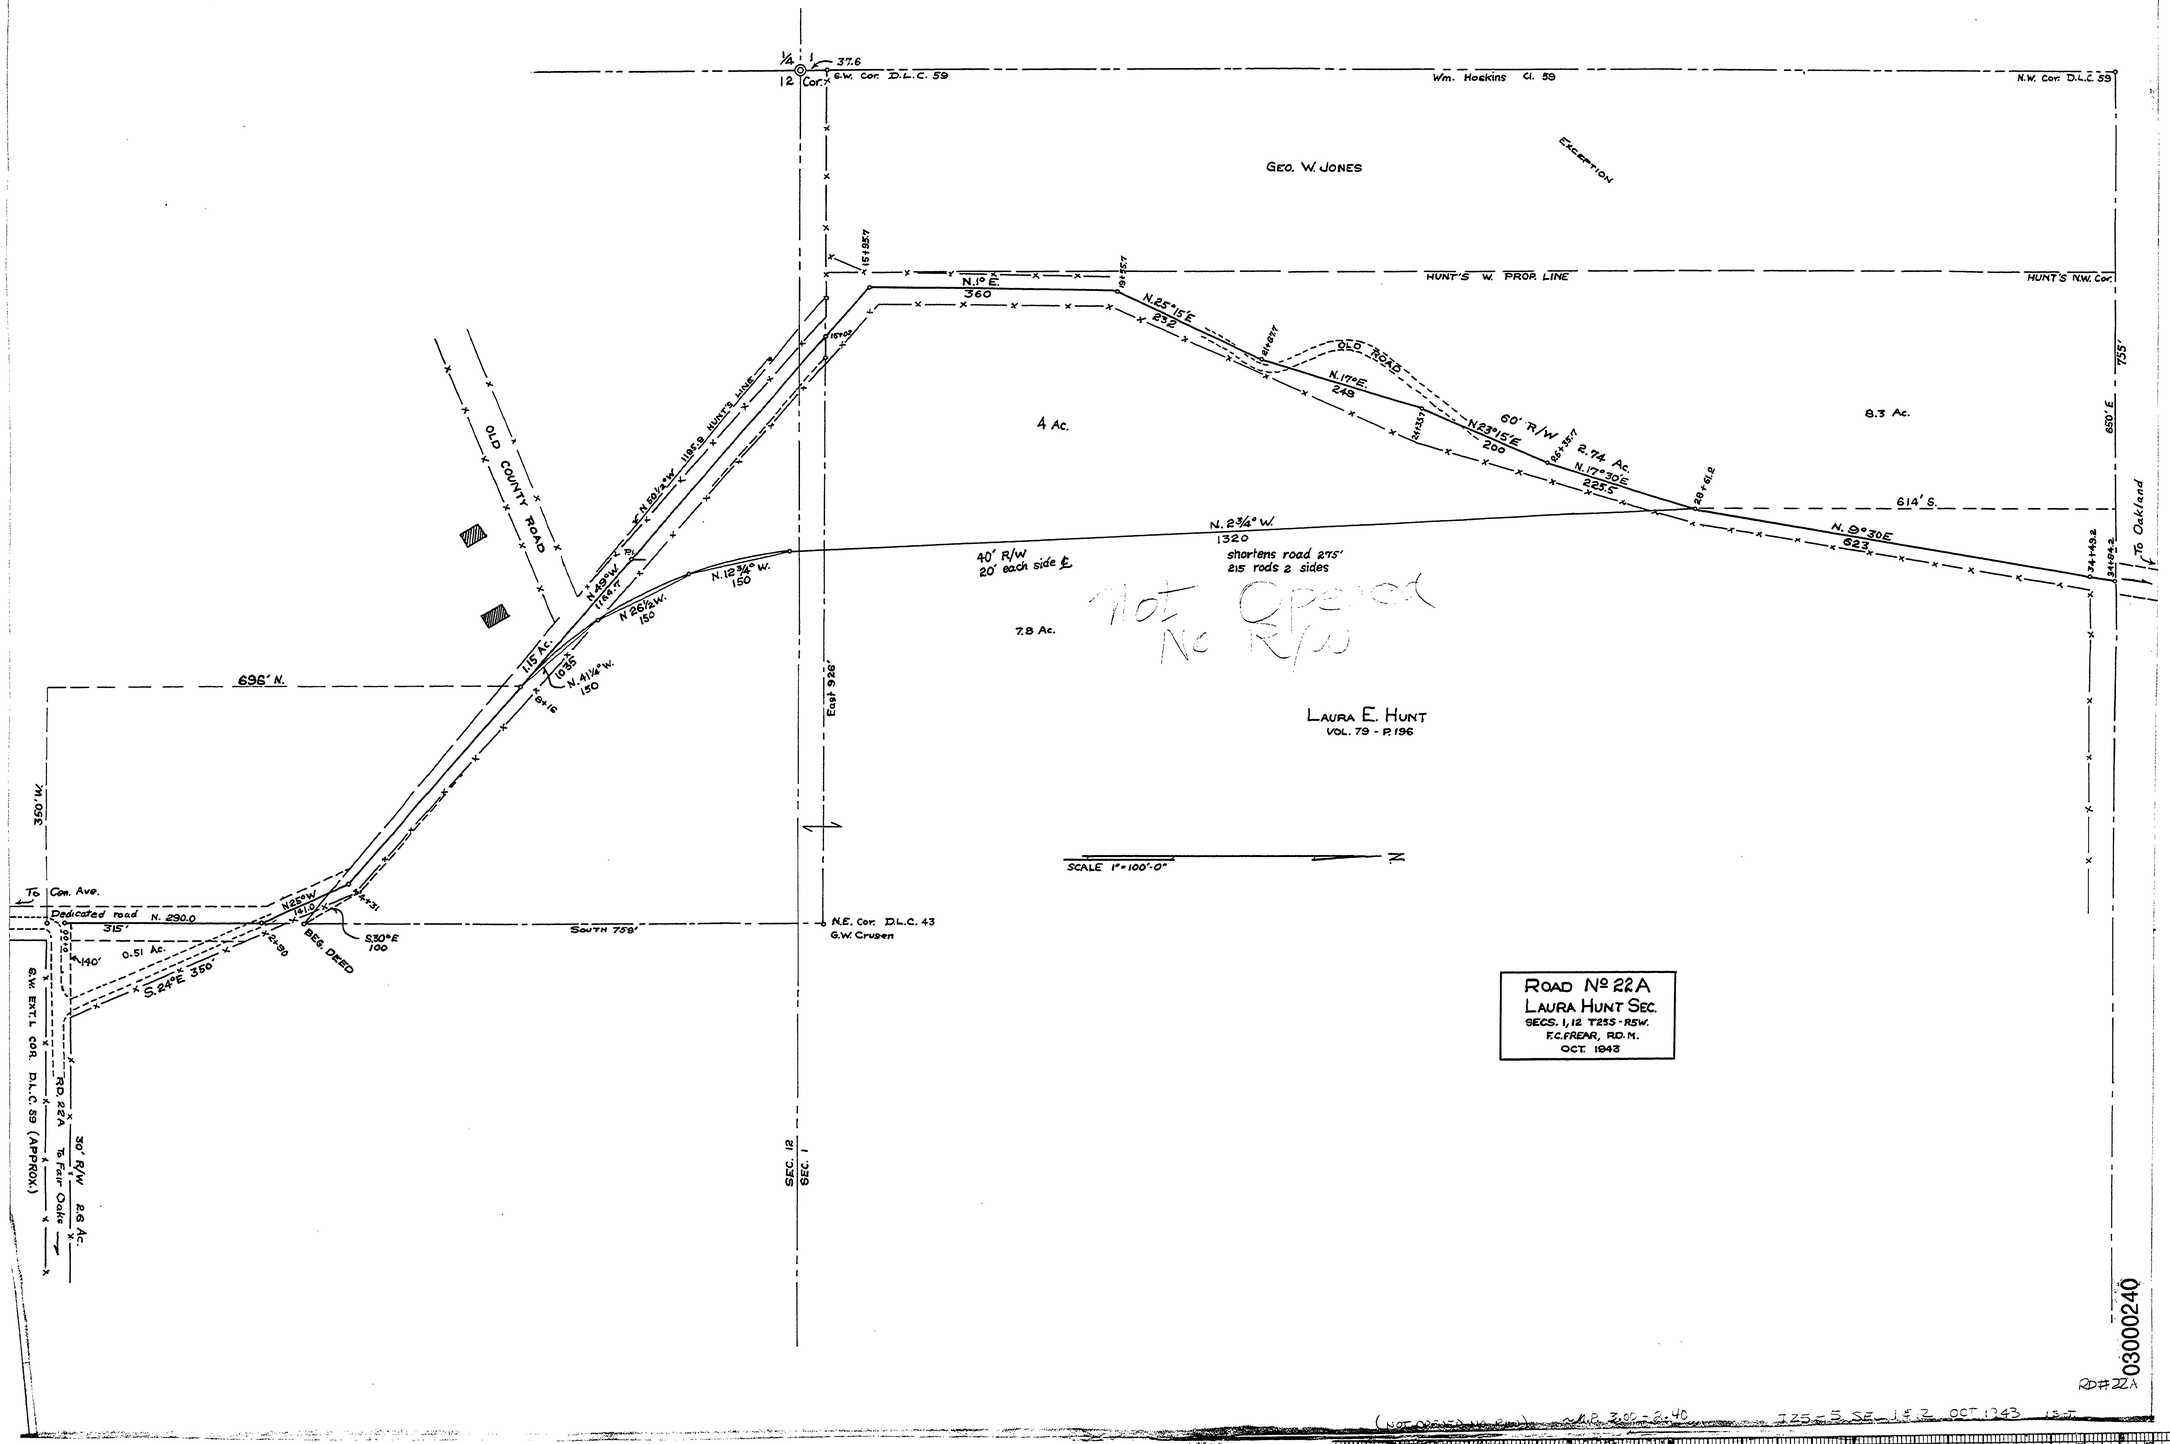
1/4
1
12
Cor.
37.6
S.W. Cor. D.L.C. 59
Wm. Hoskins Cl. 59
N.W. Cor. D.L.C. 59
GEO. W. JONES
EXCEPTION
HUNT'S W. PROP. LINE
HUNT'S N.W. Cor.
N. 1° E.
360
N. 25° 15' E.
232
OLD ROAD
N. 17° E.
248
N. 23° 15' E.
200
60' R/W
2.74 Ac.
N. 17° 30' E.
225.5
8.3 Ac.
755'
650' E.
614' S.
To Oakland
4 Ac.
OLD COUNTY ROAD
N. 2¾° W.
1320
shortens road 275'
215 rods 2 sides
40' R/W
20' each side ℄
N. 12¾° W.
150
N. 26½° W.
150
N. 41¼° W.
150
N. 49° W.
1748.7'
N. 50¼° W. 1195.8 HUNT'S LINE
115 Ac.
7.8 Ac.
Not Opened
No R/W
696' N.
350' W.
East 928'
LAURA E. HUNT
VOL. 79 - P. 196
SCALE 1" = 100'-0"
To Con. Ave.
Dedicated road N. 290.0
315'
0.51 Ac.
140'
S. 24° E. 350'
N. 25° W.
1210
BEG. DEED
S. 30° E.
100
SOUTH 758'
N.E. Cor. D.L.C. 43
G.W. Crusen
S.W. EXT. L COR. D.L.C. 59 (APPROX.)
R.D. 22A
To Fair Oaks
30' R/W
2.6 Ac.
SEC. 12
SEC. 1
ROAD Nº 22A
LAURA HUNT SEC.
SECS. 1, 12 T25S - R5W.
F.C. FREAR, R.D.M.
OCT. 1943
RD#22A
03000240