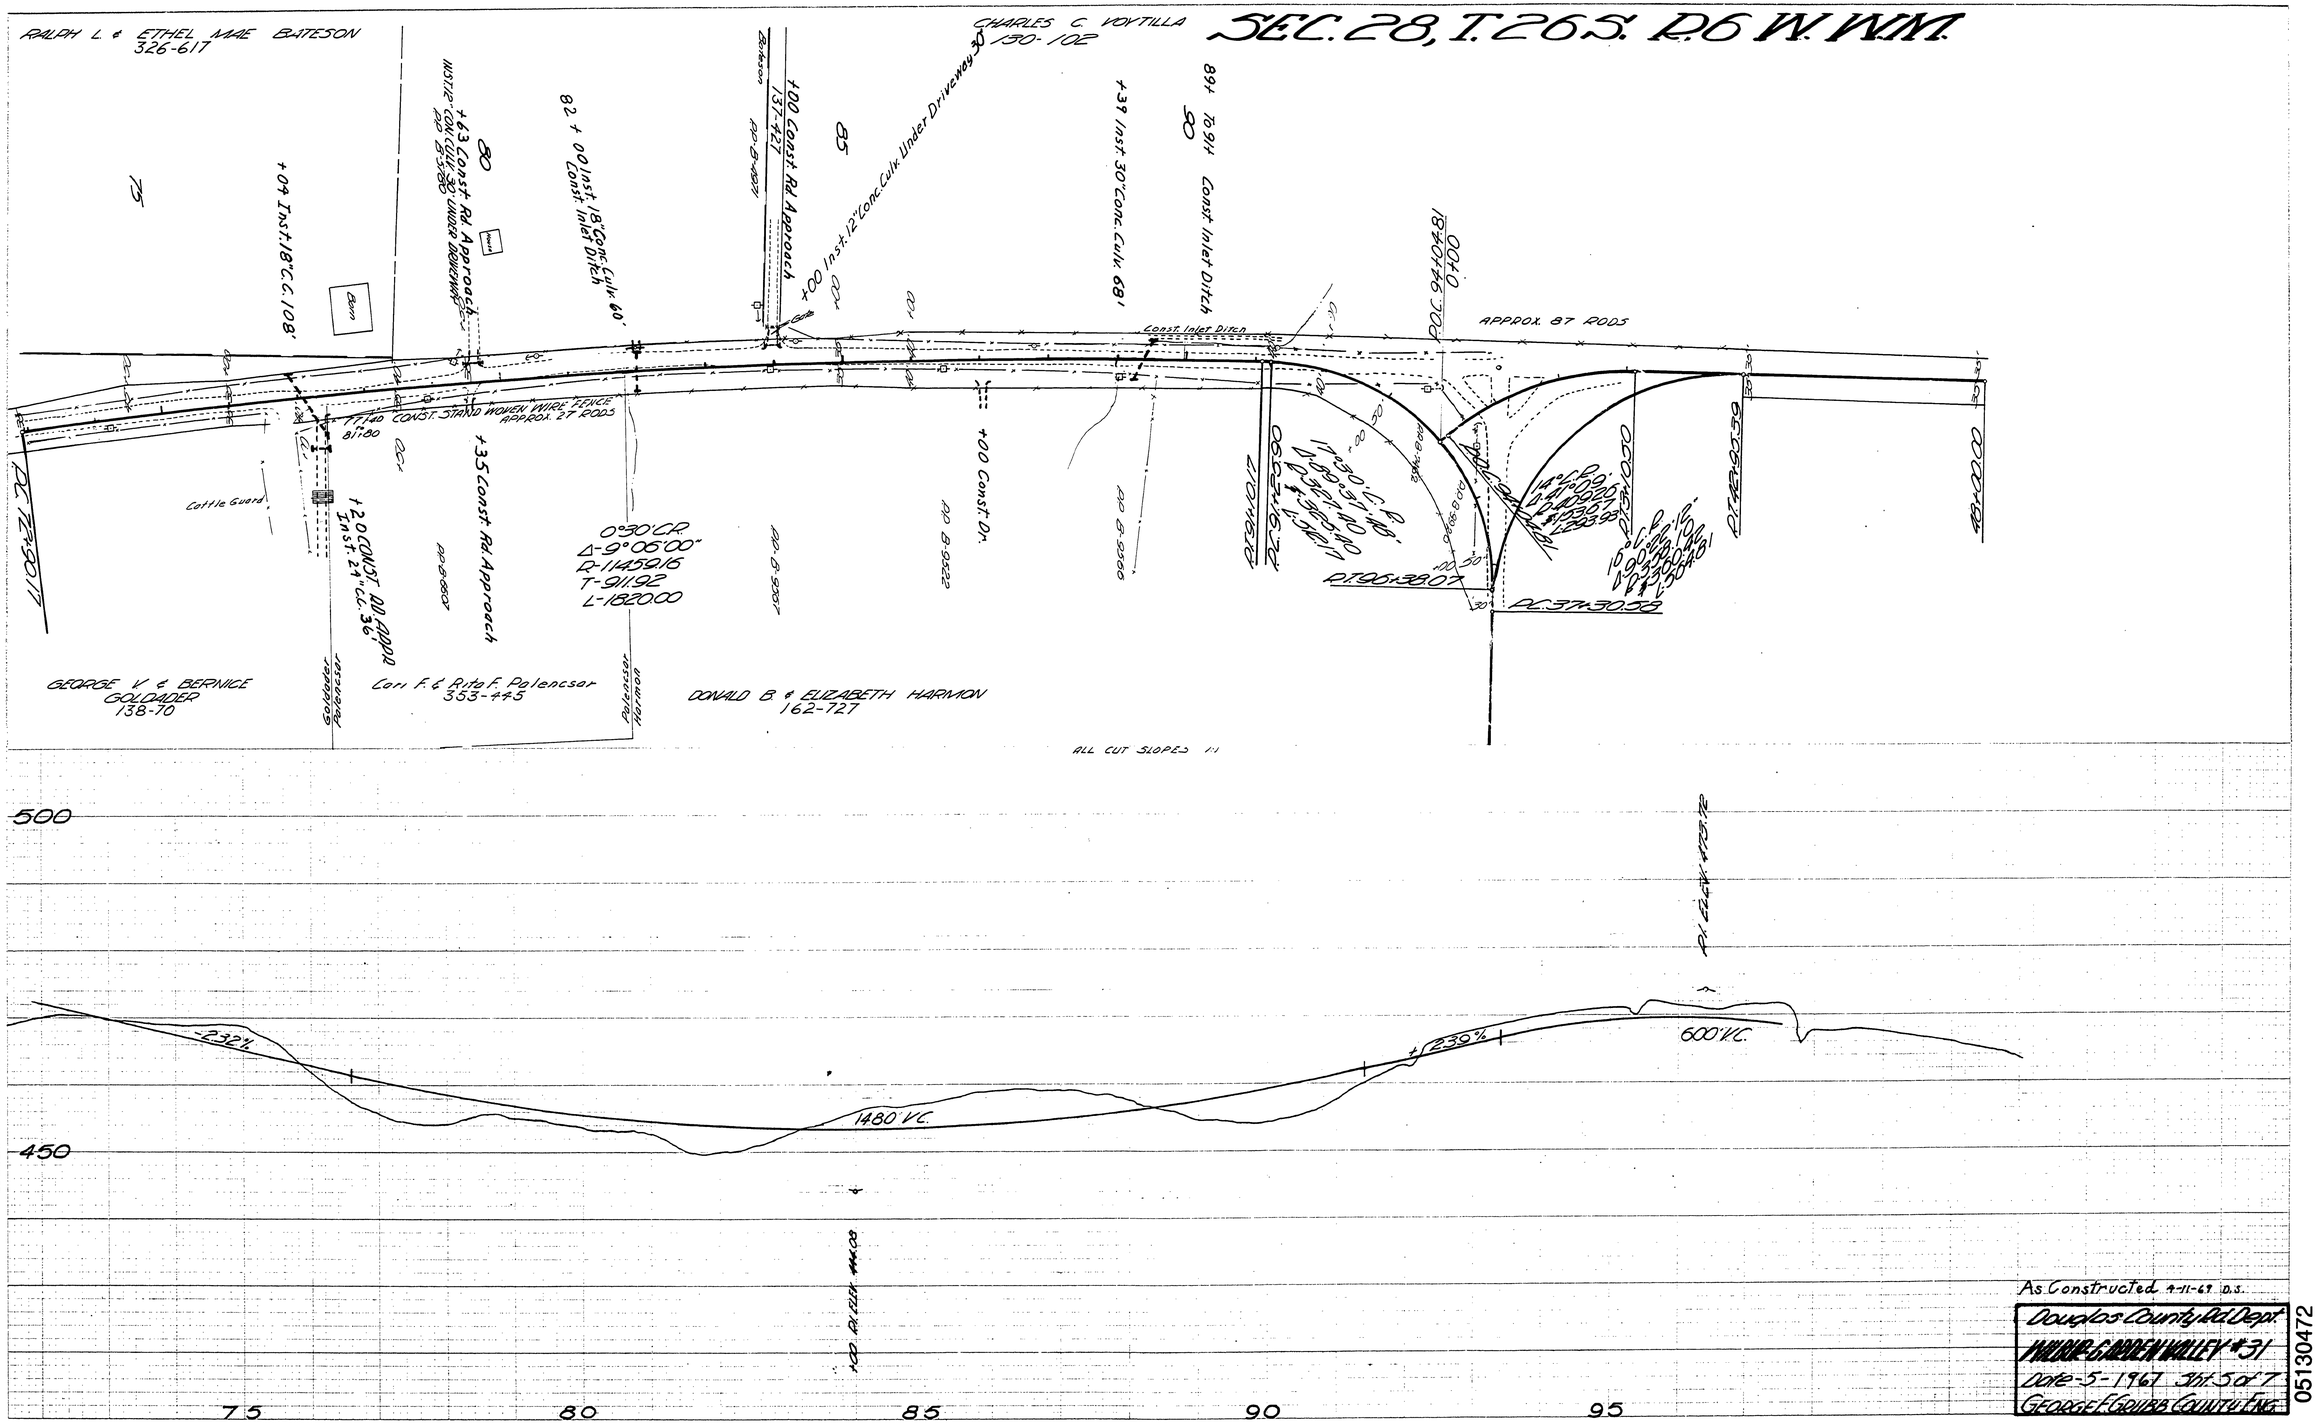SEC. 28, T. 26 S. R. 6 W. W.M.