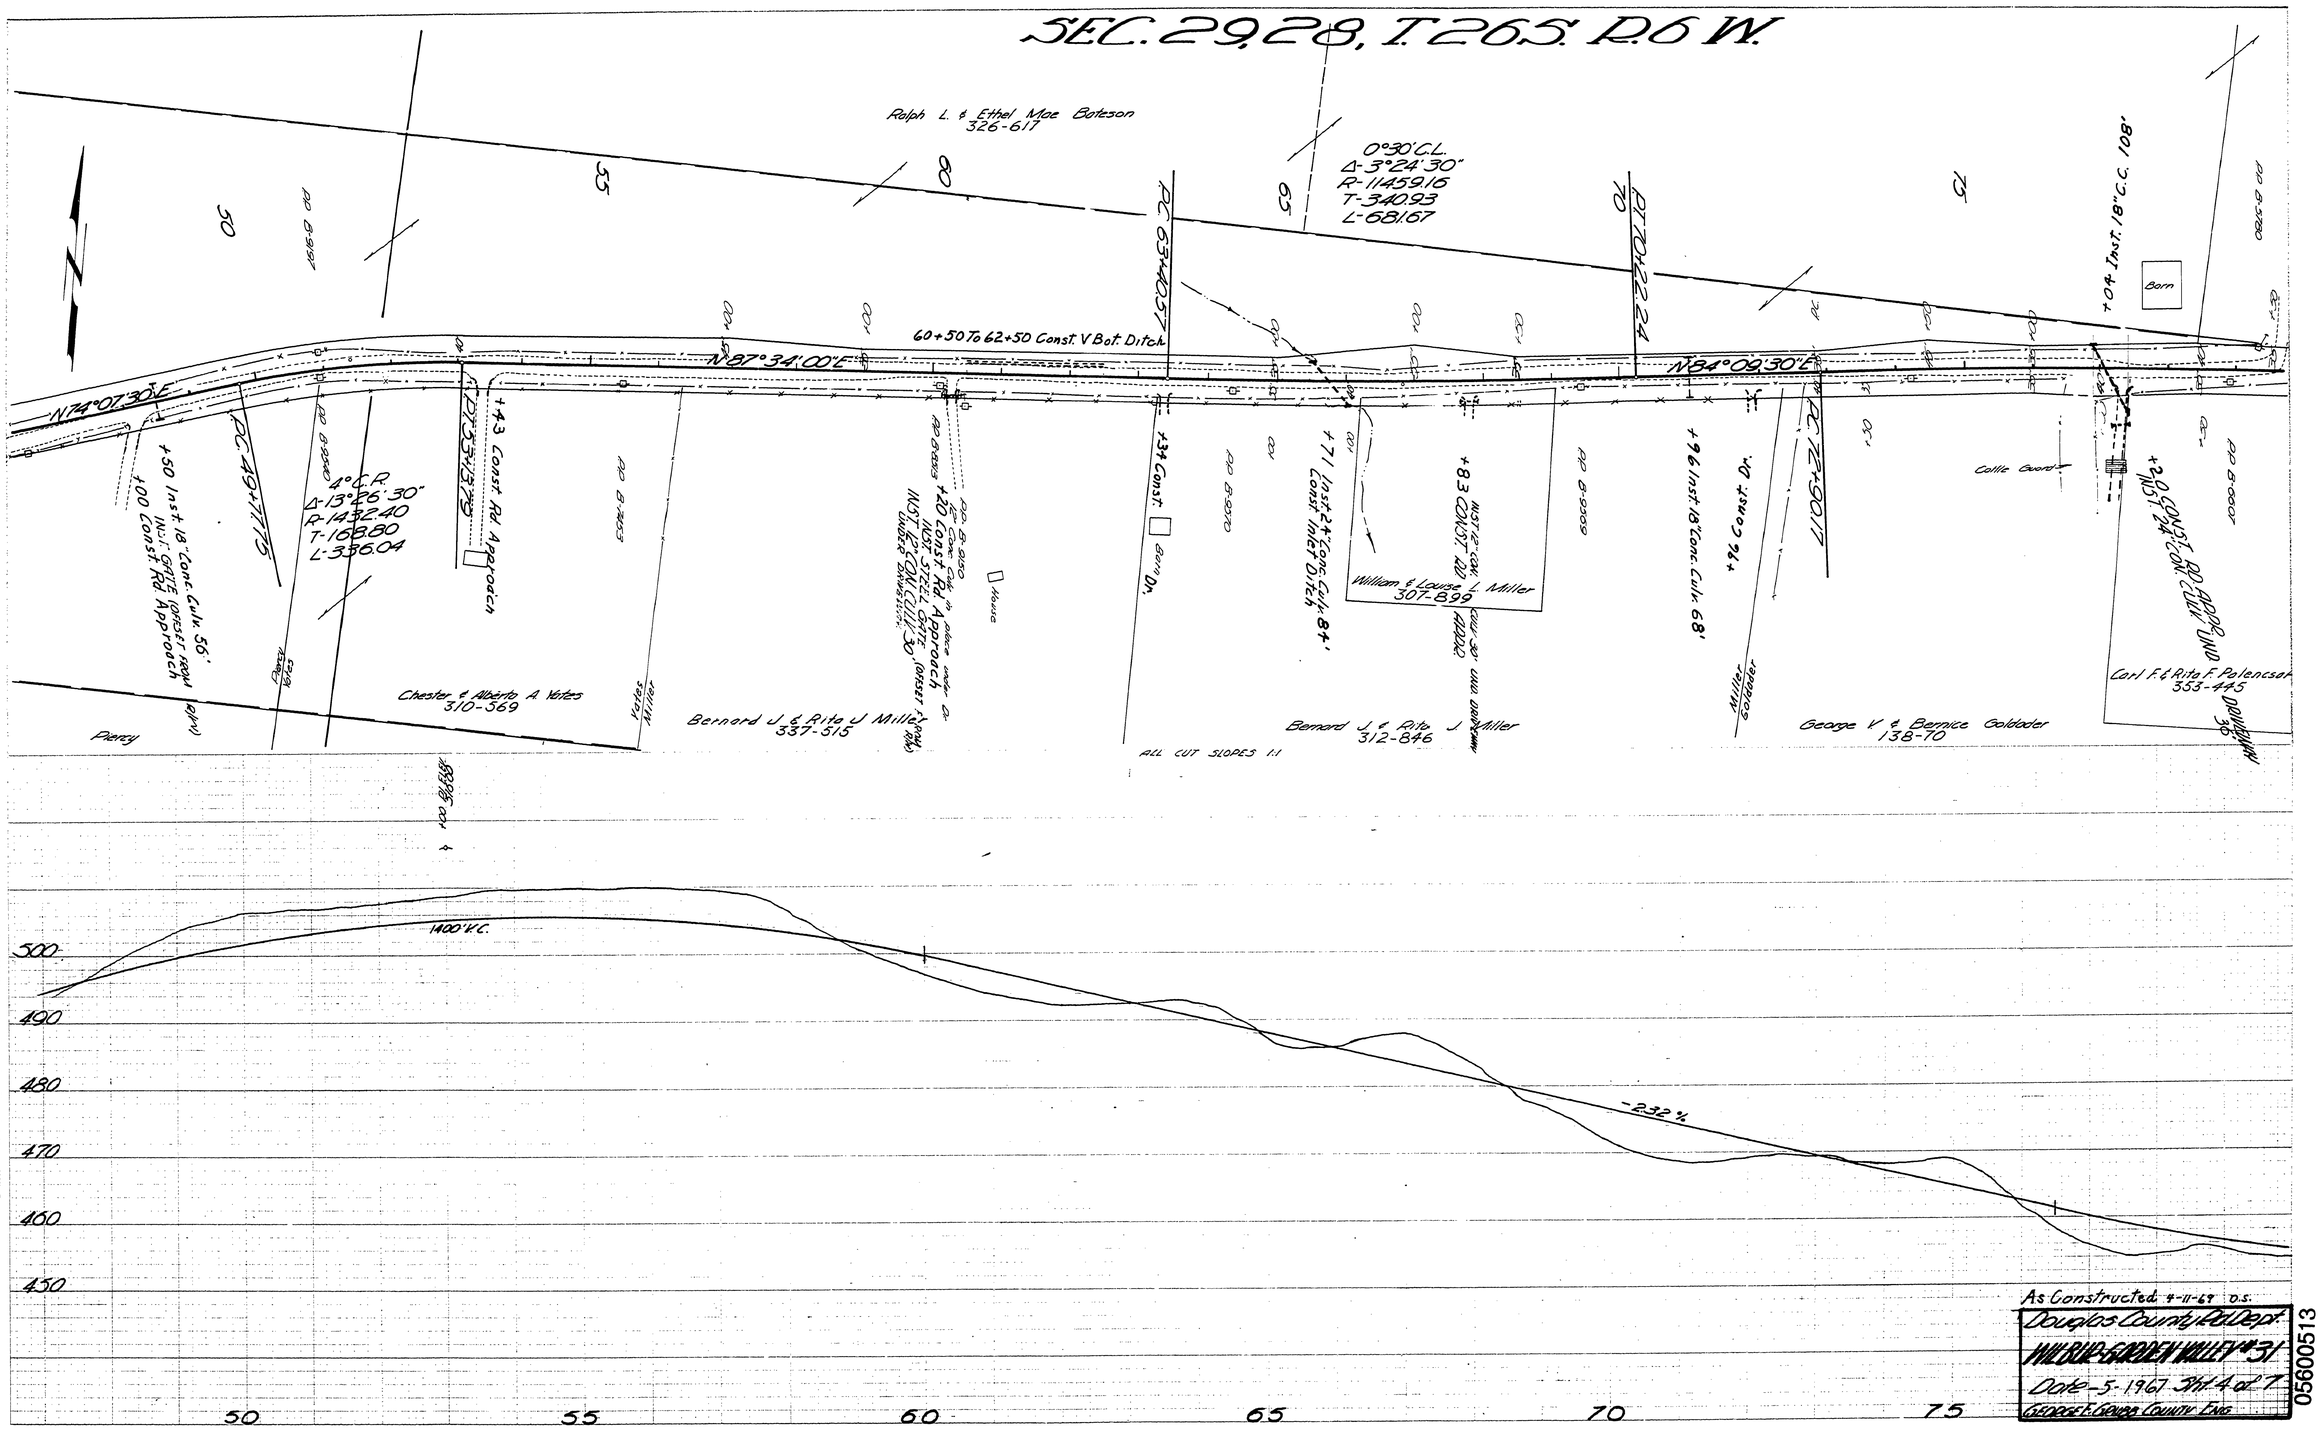

M.P. 5.60 - 5.13

Co. Rd. # 31

MAY, 1967

Sht. 4 of 7

53