SEC. 29, T.26S. R6W.W.M.

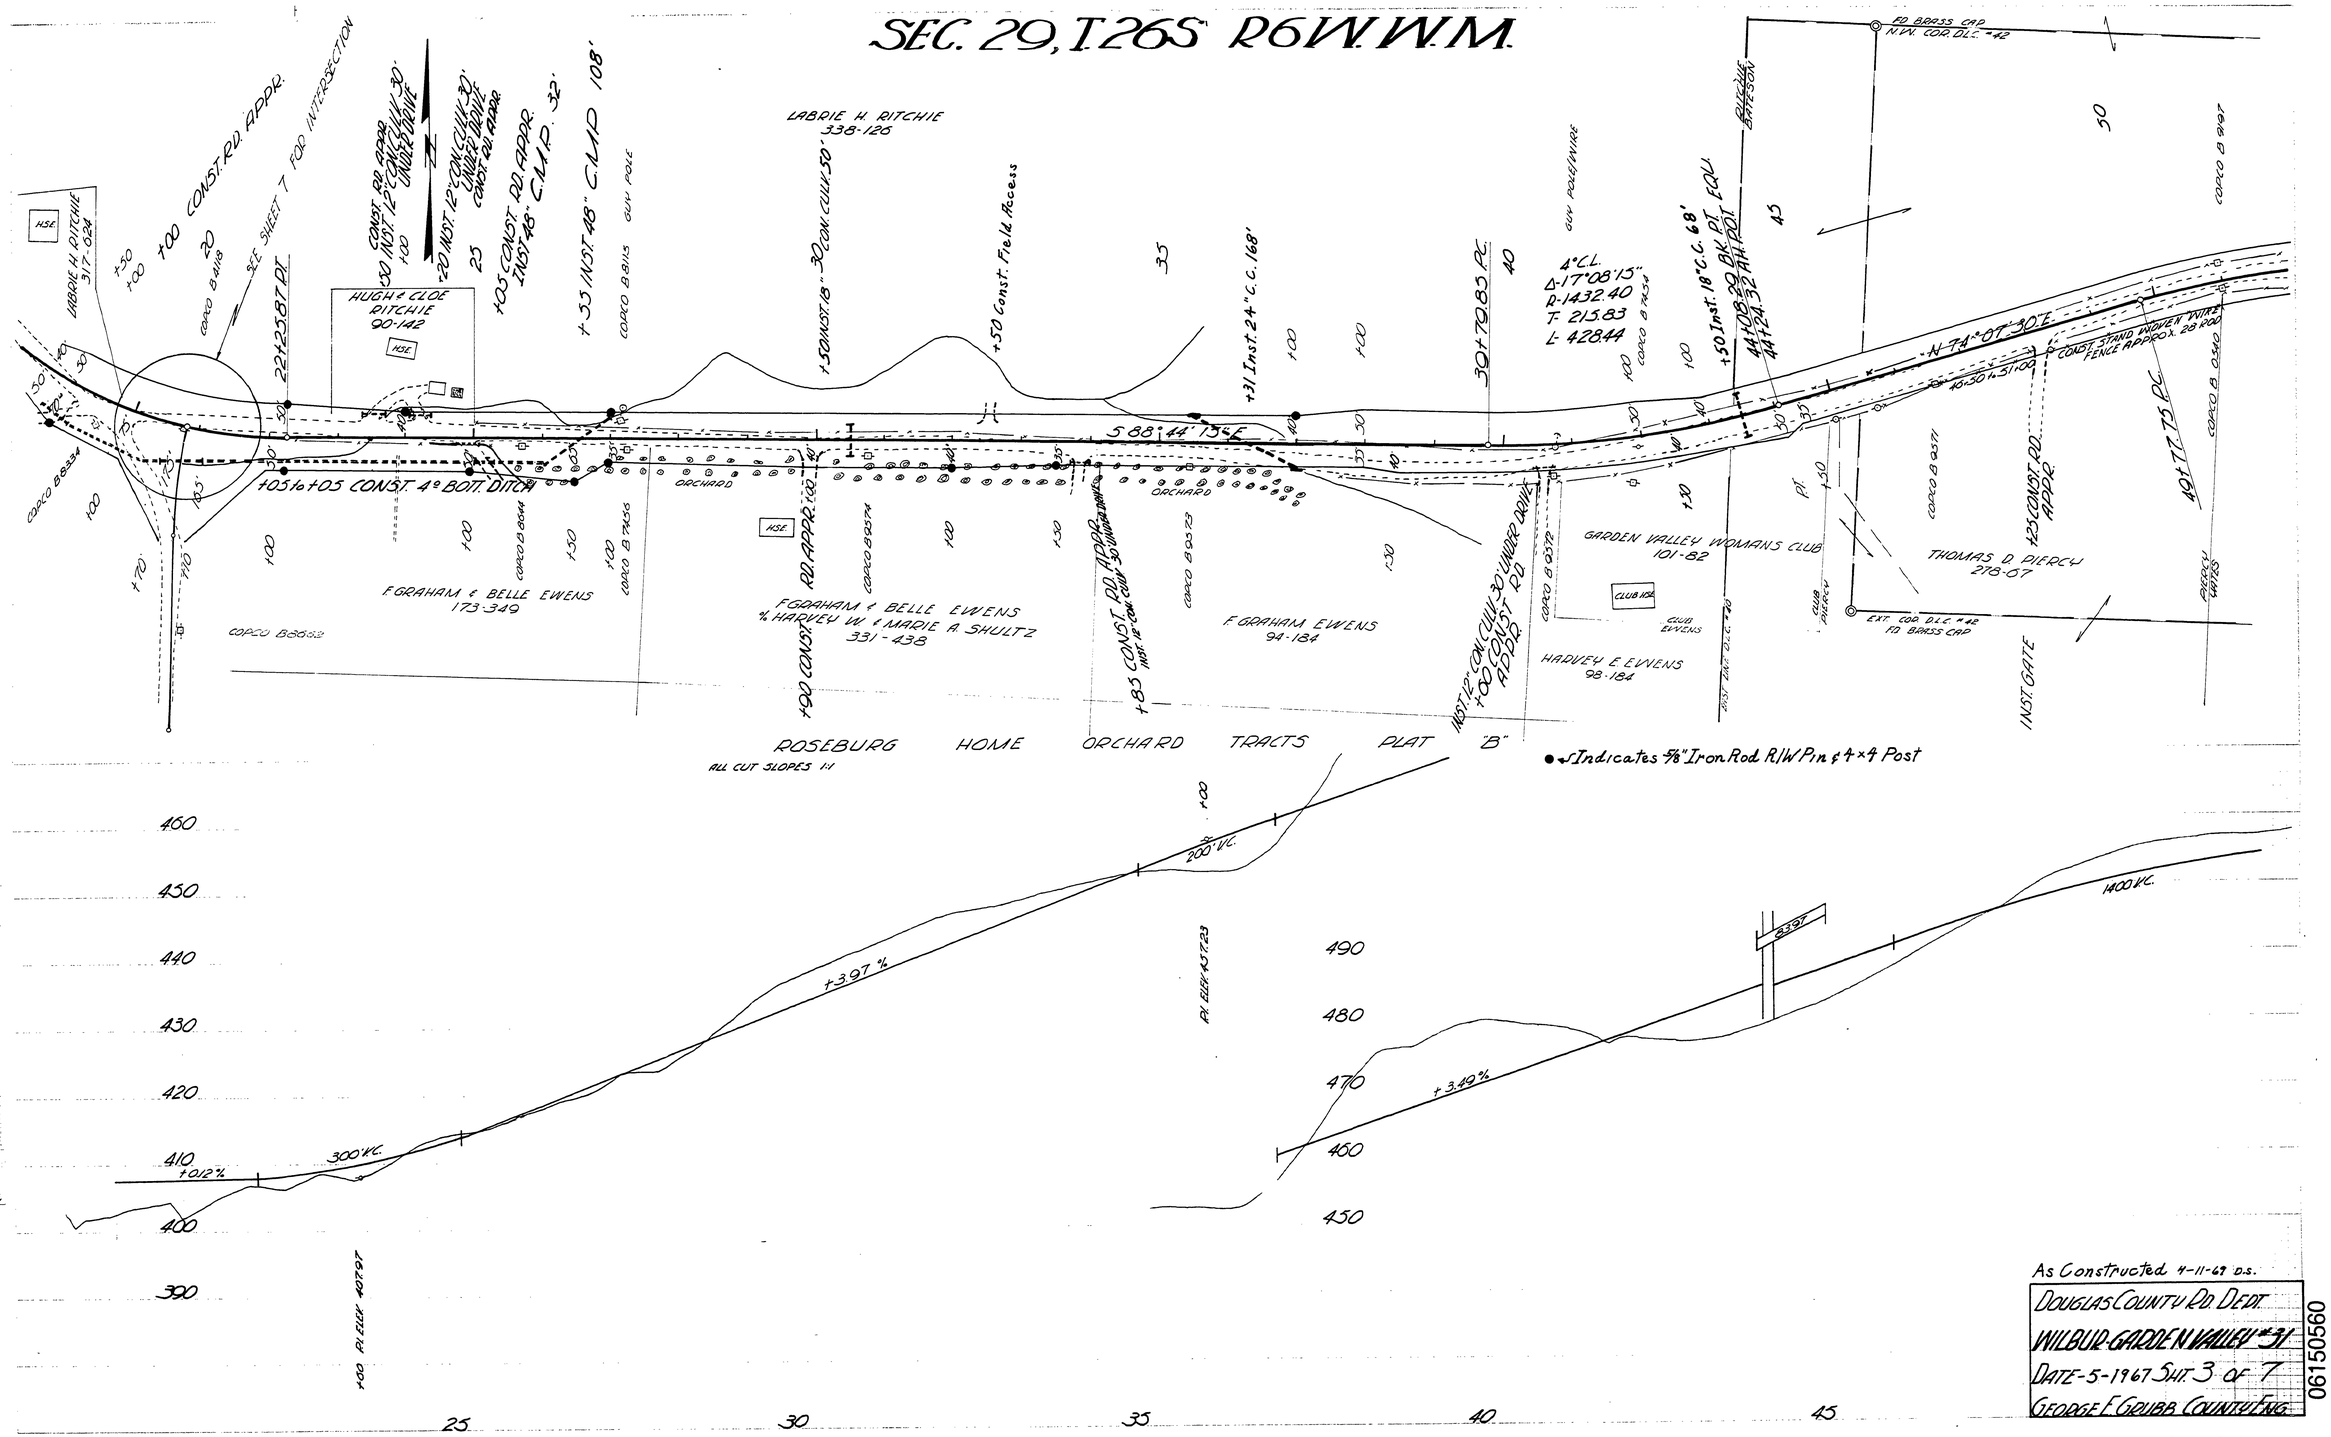

As Constructed 4-11-67 D.S.

DOUGLAS COUNTY RD. DEPT.
WILBUR-GARDEN VALLEY #31
DATE-5-1967 SHT. 3 of 7
GEORGE E. GRUBB, COUNTY ENG.

06150560

M.P. 6.15 - 5.60

May, 1967

Co. Rd. #31 sht. 3 of 7

52