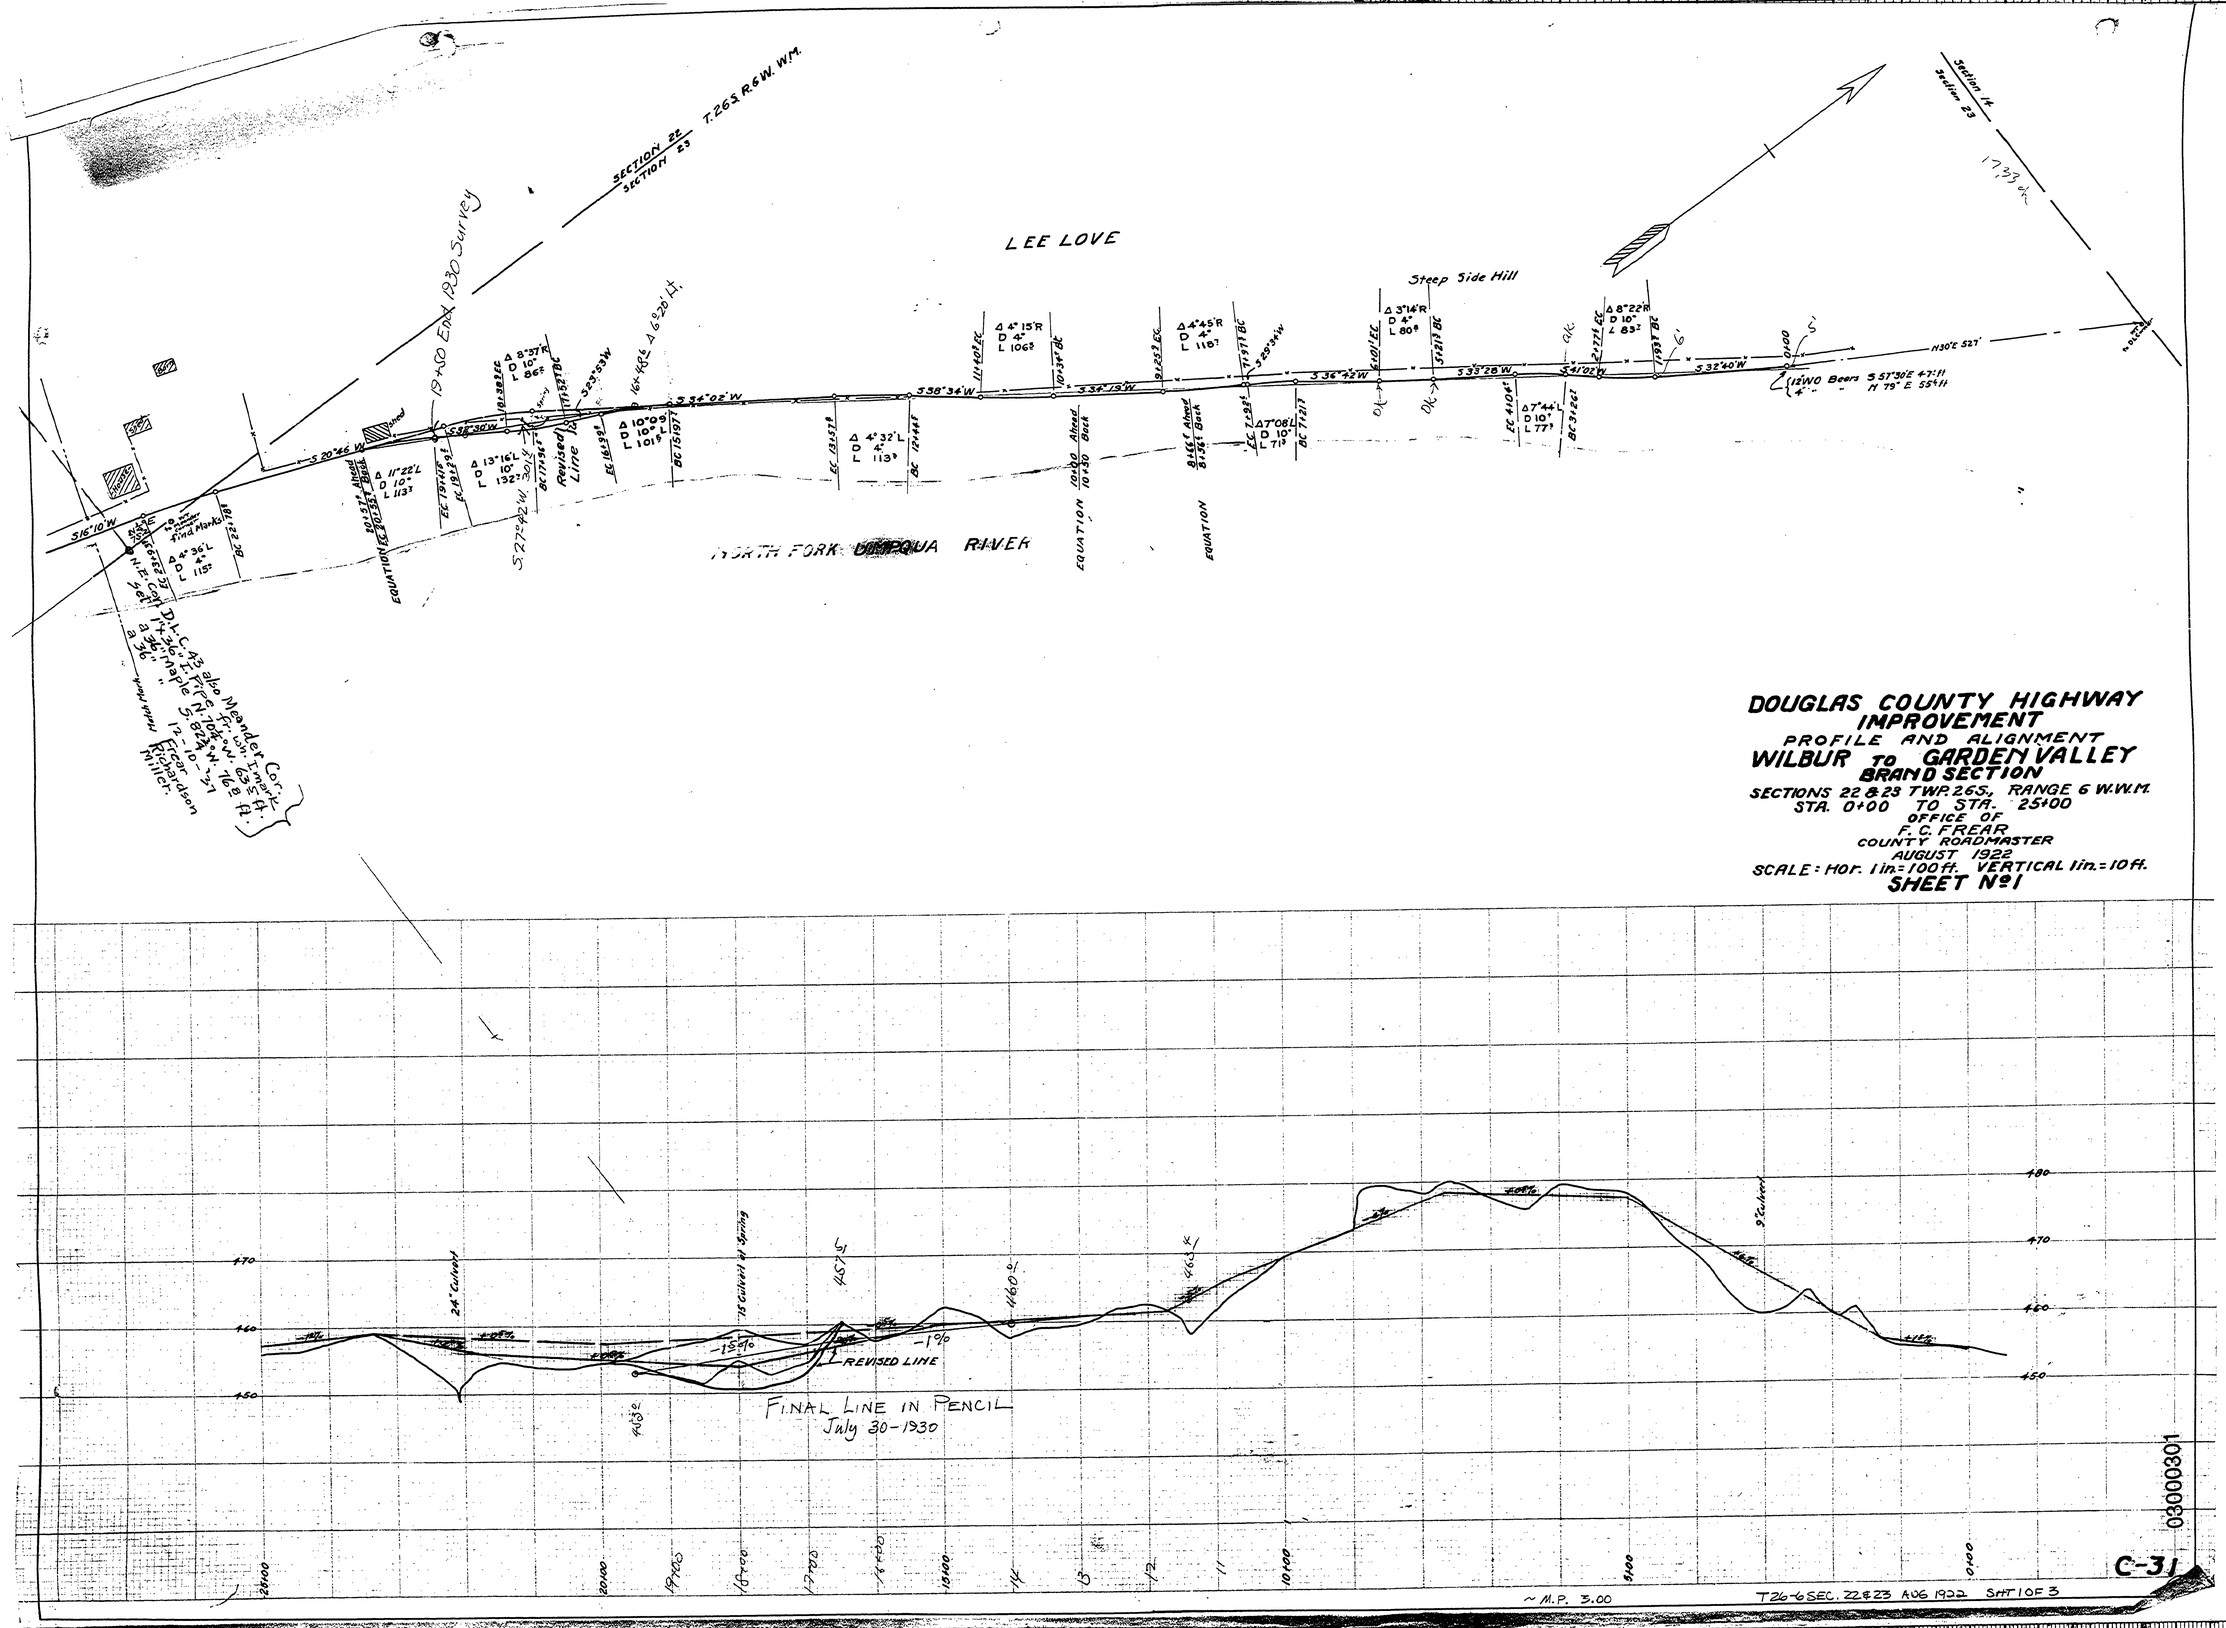

DOUGLAS COUNTY HIGHWAY IMPROVEMENT

PROFILE AND ALIGNMENT

WILBUR TO GARDEN VALLEY

BRAND SECTION

SECTIONS 22 & 23 TWP. 26 S., RANGE 6 W.W.M.

STA. 0+00 TO STA. 25+00

OFFICE OF
F. C. FREAR
COUNTY ROADMASTER

AUGUST 1922

SCALE: HOR. 1 in. = 100 ft. VERTICAL 1 in. = 10 ft.

SHEET No 1