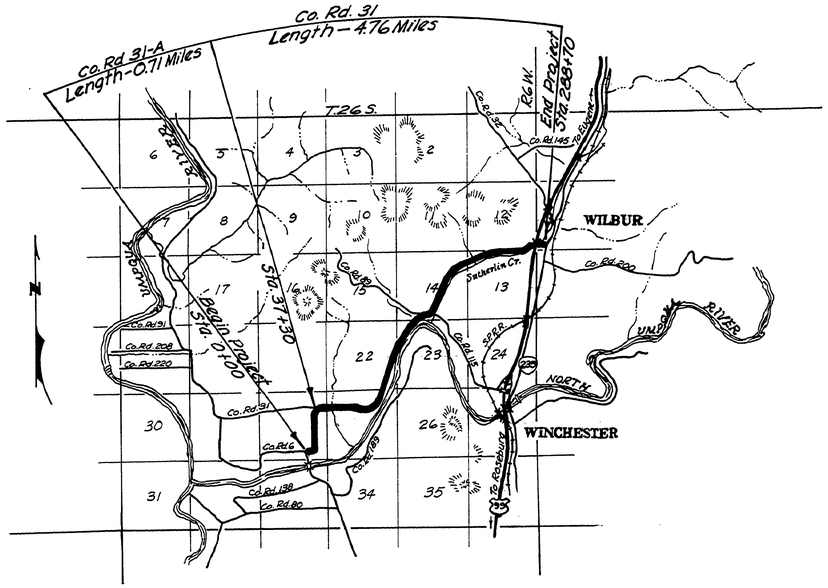

DOUGLAS COUNTY ROAD DEPARTMENT

Douglas County, Oregon

PLANS FOR PROPOSED PROJECT

AS CONSTRUCTED
WILBUR-GARDEN VALLEY
&
WEST SIDE OVERLAND ORCHARD

County Road No's. 31 & 31-A

August 1961

REGISTERED PROFESSIONAL ENGINEER 4259 GEORGE E. GRUSS MAY 2, 1958

TYPICAL SECTIONS

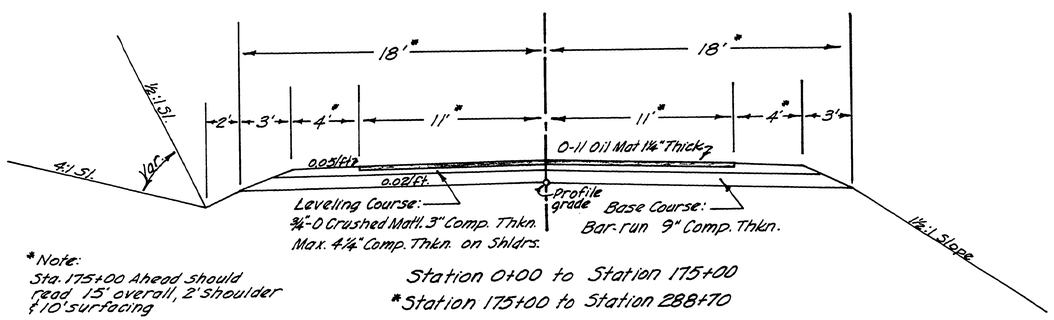

*Note:
Sta. 175+00 Ahead should read 15' overall, 2' shoulder & 10' surfacing

Station 0+00 to Station 175+00

*Station 175+00 to Station 288+70

FILED
RECEIVED
FEB 15 1963
COUNTY SURVEYOR
DOUGLAS COUNTY, ORE.

0472000C

Sheet 1 of 13

Aug., 1961

Co. Rd. # 31-A

Sht. 1 of 13

37