DOUGLAS COUNTY HIGHWAY SURVEYS

PROFILE & ALIGNMENT
Of
(KEYSER SECT.)
WILBUR-UMPQUA ROAD
SECS. 28, 29, 31 & 32 - T. 25 S. - R. 6 W. - W.M.
Sta. 0+00 to Sta. 107+15

Datum, Bearings True
M. B. Germond C.E. Co. Surveyor and Roadmaster.
Surveyed & Platted by F.C. Frear Dep. Co. Sur.
Apr. 1919.

Filed _____ 1919.
By _____
County Clerk

Petition of J. Winniford R.R. 8 Page 359
Bond of Petitioners R.R. 8 Page 359
Affadavit of Posting R.R. 8 Page 359
Notice of Petition, Mar. 1, 1919, R.R. 8 Page 360
Order to View
Report of Viewers Apr. 29, 1919 R.R. 8 Pg. 360
Report of Surveyor Filed Oct. 7, 1920 R.R. 8 Pg. 360
First Reading
Second Reading

John A. Winniford to Douglas County
40' Right of way St 62+14 to 77+21.2
Consideration 287.20
Road Record 8 Page 312
Filed Oct. 23, 1919

Alfred Davison to Douglas County
40' Right of way St. 104+33.8 to 77+18.8
Consideration $497.40
Road Record 8 Page 318
Nov. 25, 1919

Scale 1 in. = 400 ft.

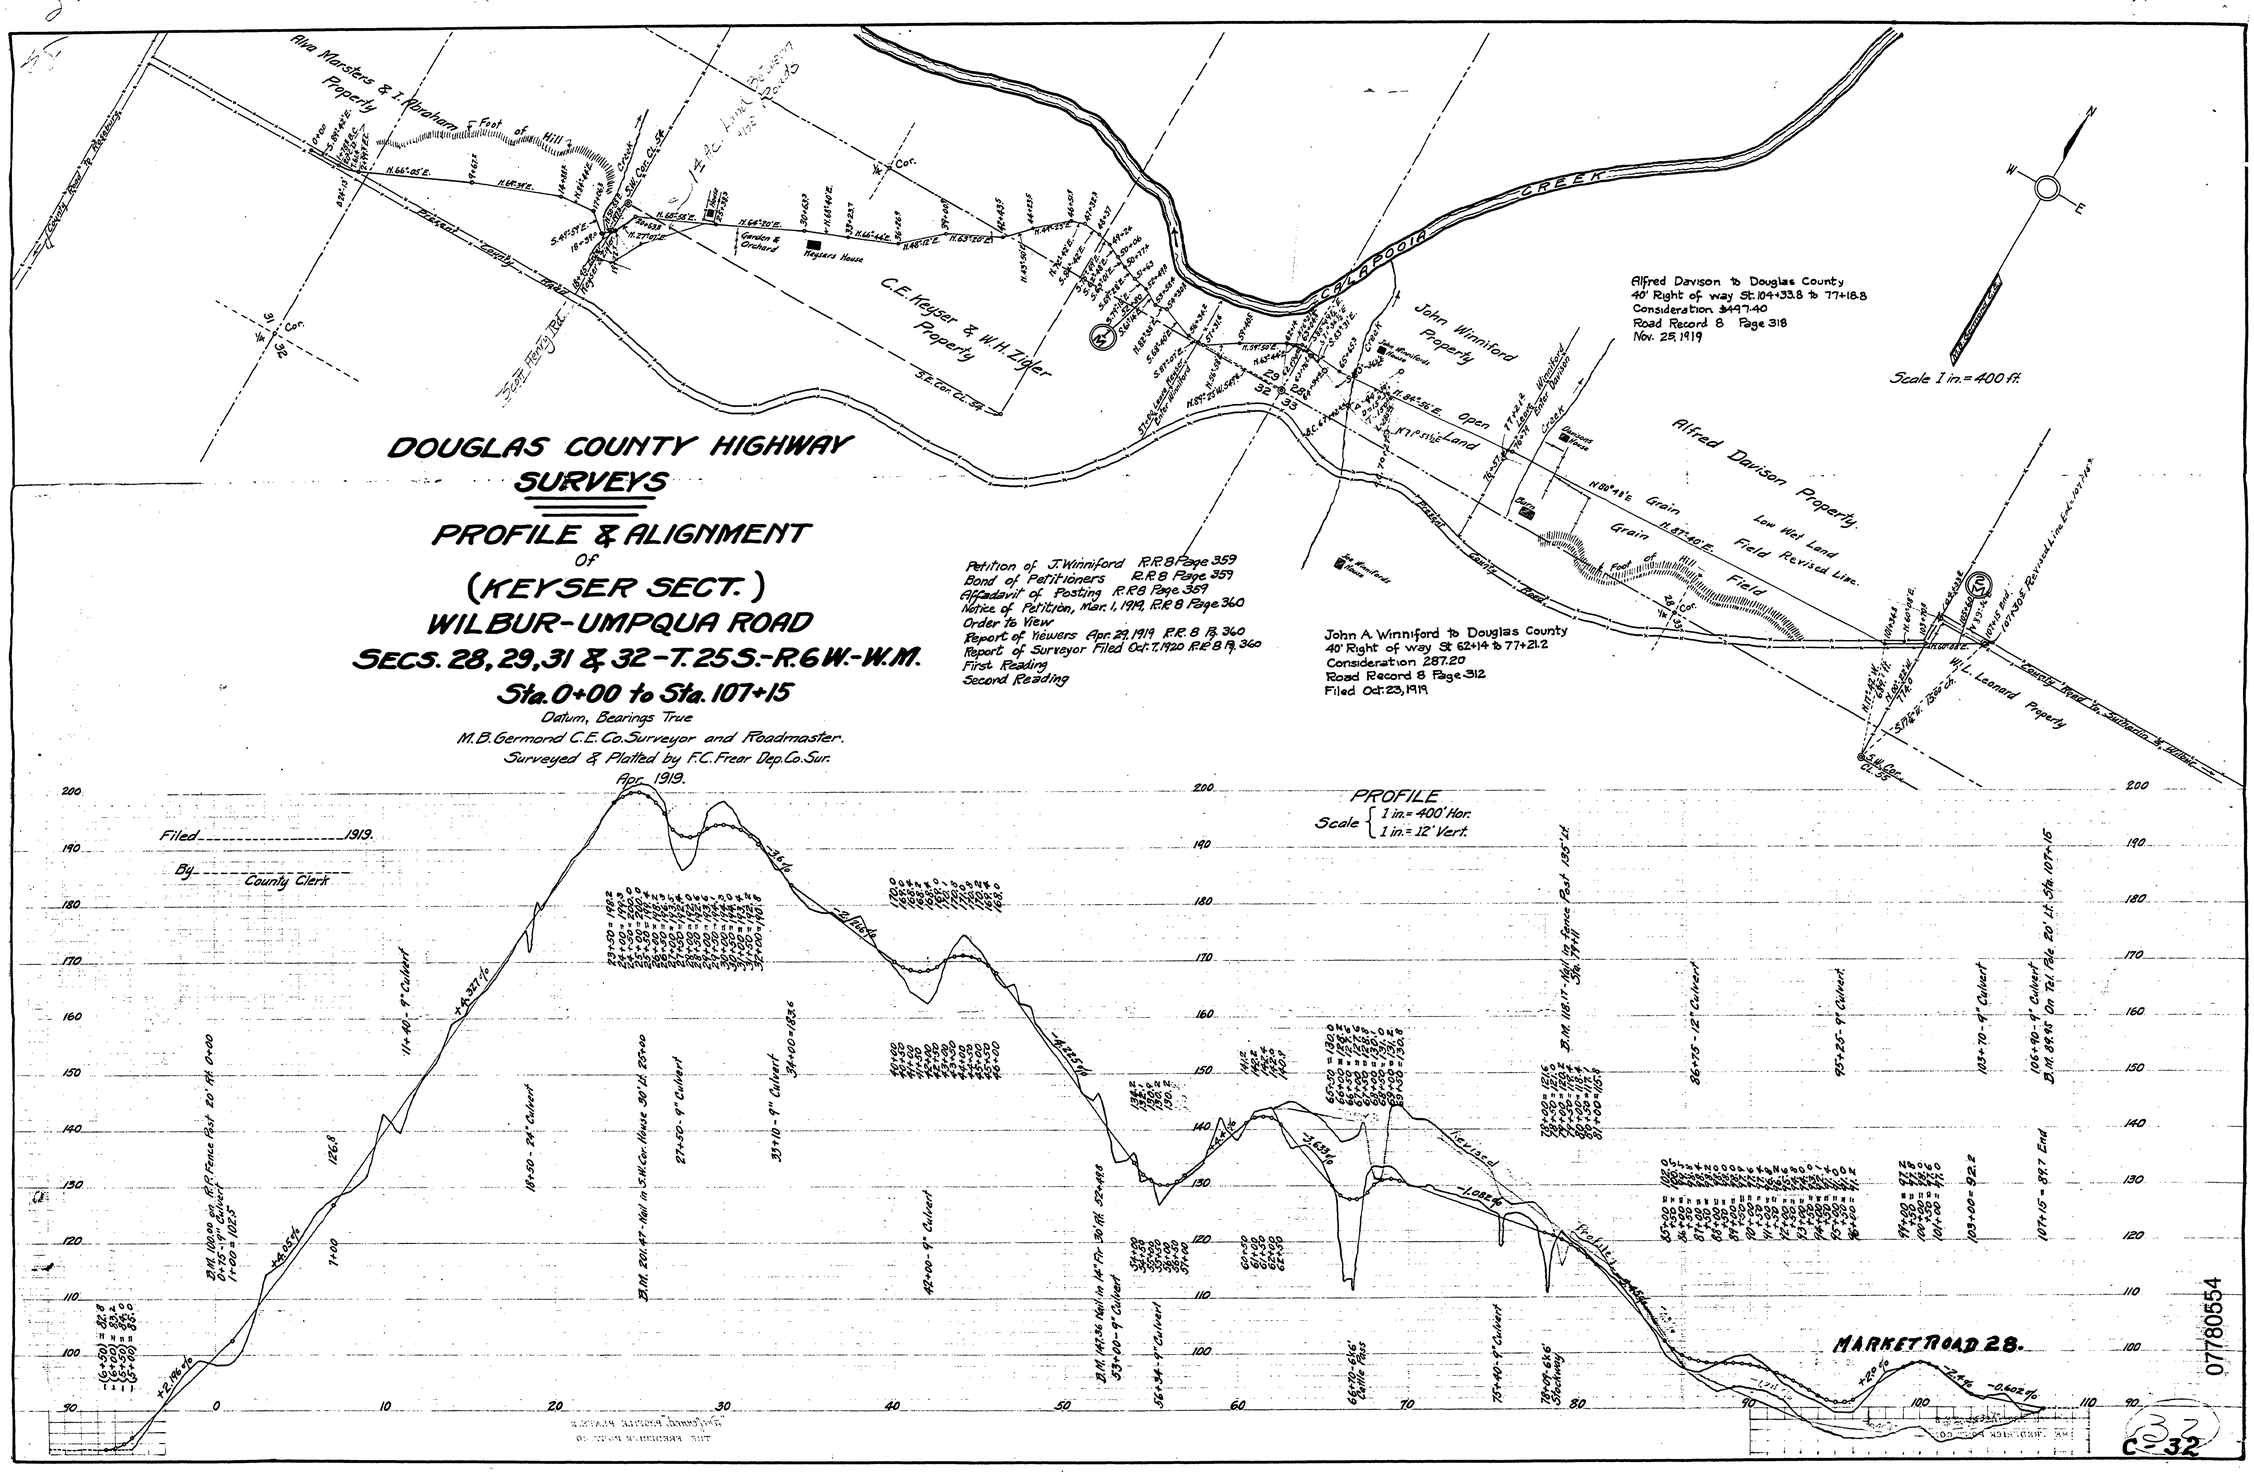

07780554

C-32

~ M.P. 7.78.-5.54

T25-6 SEC 28,29,31,&32 APRIL 1919

21