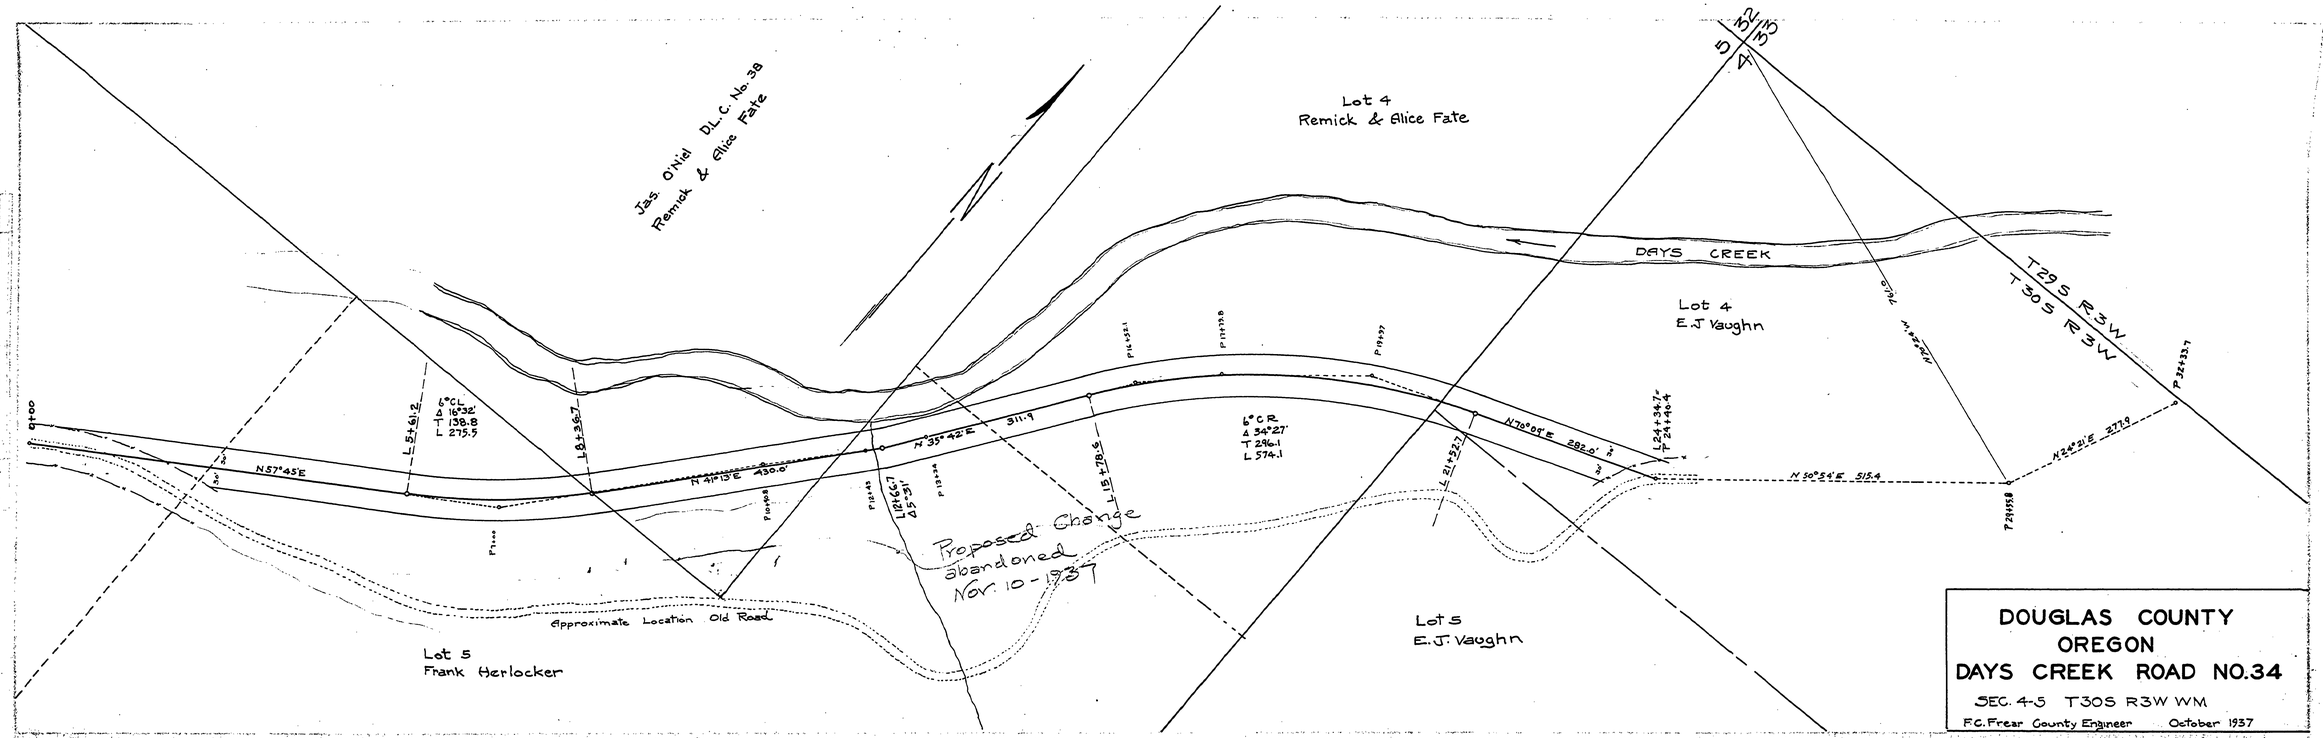

PROFILE
HORIZ. SCALE
VERT. SCALE
REPORT
RECORD CHECKED
BY
DATE

046 20391

ROAD No. 34

~M.P. 4.52-3.91

T30-3 SEC. 4-5 OCT 1937