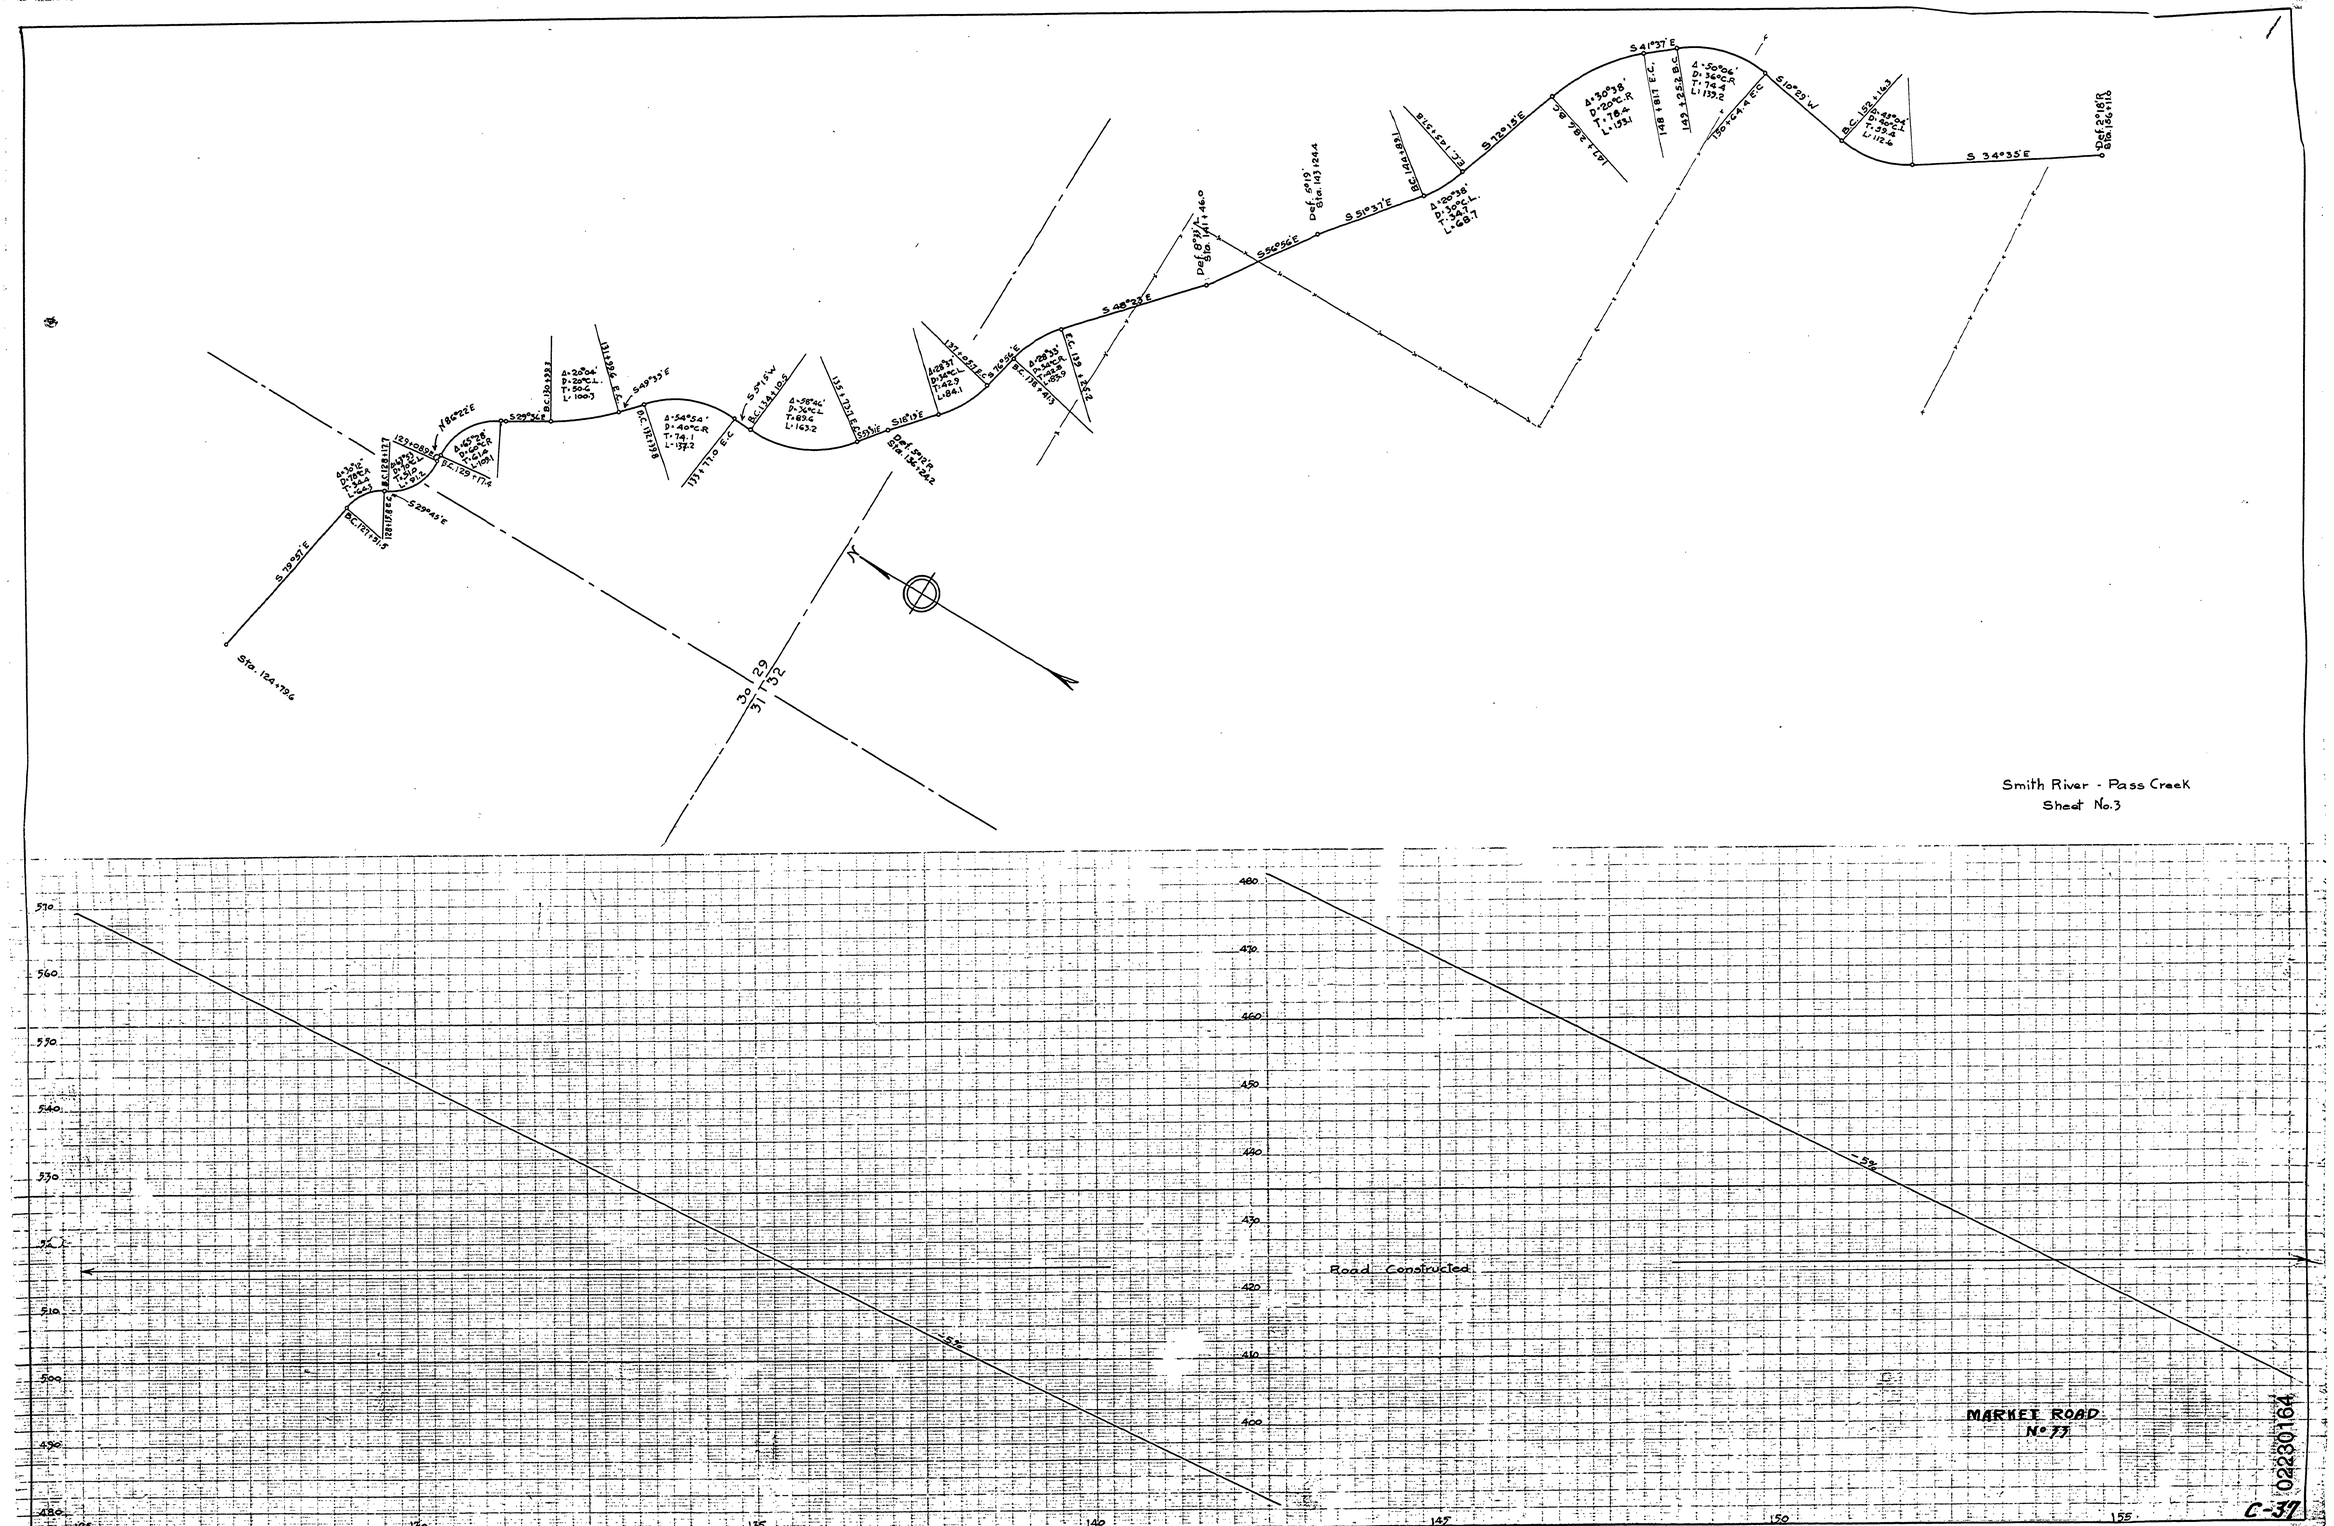
Smith River - Pass Creek
Sheet No. 3
Sta. 124+79.6
S 29°45' E
S 29°36' E
S 49°33' E
S 5°15' W
S 18°15' E
S 48°33' E
S 60°56' E
S 51°37' E
S 41°37' E
S 10°23' W
S 34°35' E
Def. 2°18' R
Sta. 136+11.8
Road Constructed
MARKET ROAD
No 77
C-37
02230164

