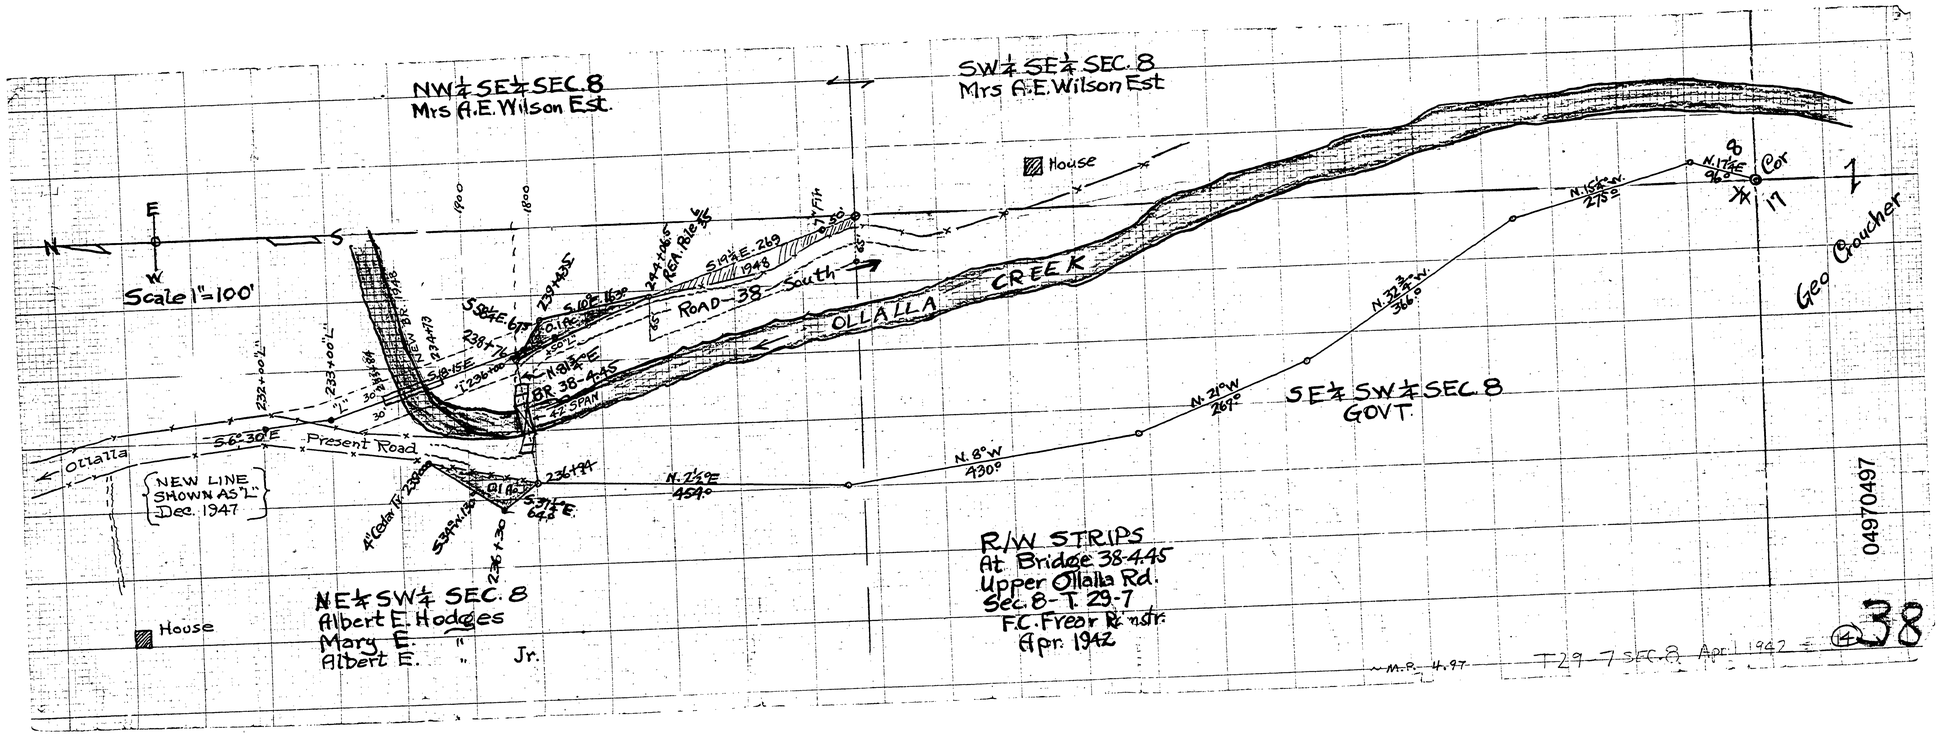
NW¼ SE¼ SEC. 8
Mrs A.E. Wilson Est.
SW¼ SE¼ SEC. 8
Mrs A.E. Wilson Est
House
Scale 1"=100'
ROAD-38 South
OLLALLA CREEK
OR 38-4.45
SE¼ SW¼ SEC. 8
GOVT.
Present Road
Ollalla
NEW LINE SHOWN AS "L" Dec. 1947
NE¼ SW¼ SEC. 8
Albert E. Hodges
Mary E. "
Albert E. " Jr.
R/W STRIPS
At Bridge 38-4.45
Upper Ollalla Rd.
Sec. 8-T. 29-7
F.C. Frear R/W str.
Apr. 1942
Geo Goucher
Cor
04970497
T29 7 SEC. 8 Apr. 1942
38