
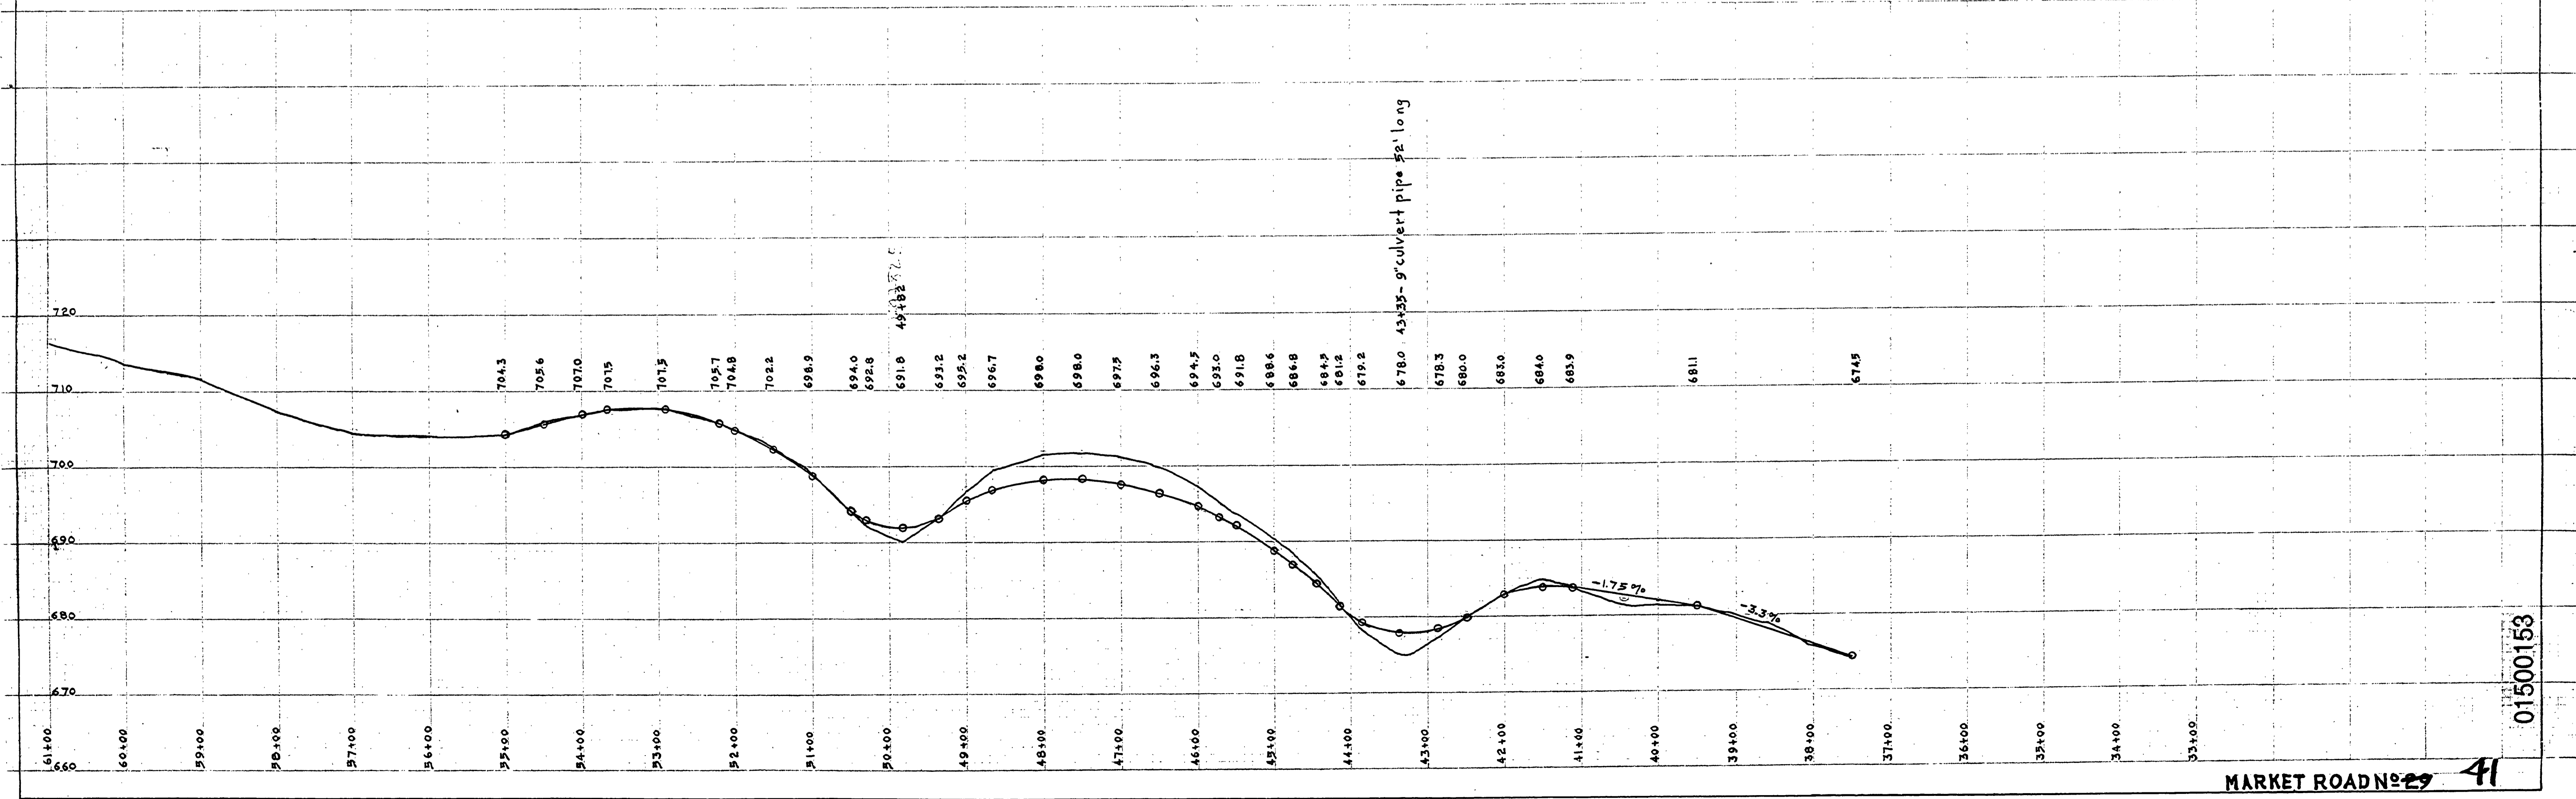


**DOUGLAS COUNTY HIGHWAY IMPROVEMENT**

**PROFILE AND ALIGNMENT  
MYRTLE CREEK RIDDLE  
WEAVER SECTION  
SEC. 1-6-12, TWP. 30S., R. 5-6 W.W.M.  
STA. 37+50 TO STA. 58+00**

OFFICE OF  
F. C. FREAR  
COUNTY ROADMASTER  
SCALE: HOR. 1"=100 FT. VER. 1"=10 FT.  
SHEET No 1

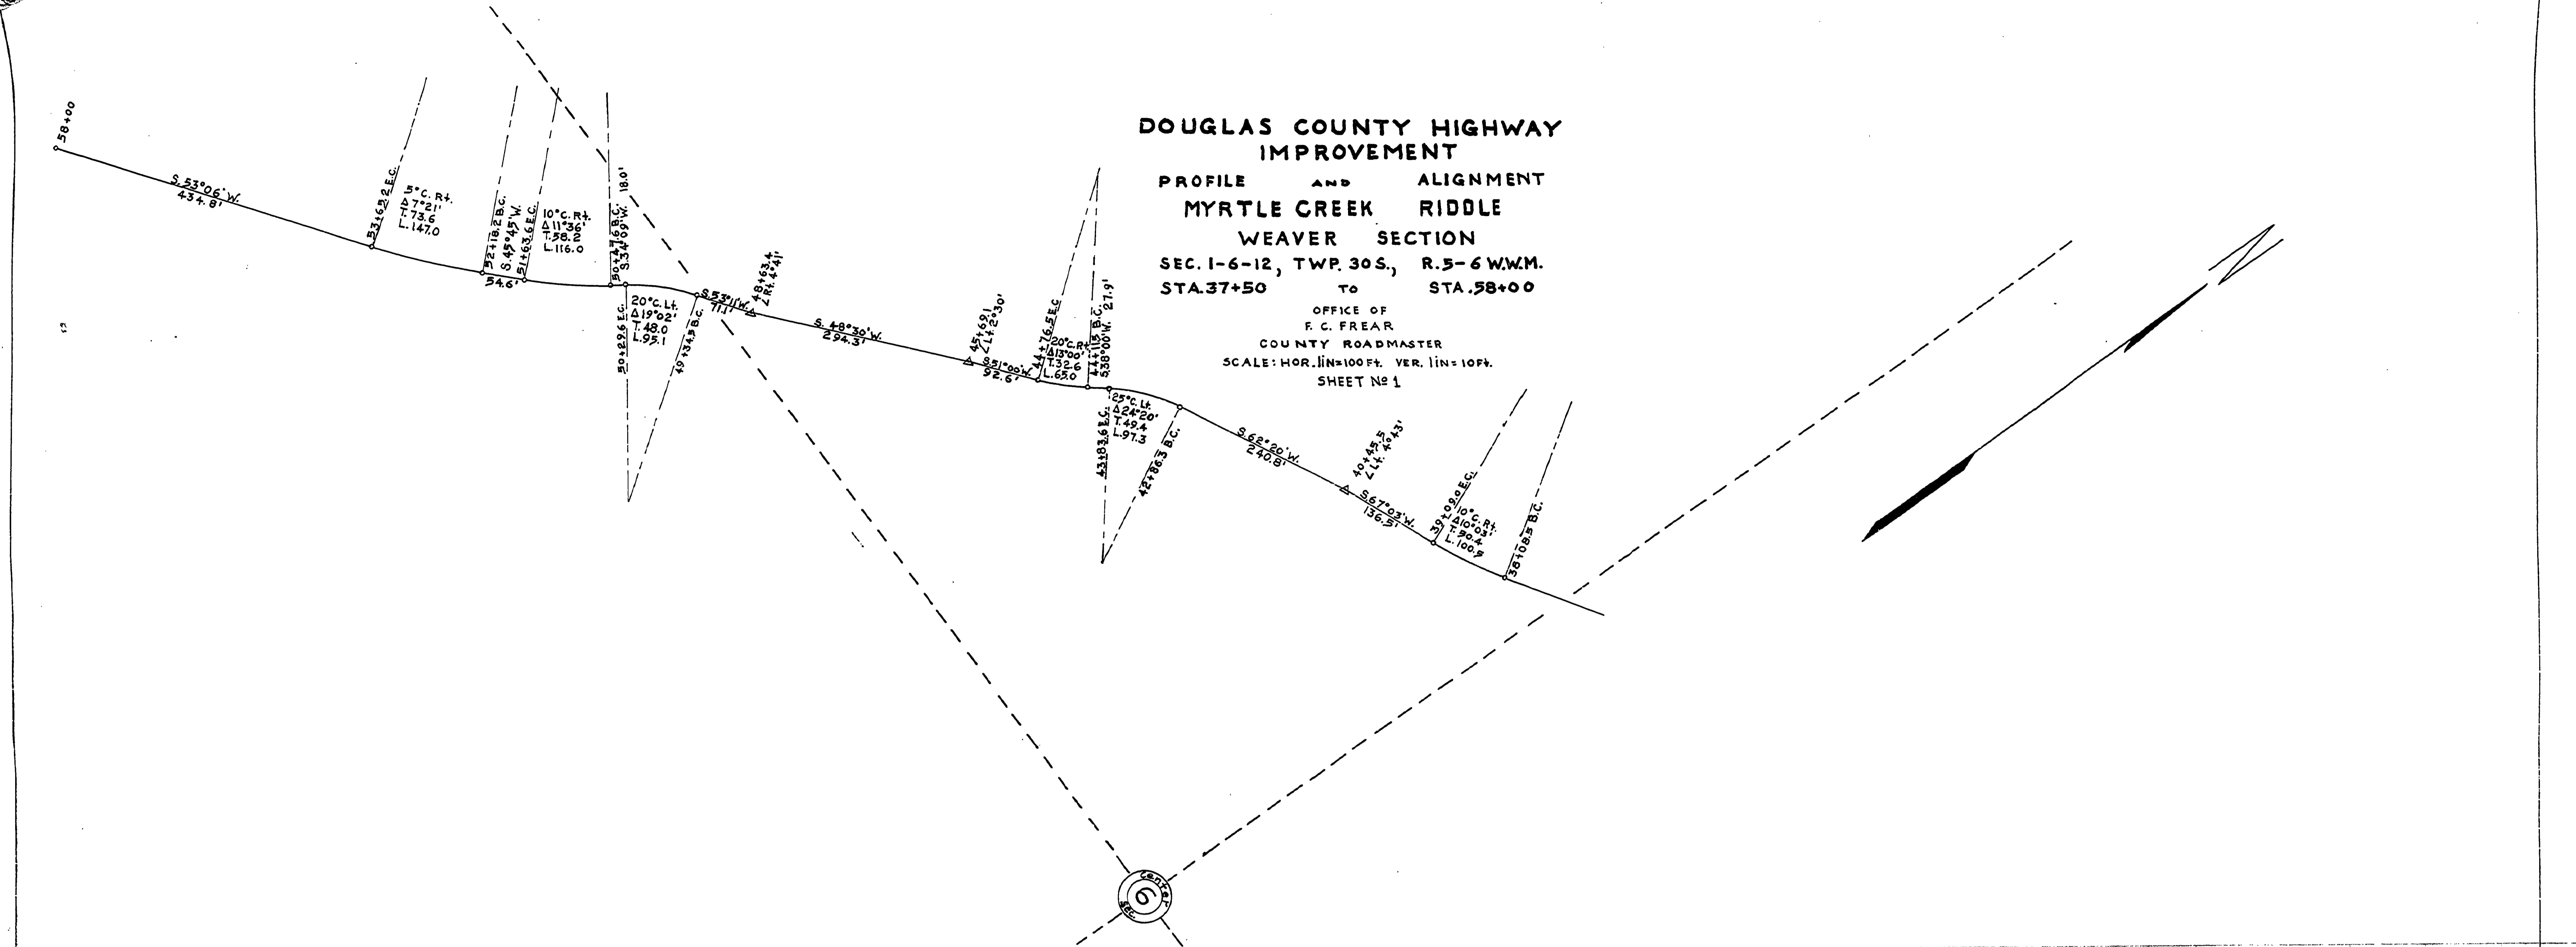

01500153

MARKET ROAD No 29 41

~ M.P. 1.50

T 30-5-6 SEC. 1-6-12