



MARKS & WOLLENBERG

ED. WEAVER

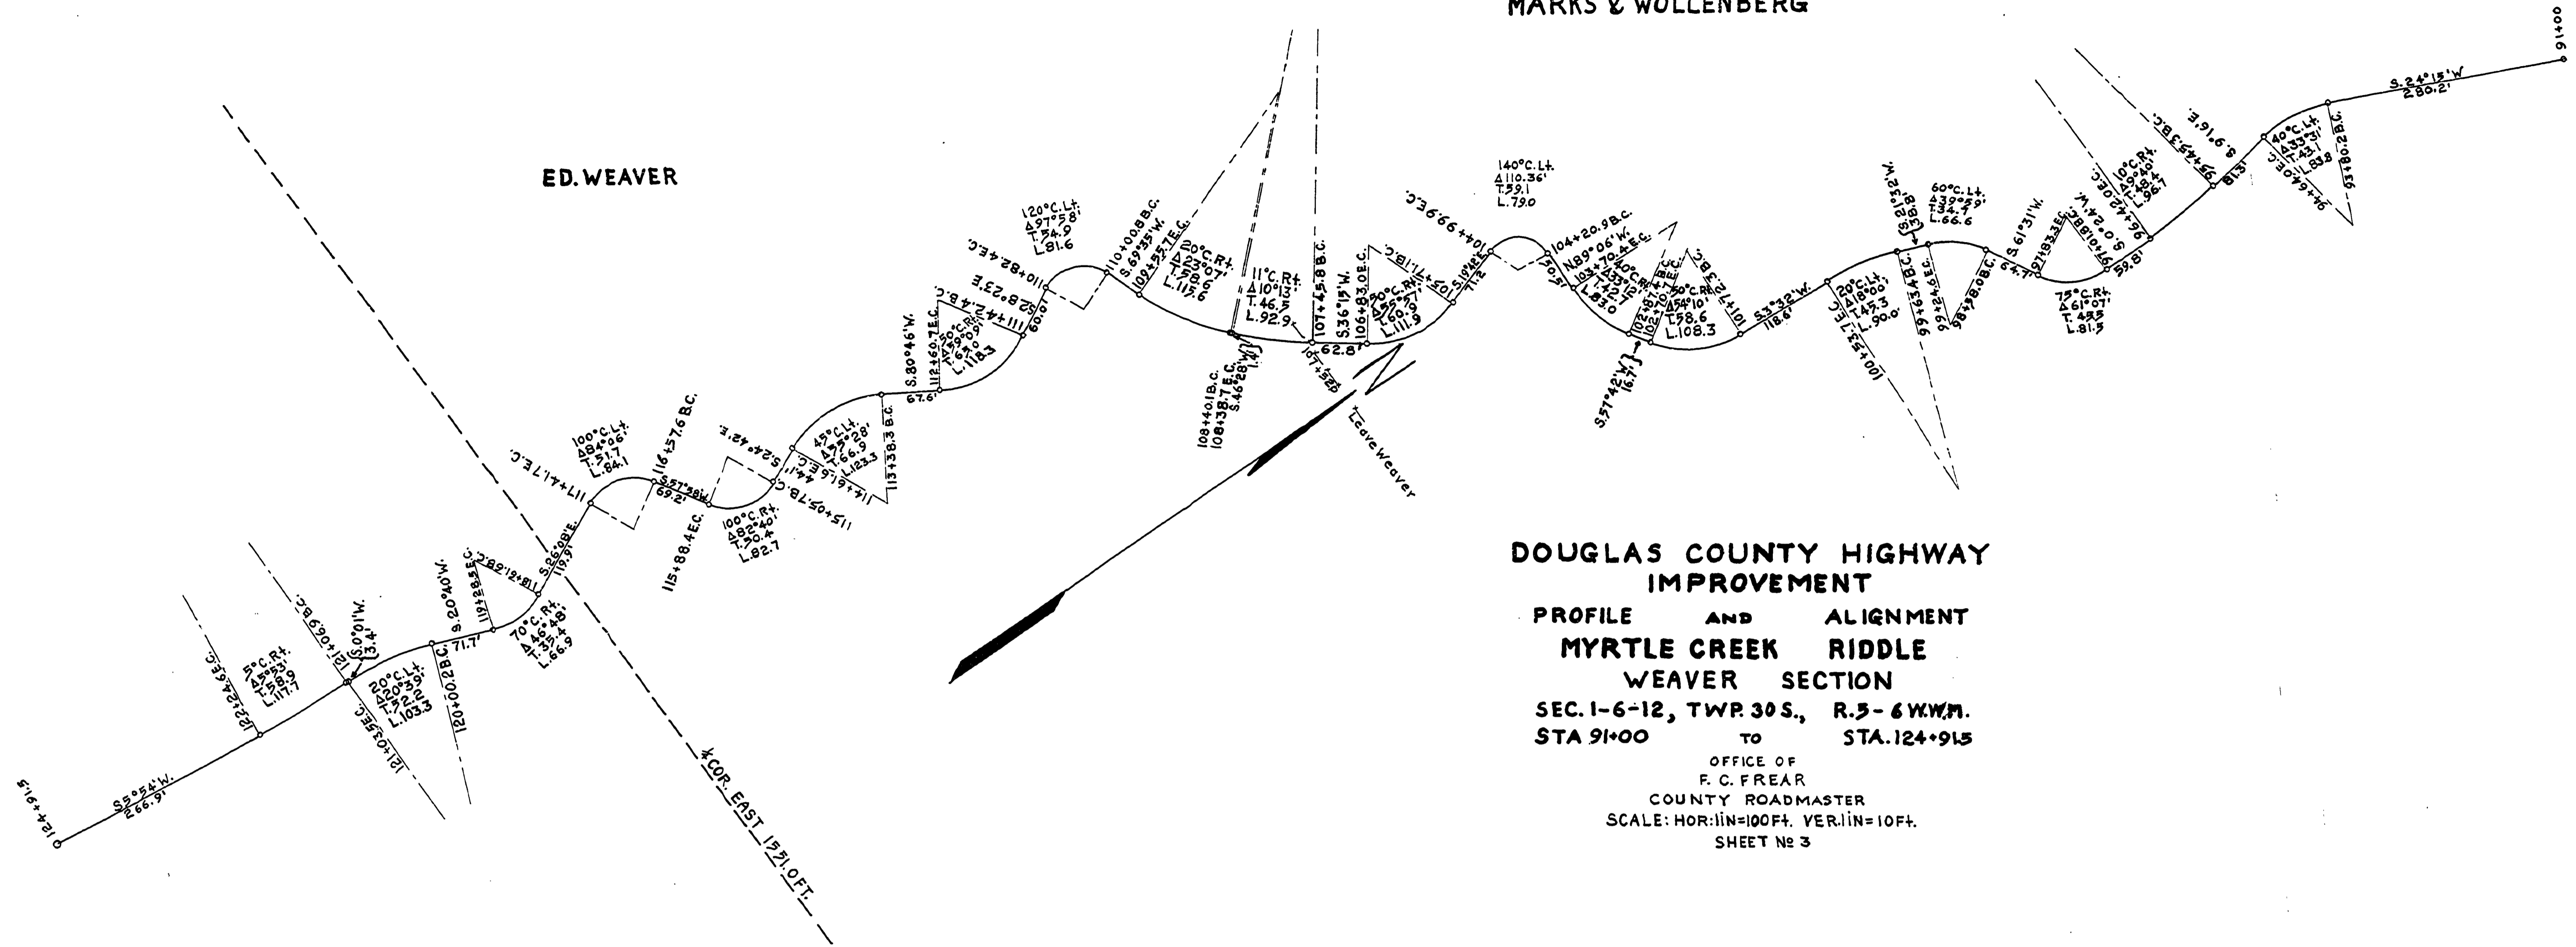

**DOUGLAS COUNTY HIGHWAY IMPROVEMENT**  
**PROFILE AND ALIGNMENT**  
**MYRTLE CREEK RIDDLE**  
**WEAVER SECTION**  
 SEC. 1-6-12, TWP. 30 S., R. 5-6 W.W.M.  
 TO STA. 124+91.5  
 OFFICE OF  
 F. C. FREAR  
 COUNTY ROADMASTER  
 SCALE: HOR: 1"=100 FT. VER: 1"=10 FT.  
 SHEET No 3

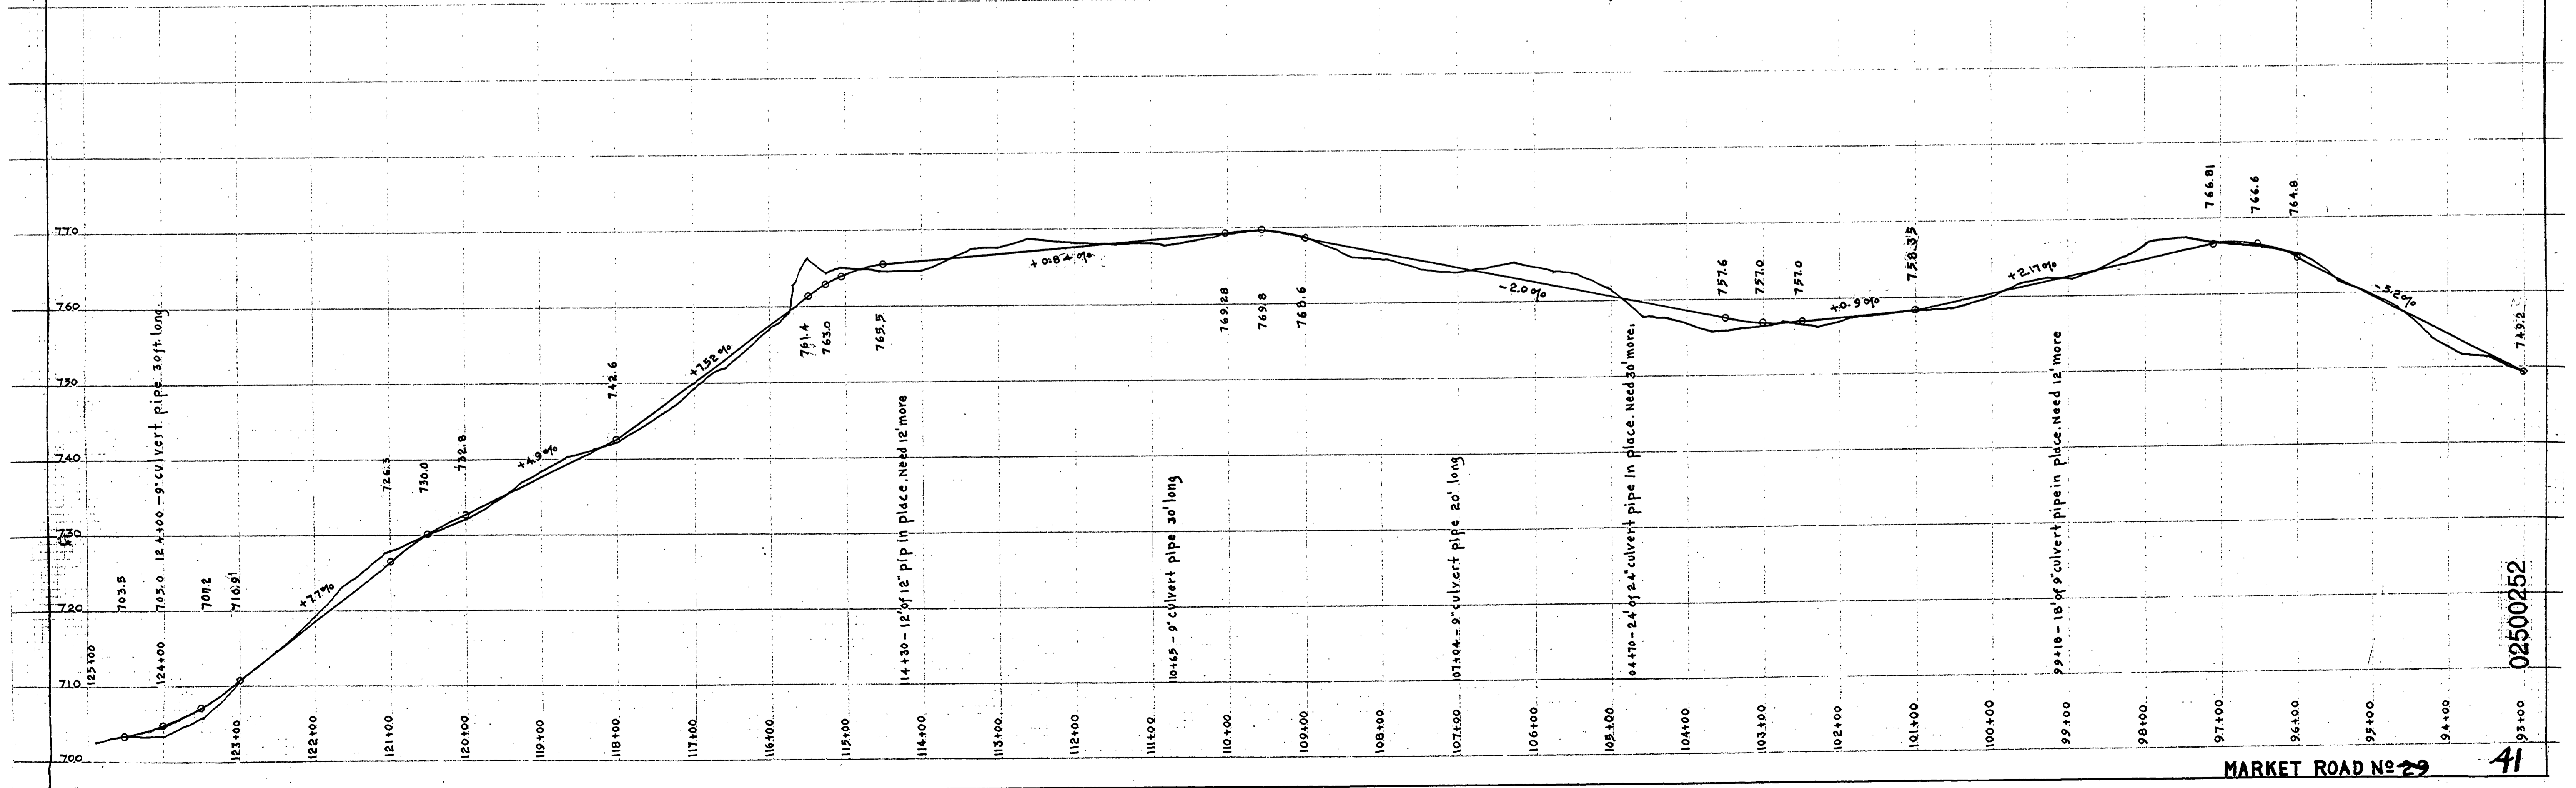

MARKET ROAD No 29 41

02500252