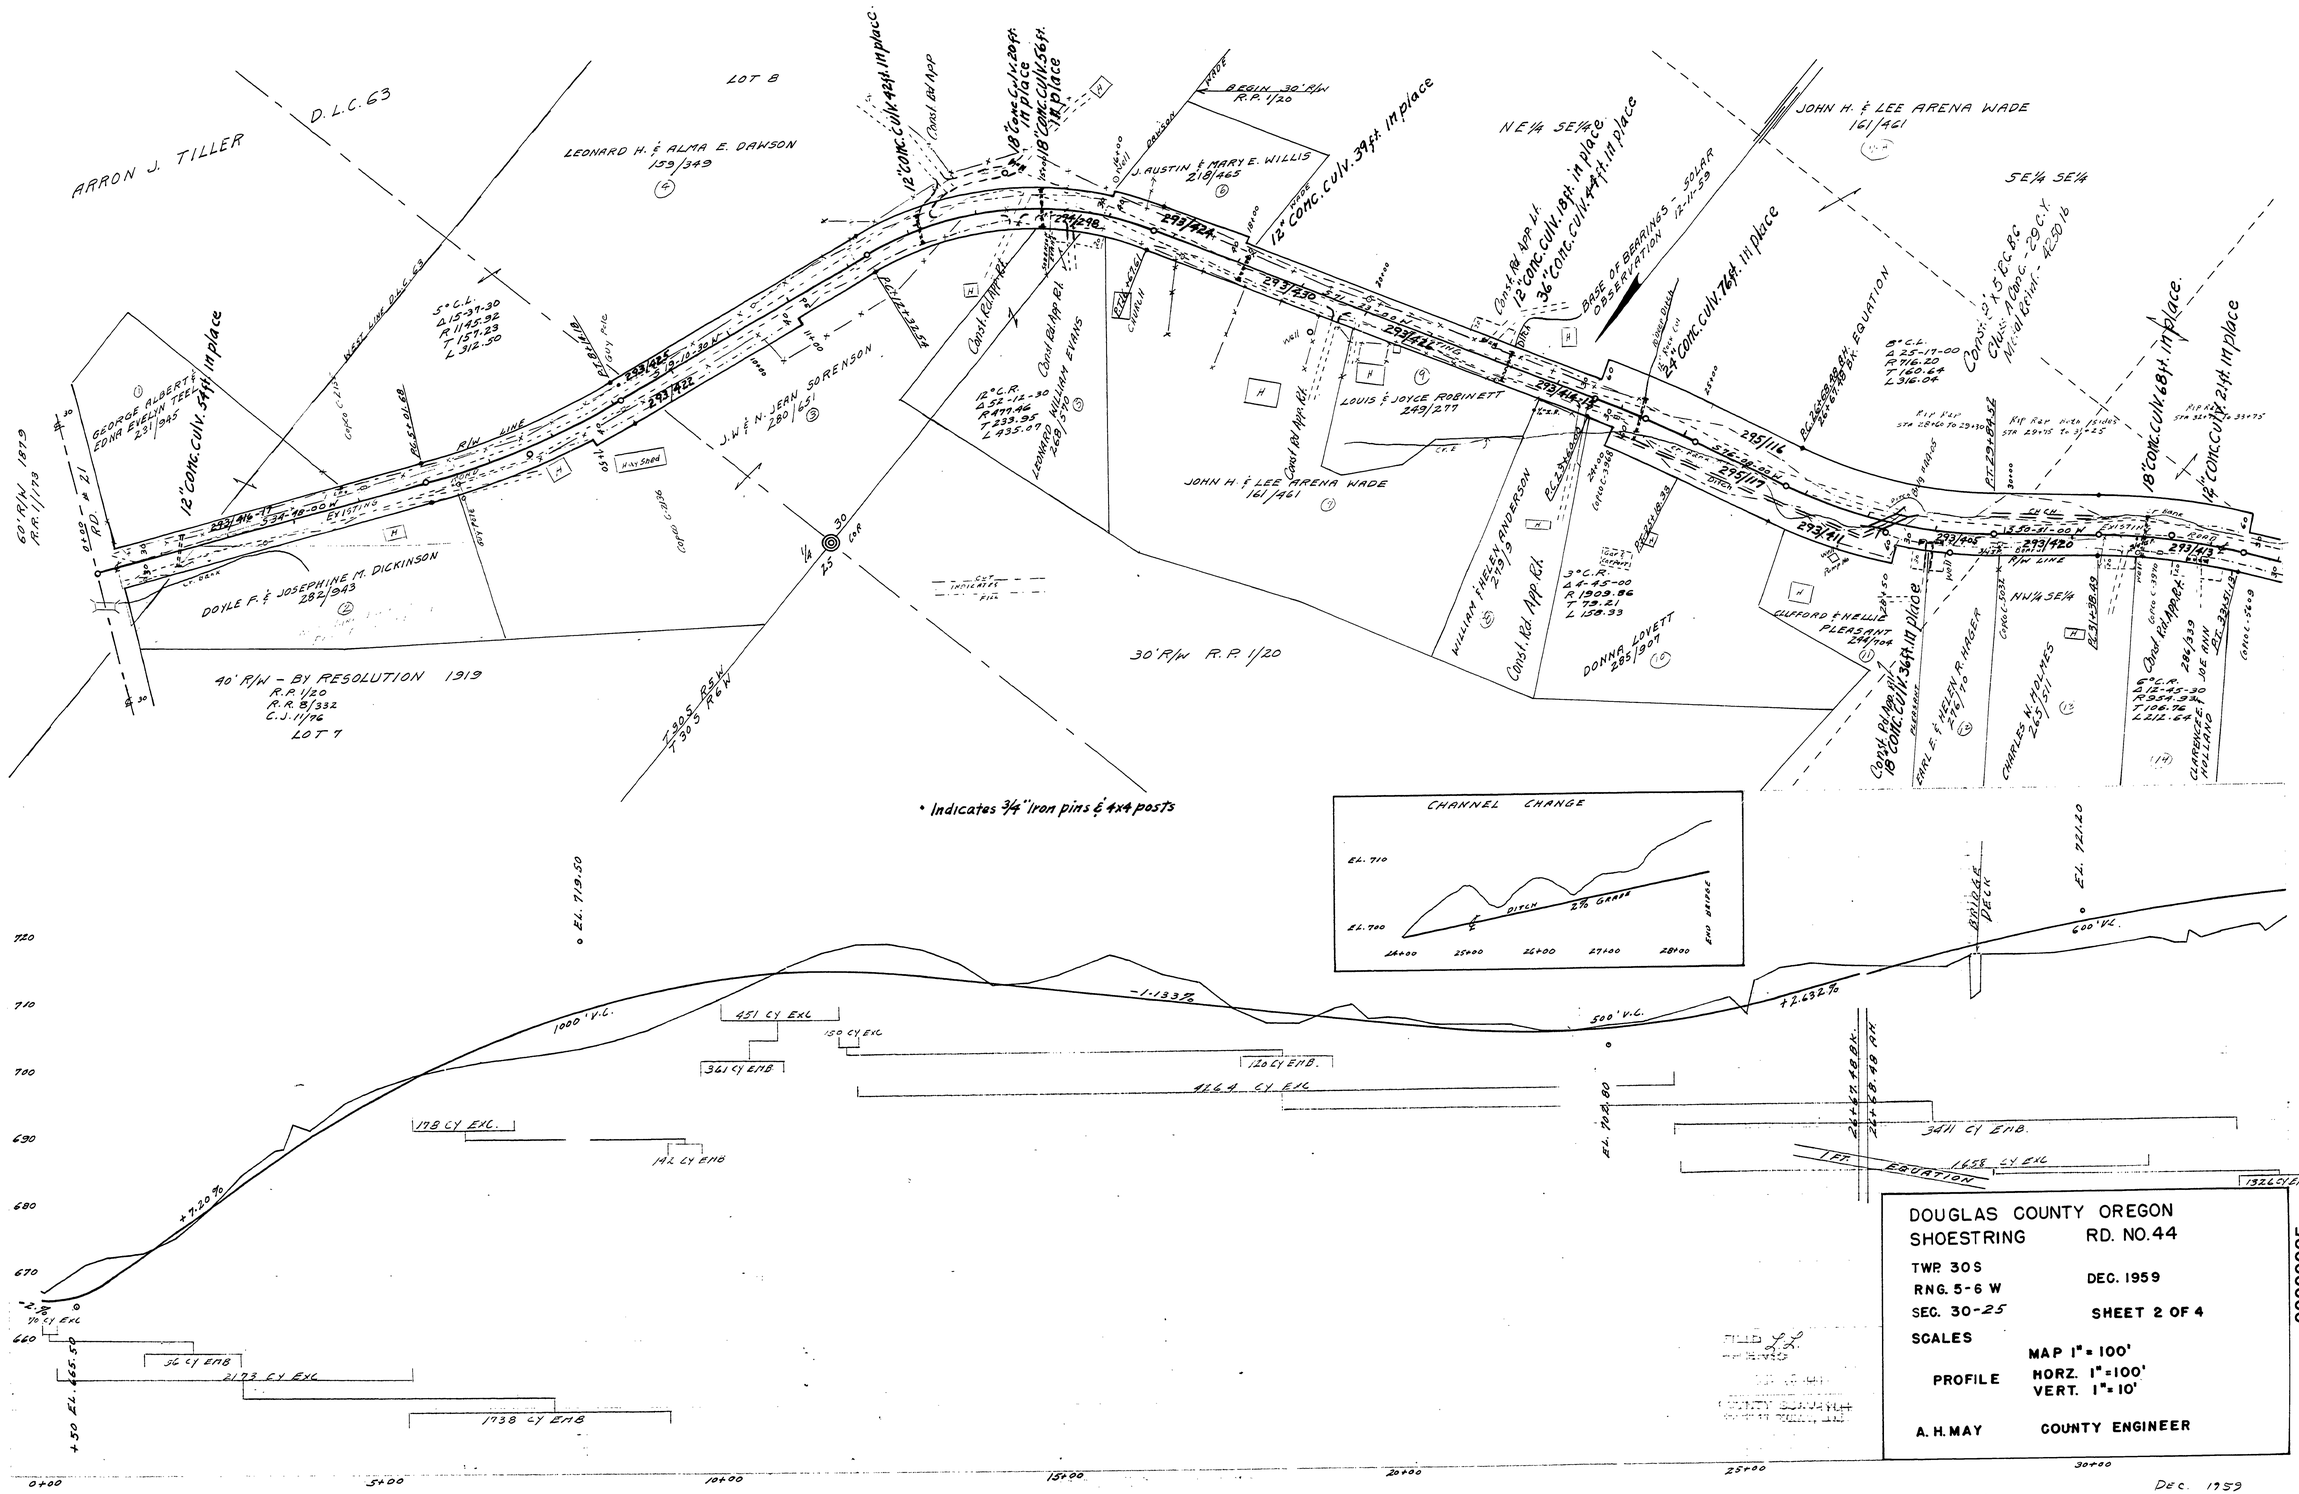
ARRON J. TILLER
D.L.C. 63
LOT 8
LEONARD H. & ALMA E. DAWSON
159/349
GEORGE ALBERT & EDNA EVELYN TEEL
231/945
DOYLE F. & JOSEPHINE M. DICKINSON
282/943
J.W. & N. JEAN SORENSON
280/651
268/570
J. AUSTIN & MARY E. WILLIS
218/465
LOUIS & JOYCE ROBINETT
249/277
JOHN H. & LEE ARENA WADE
161/461
WILLIAM T. & HELEN ANDERSON
219/9
DONNA LOVETT
285/907
CLIFFORD & NELLIE PLEASANT
244/704
EARL E. & HELEN R. HAGER
276/70
CHARLES N. & OLIVE S. HOLMES
265/311
CLARENCE & JOE ANN HOLLAND
286/339
NE¼ SE¼
SE¼ SE¼
NW¼ SE¼
30' R/W R.P. 1/20
40' R/W - BY RESOLUTION 1919
R.P. 1/20
R.R. 8/332
C.J. 11/96
LOT 7
60' R/W 1879
R.R. 1/173
BEGIN 30' R/W R.P. 1/20
12" CONC. CULV. 44 ft. in place
18" CONC. CULV. 20 ft. in place
18" CONC. CULV. 56 ft. in place
12" CONC. CULV. 39 ft. in place
12" CONC. CULV. 34 ft. in place
12" CONC. CULV. 18 ft. in place
36" CONC. CULV. 44 ft. in place
24" CONC. CULV. 76 ft. in place
18" CONC. CULV. 68 ft. in place
14" CONC. CULV. 24 ft. in place
18" CONC. CULV. 36 ft. in place
BASE OF BEARINGS - SOLAR OBSERVATION 12-11-59
EQUATION
• Indicates 3/4" iron pins & 4x4 posts
CHANNEL CHANGE
EL. 710
EL. 700
DITCH
2% GRADE
END BRIDGE
BRIDGE DECK
EL. 719.50
EL. 721.20
1000' V.C.
500' V.C.
600' V.C.
-1.133%
+2.632%
+7.20%
-2.2%
+50 EL. 665.50
451 CY EXC
150 CY EXC
361 CY EMB
120 CY EMB.
4264 CY EXC
178 CY EXC.
142 CY EMB
3411 CY EMB.
1658 CY EXC
1326 CY EMB
76 CY EXC
36 CY EMB
2173 CY EXC
1938 CY EMB
24+67.48 BK.
24+68.48 AH.
0+00
5+00
10+00
15+00
20+00
25+00
30+00
DOUGLAS COUNTY OREGON
SHOESTRING RD. NO. 44
TWP. 30 S
RNG. 5-6 W
SEC. 30-25
DEC. 1959
SHEET 2 OF 4
SCALES
MAP 1" = 100'
PROFILE HORZ. 1" = 100'
VERT. 1" = 10'
A. H. MAY COUNTY ENGINEER
00000065
M.P. 0.00 - 0.65
Co. Rd. #44
Dec. 1959
Sht 2 of 4
49