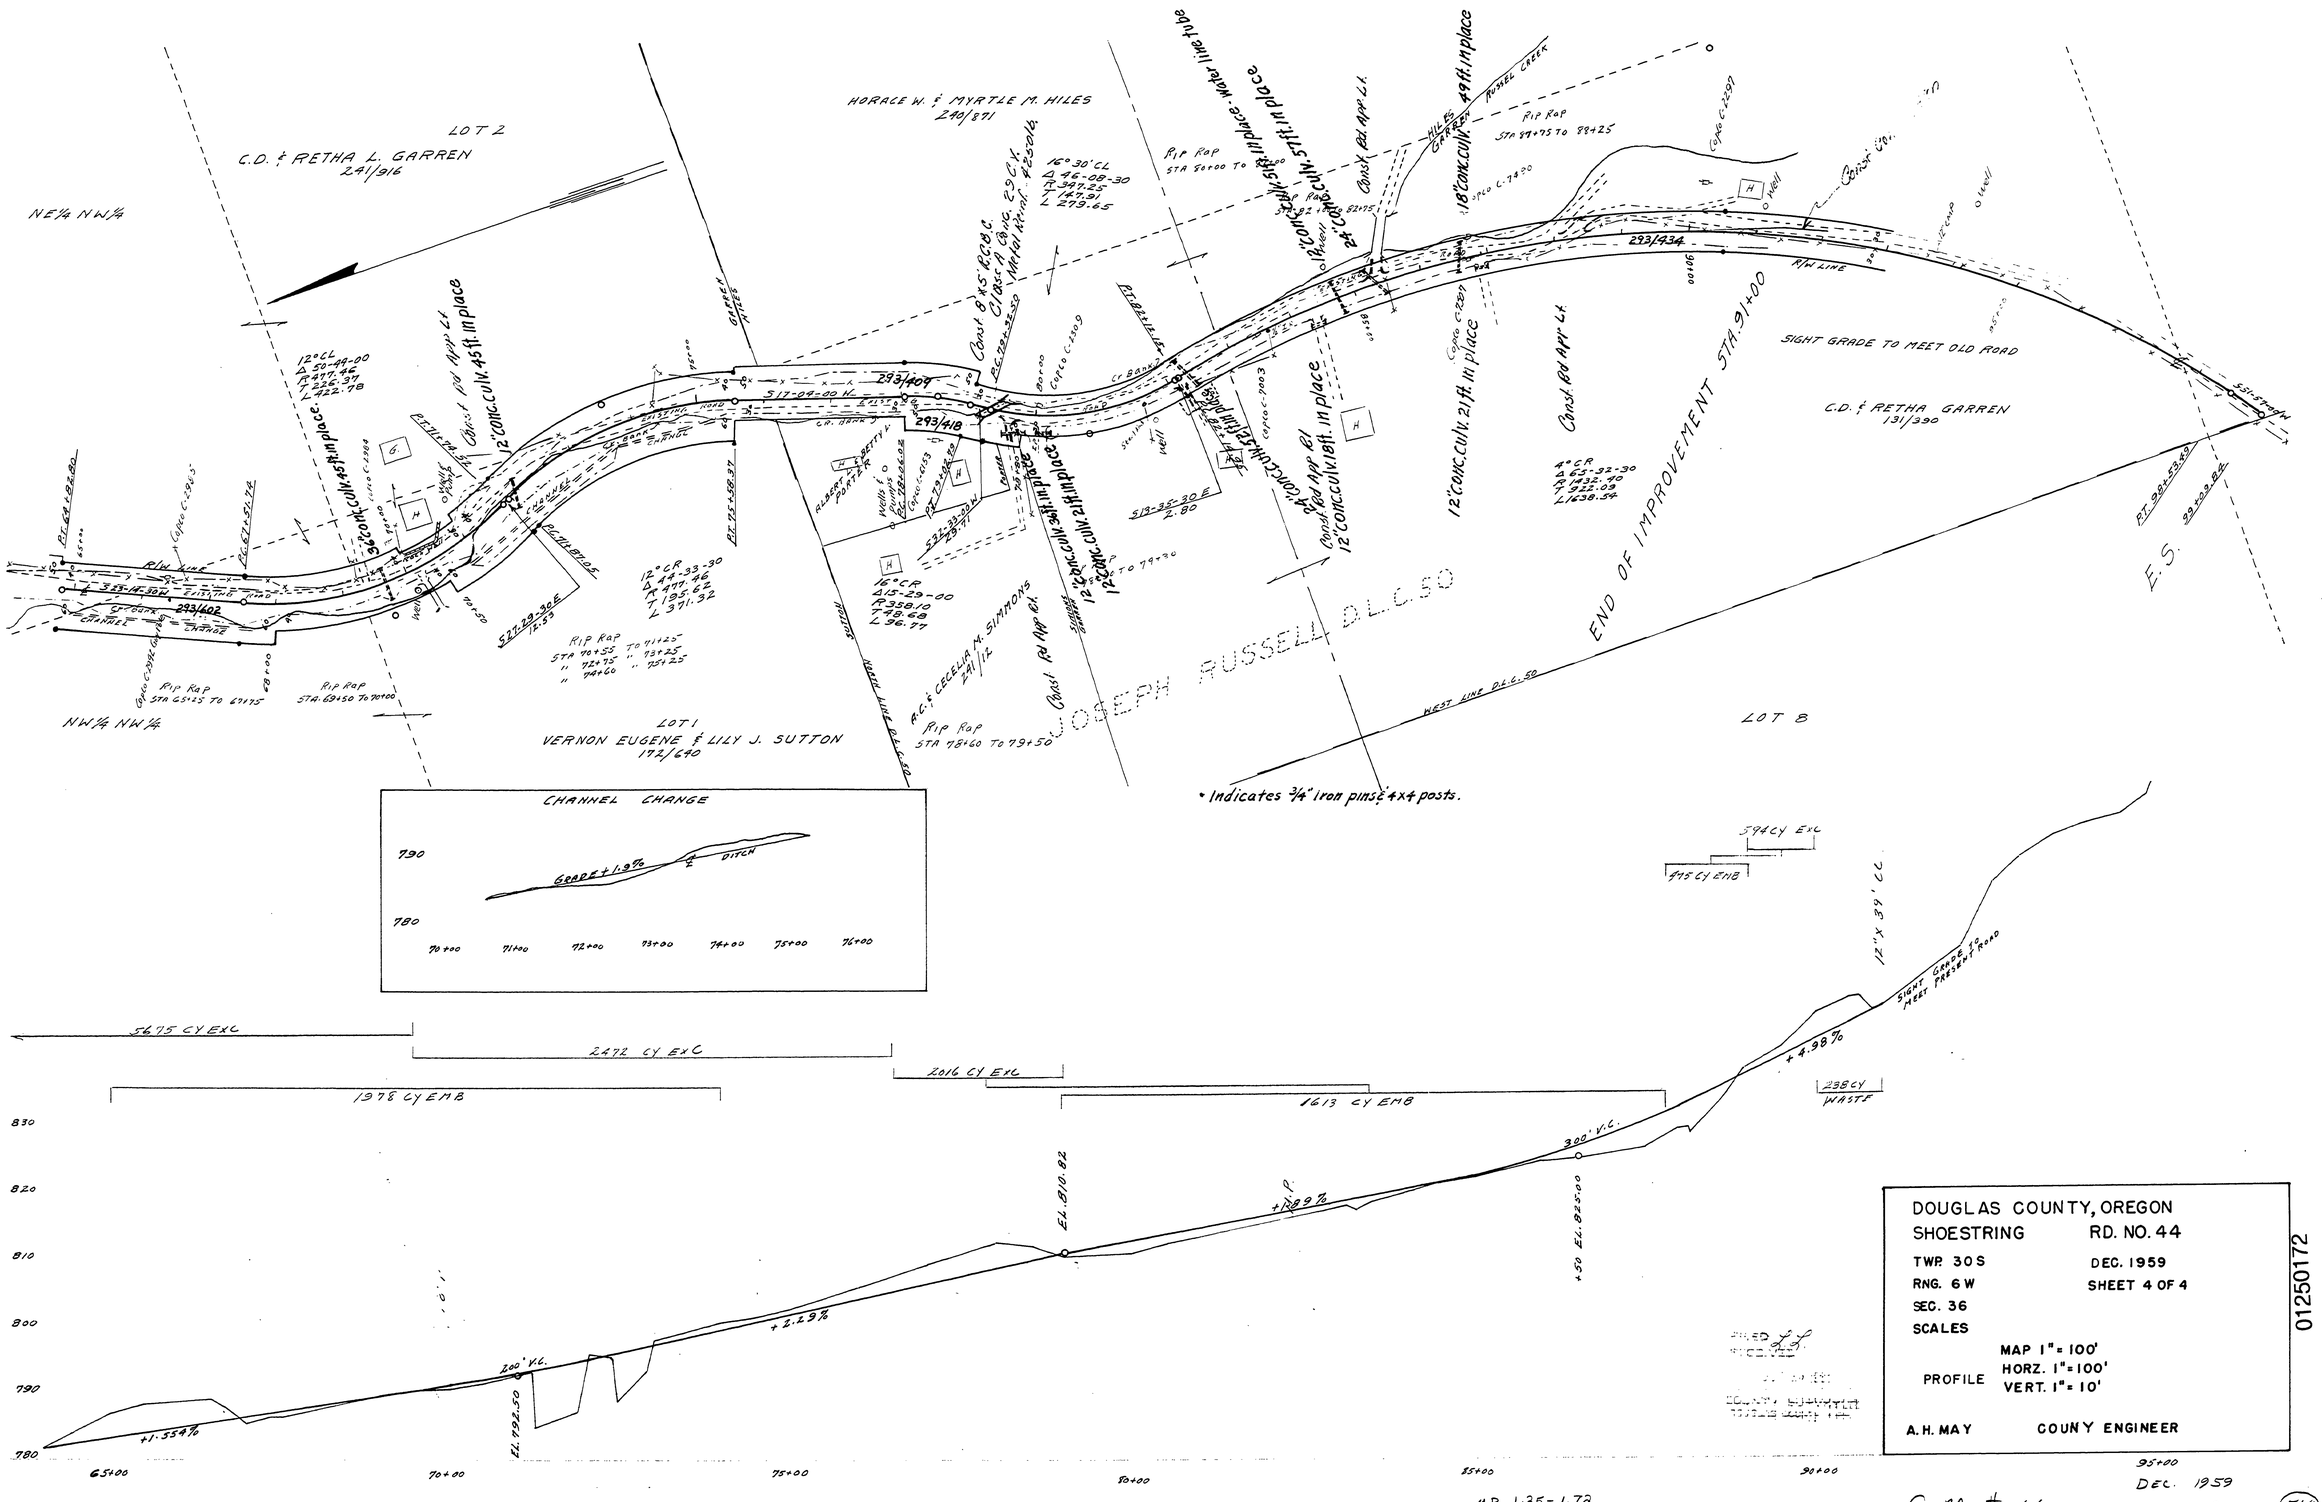

• Indicates ¾" iron pipe 4x4 posts.

DOUGLAS COUNTY, OREGON
SHOESTRING RD. NO. 44
TWP. 30 S
RNG. 6 W
SEC. 36
DEC. 1959
SHEET 4 OF 4
SCALES
PROFILE MAP 1" = 100'
HORZ. 1" = 100'
VERT. 1" = 10'
A.H. MAY COUNTY ENGINEER

01250172

Co. Rd. # 44 DEC. 1959 Sht. 4 of 4 (51)