SEC 27, 28 T 30S R2W W.M.

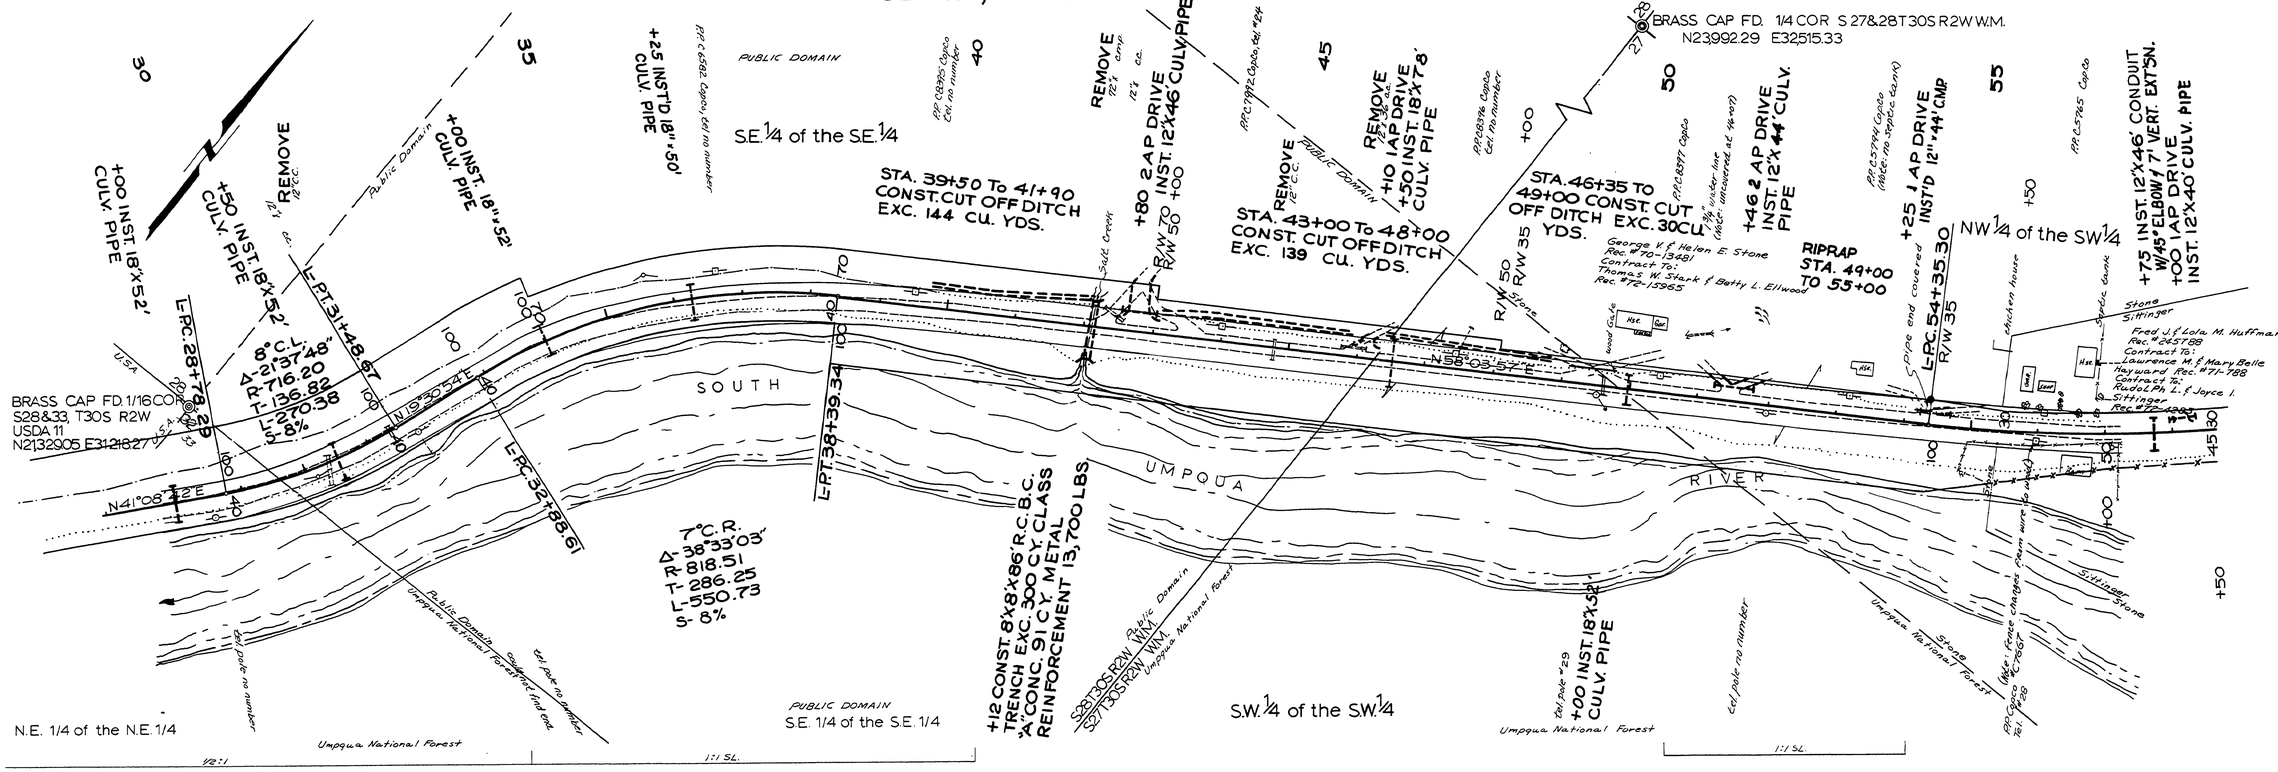

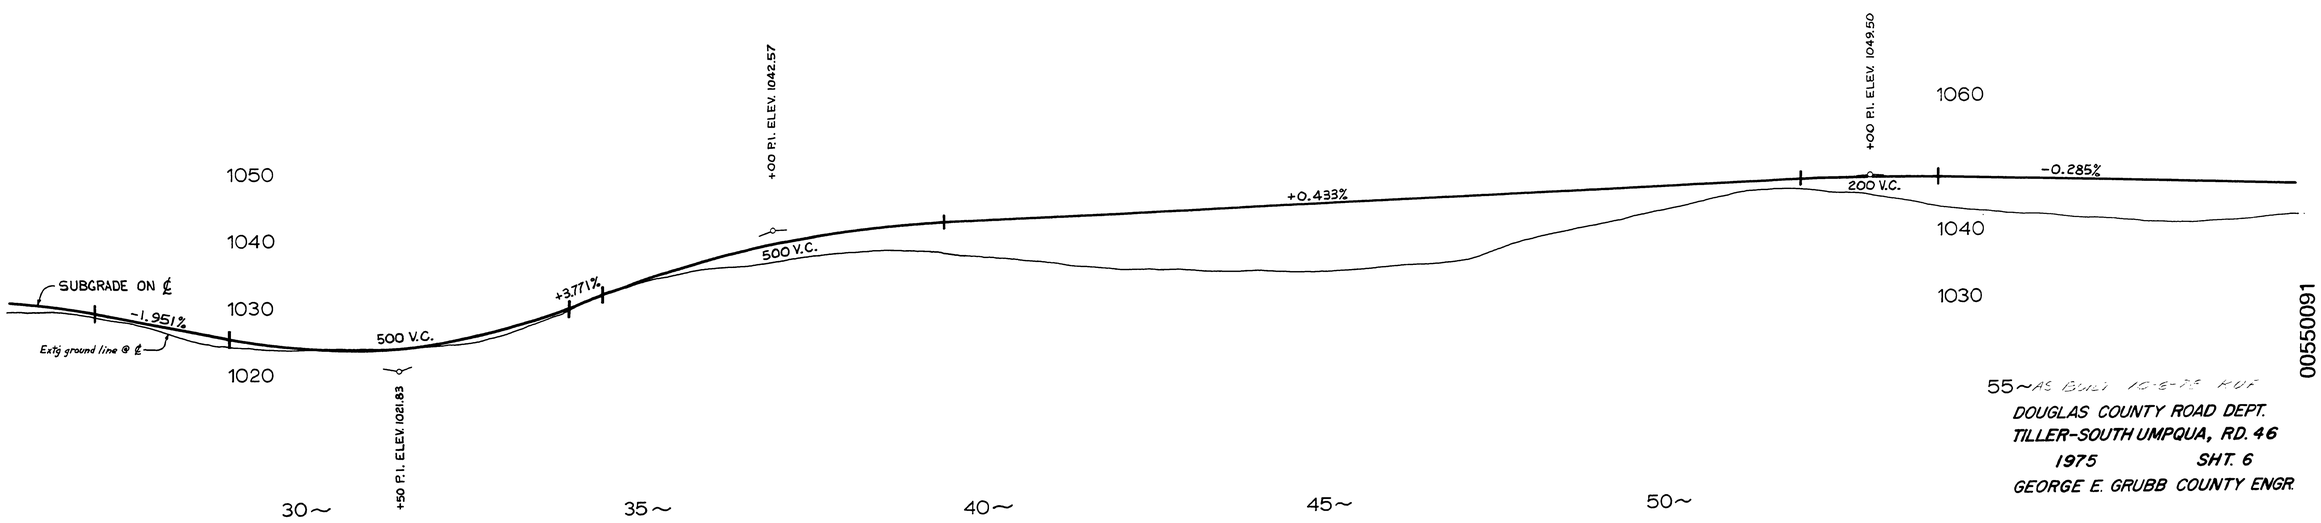

00550091