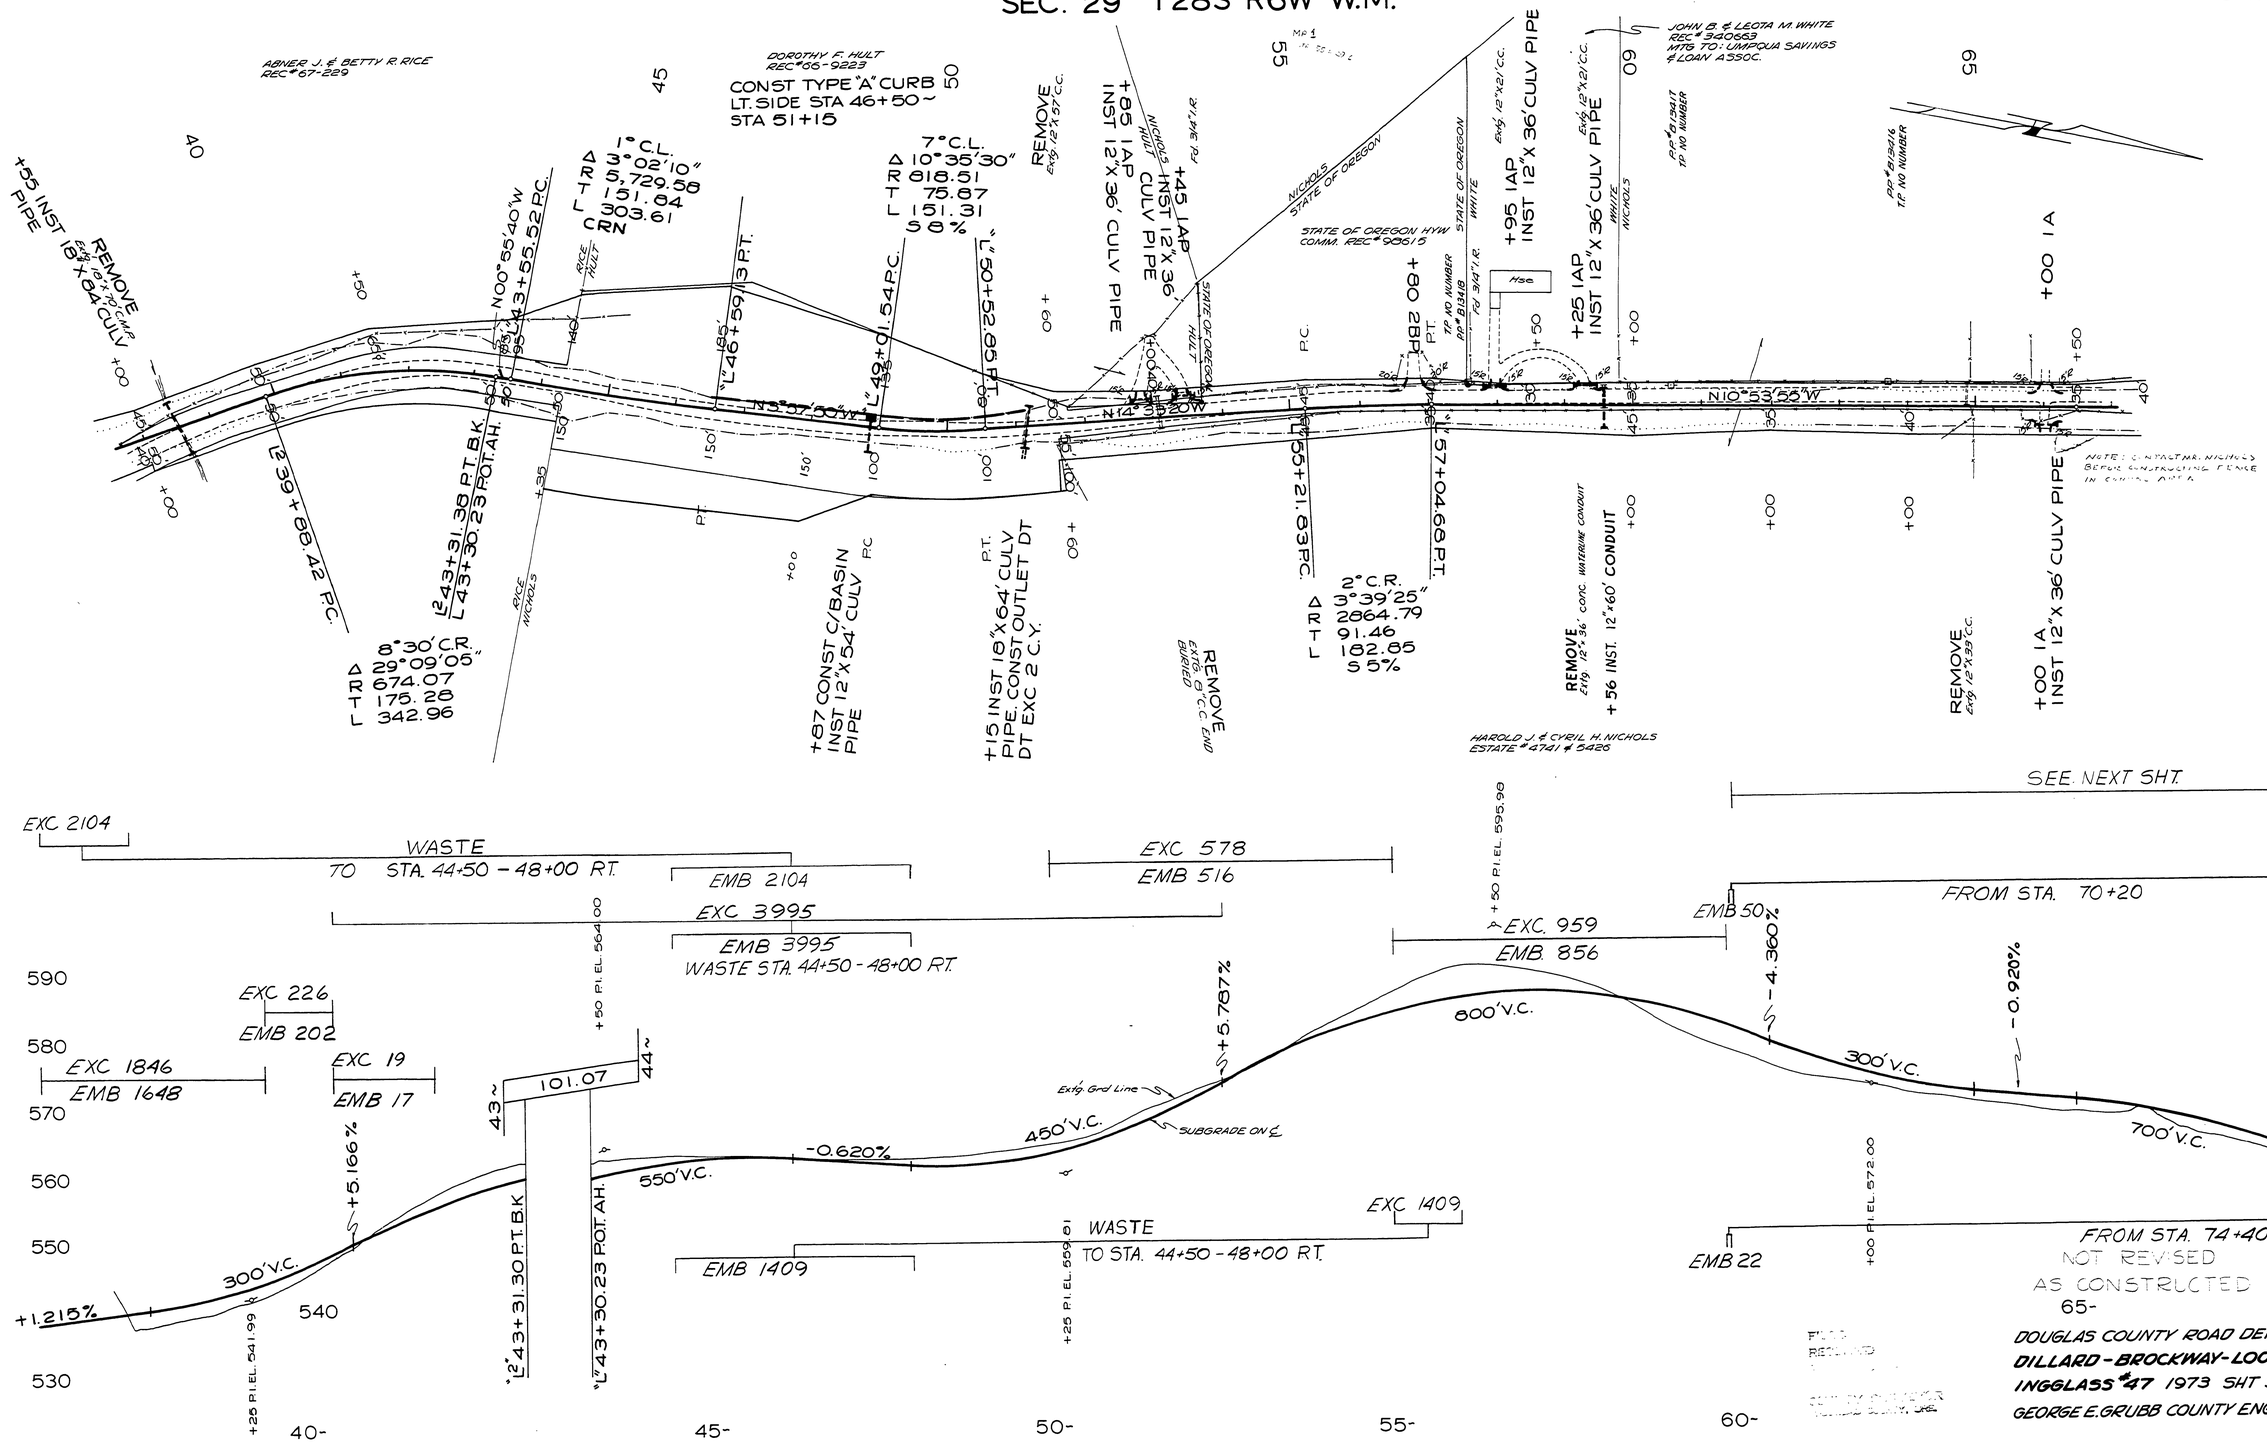SEC. 29 T28S R6W W.M.