DOUGLAS COUNTY, OREGON.

LOWER SMITH RIVER - C.48

Sec. 2, T. 21 S., R. 11 W.

F. C. FREAR, ROADMASTER

1931

SHEET 21

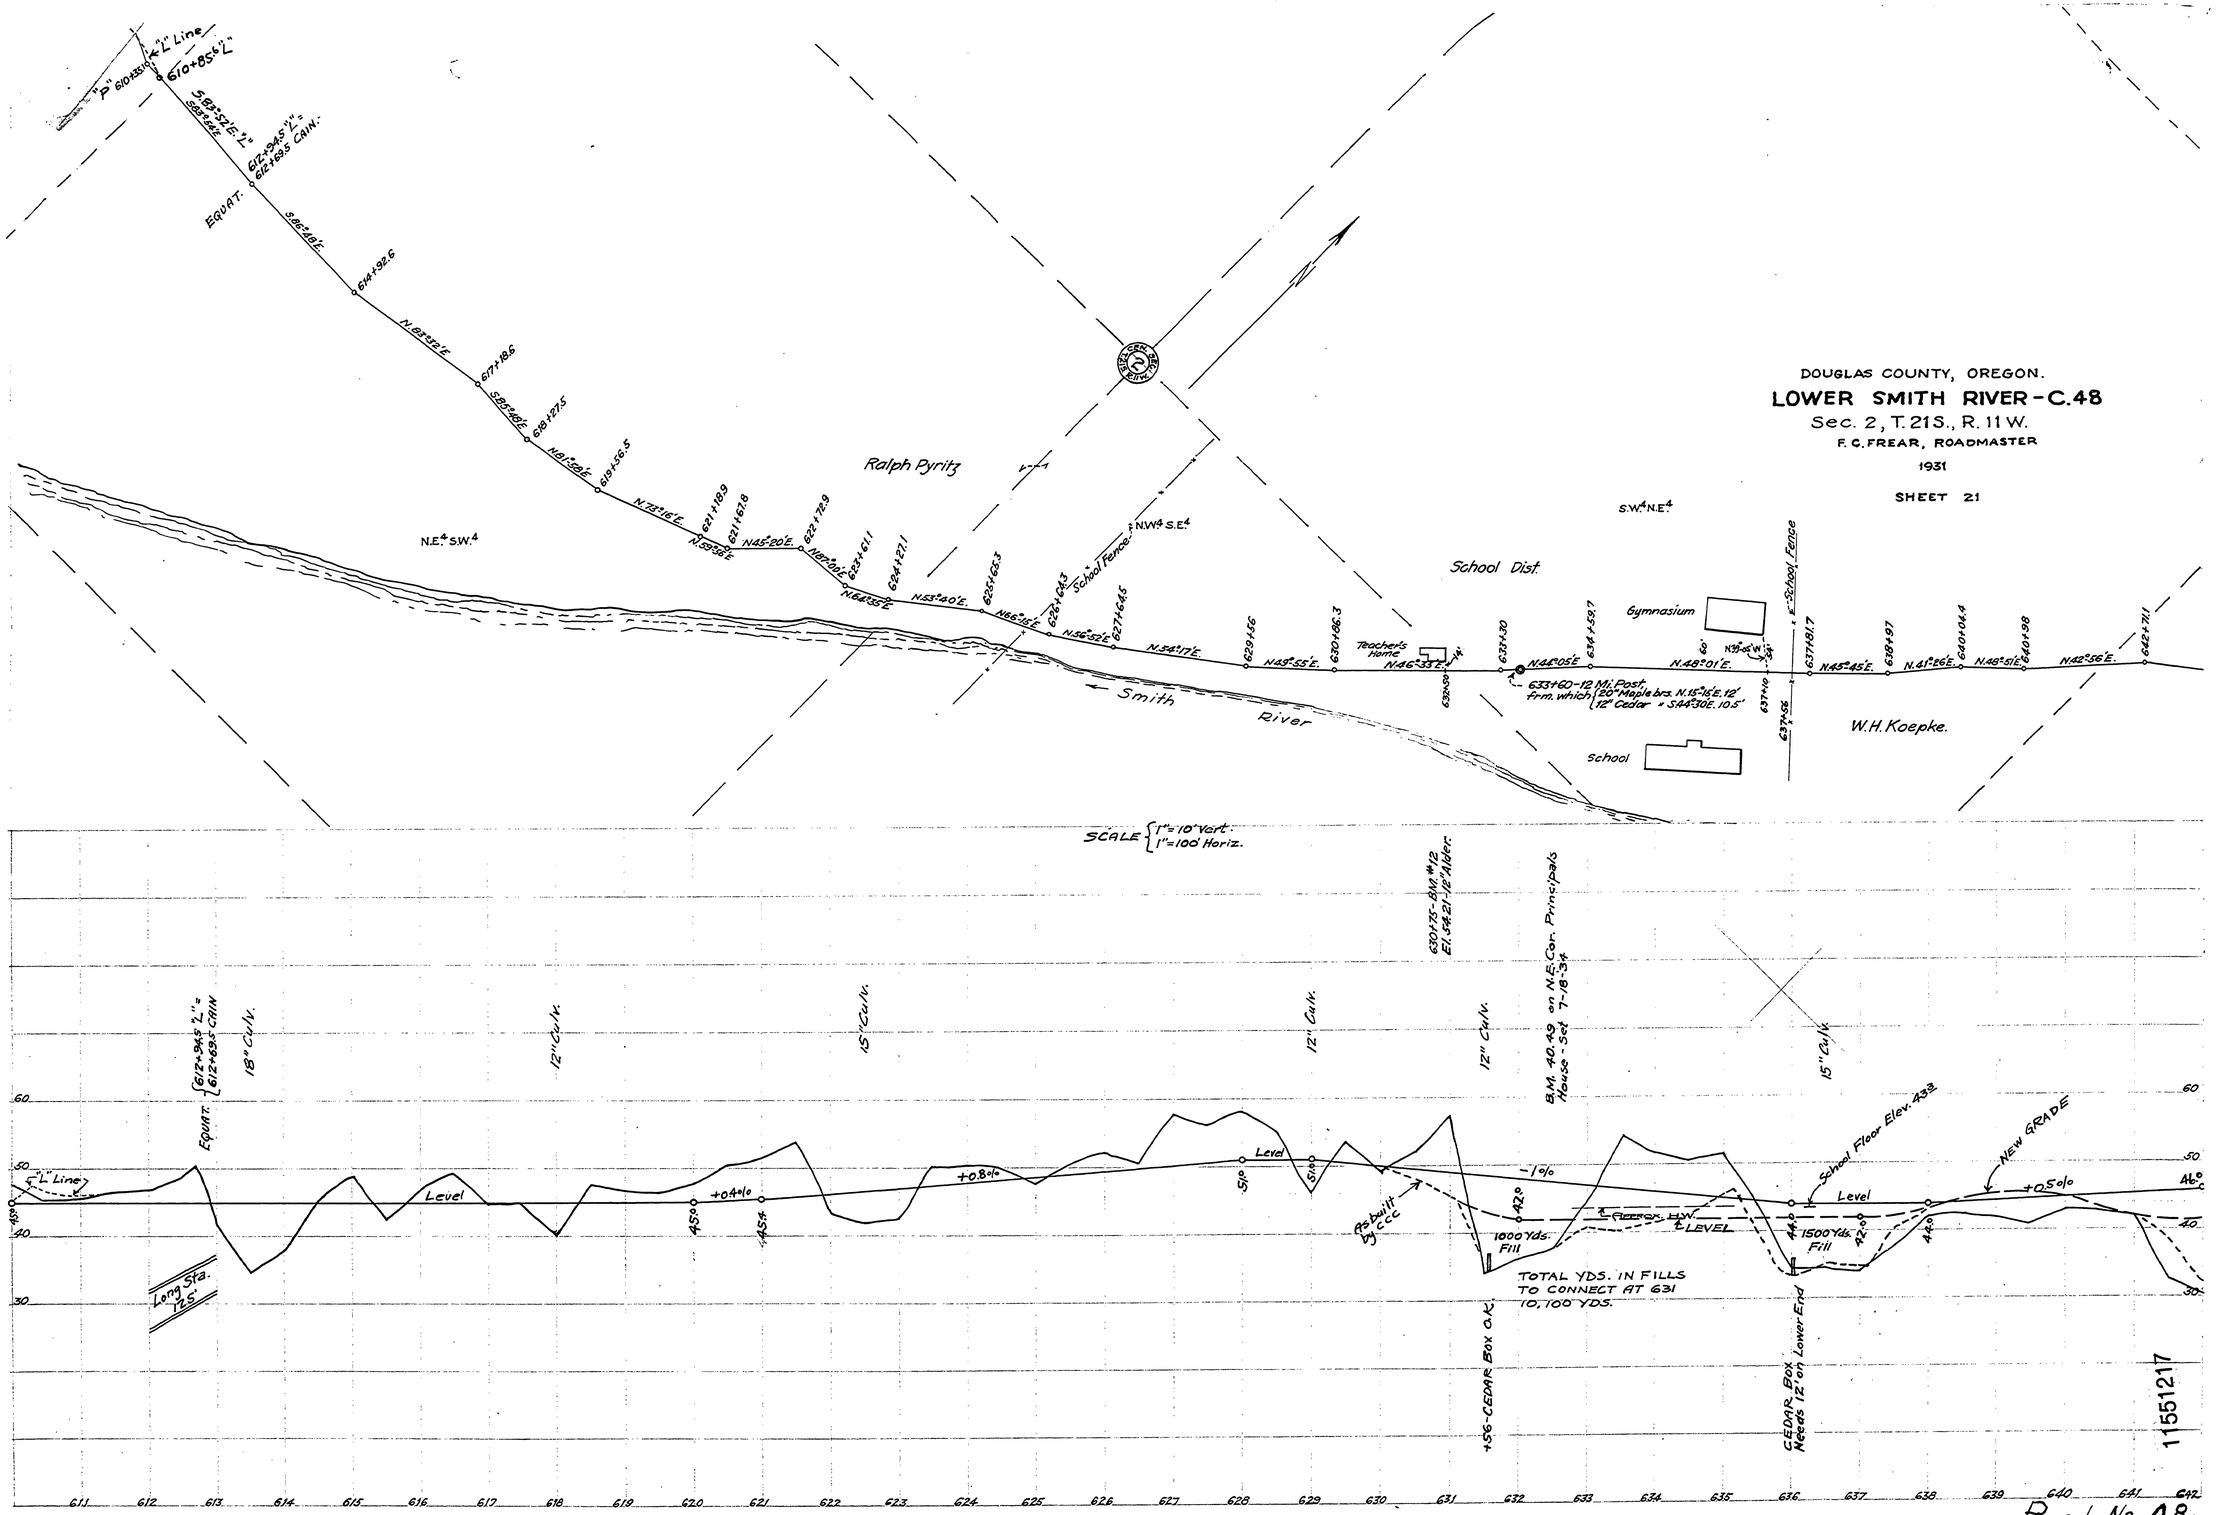

SCALE { 1" = 10' Vert.
1" = 100' Horiz.

11551217

Road No 48

N.M.P. 11.55 - 12.17

~~T21 H S.2 1931 SHT. 21 OF 27~~

86