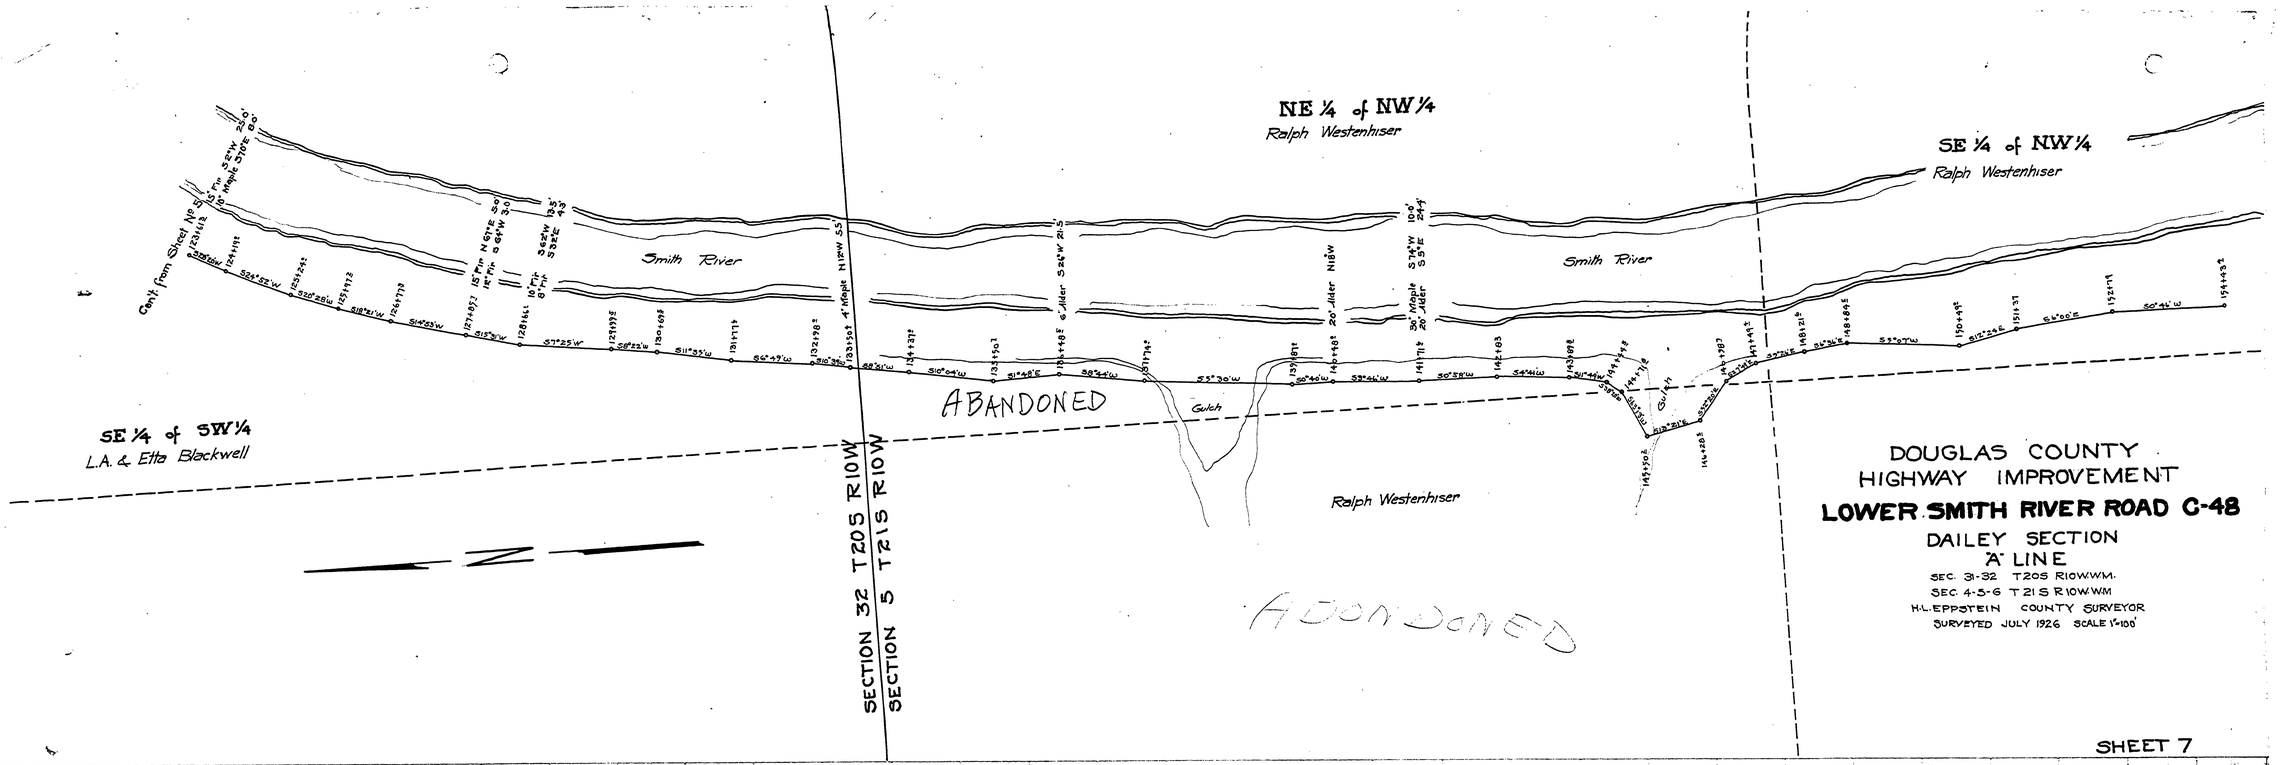

17001703

C-48

T20-10 SEC. 32
T21-10 SEC. 5 July 1926 (59)
SHT 7 OF 10

~M.P. 17.0